


BEARINGS ARE BASED ON THE BEARING OF THE SOUTH LINE OF THE DAVIS PARCEL AS SHOWN.

NE. Cor. Lot 10 NW. Cor. Lot 11

ORVAL B. DAVIS ET UX.
VOL. 257, PAGE 766
DEED RECORDS
W.M.

R.G.W.

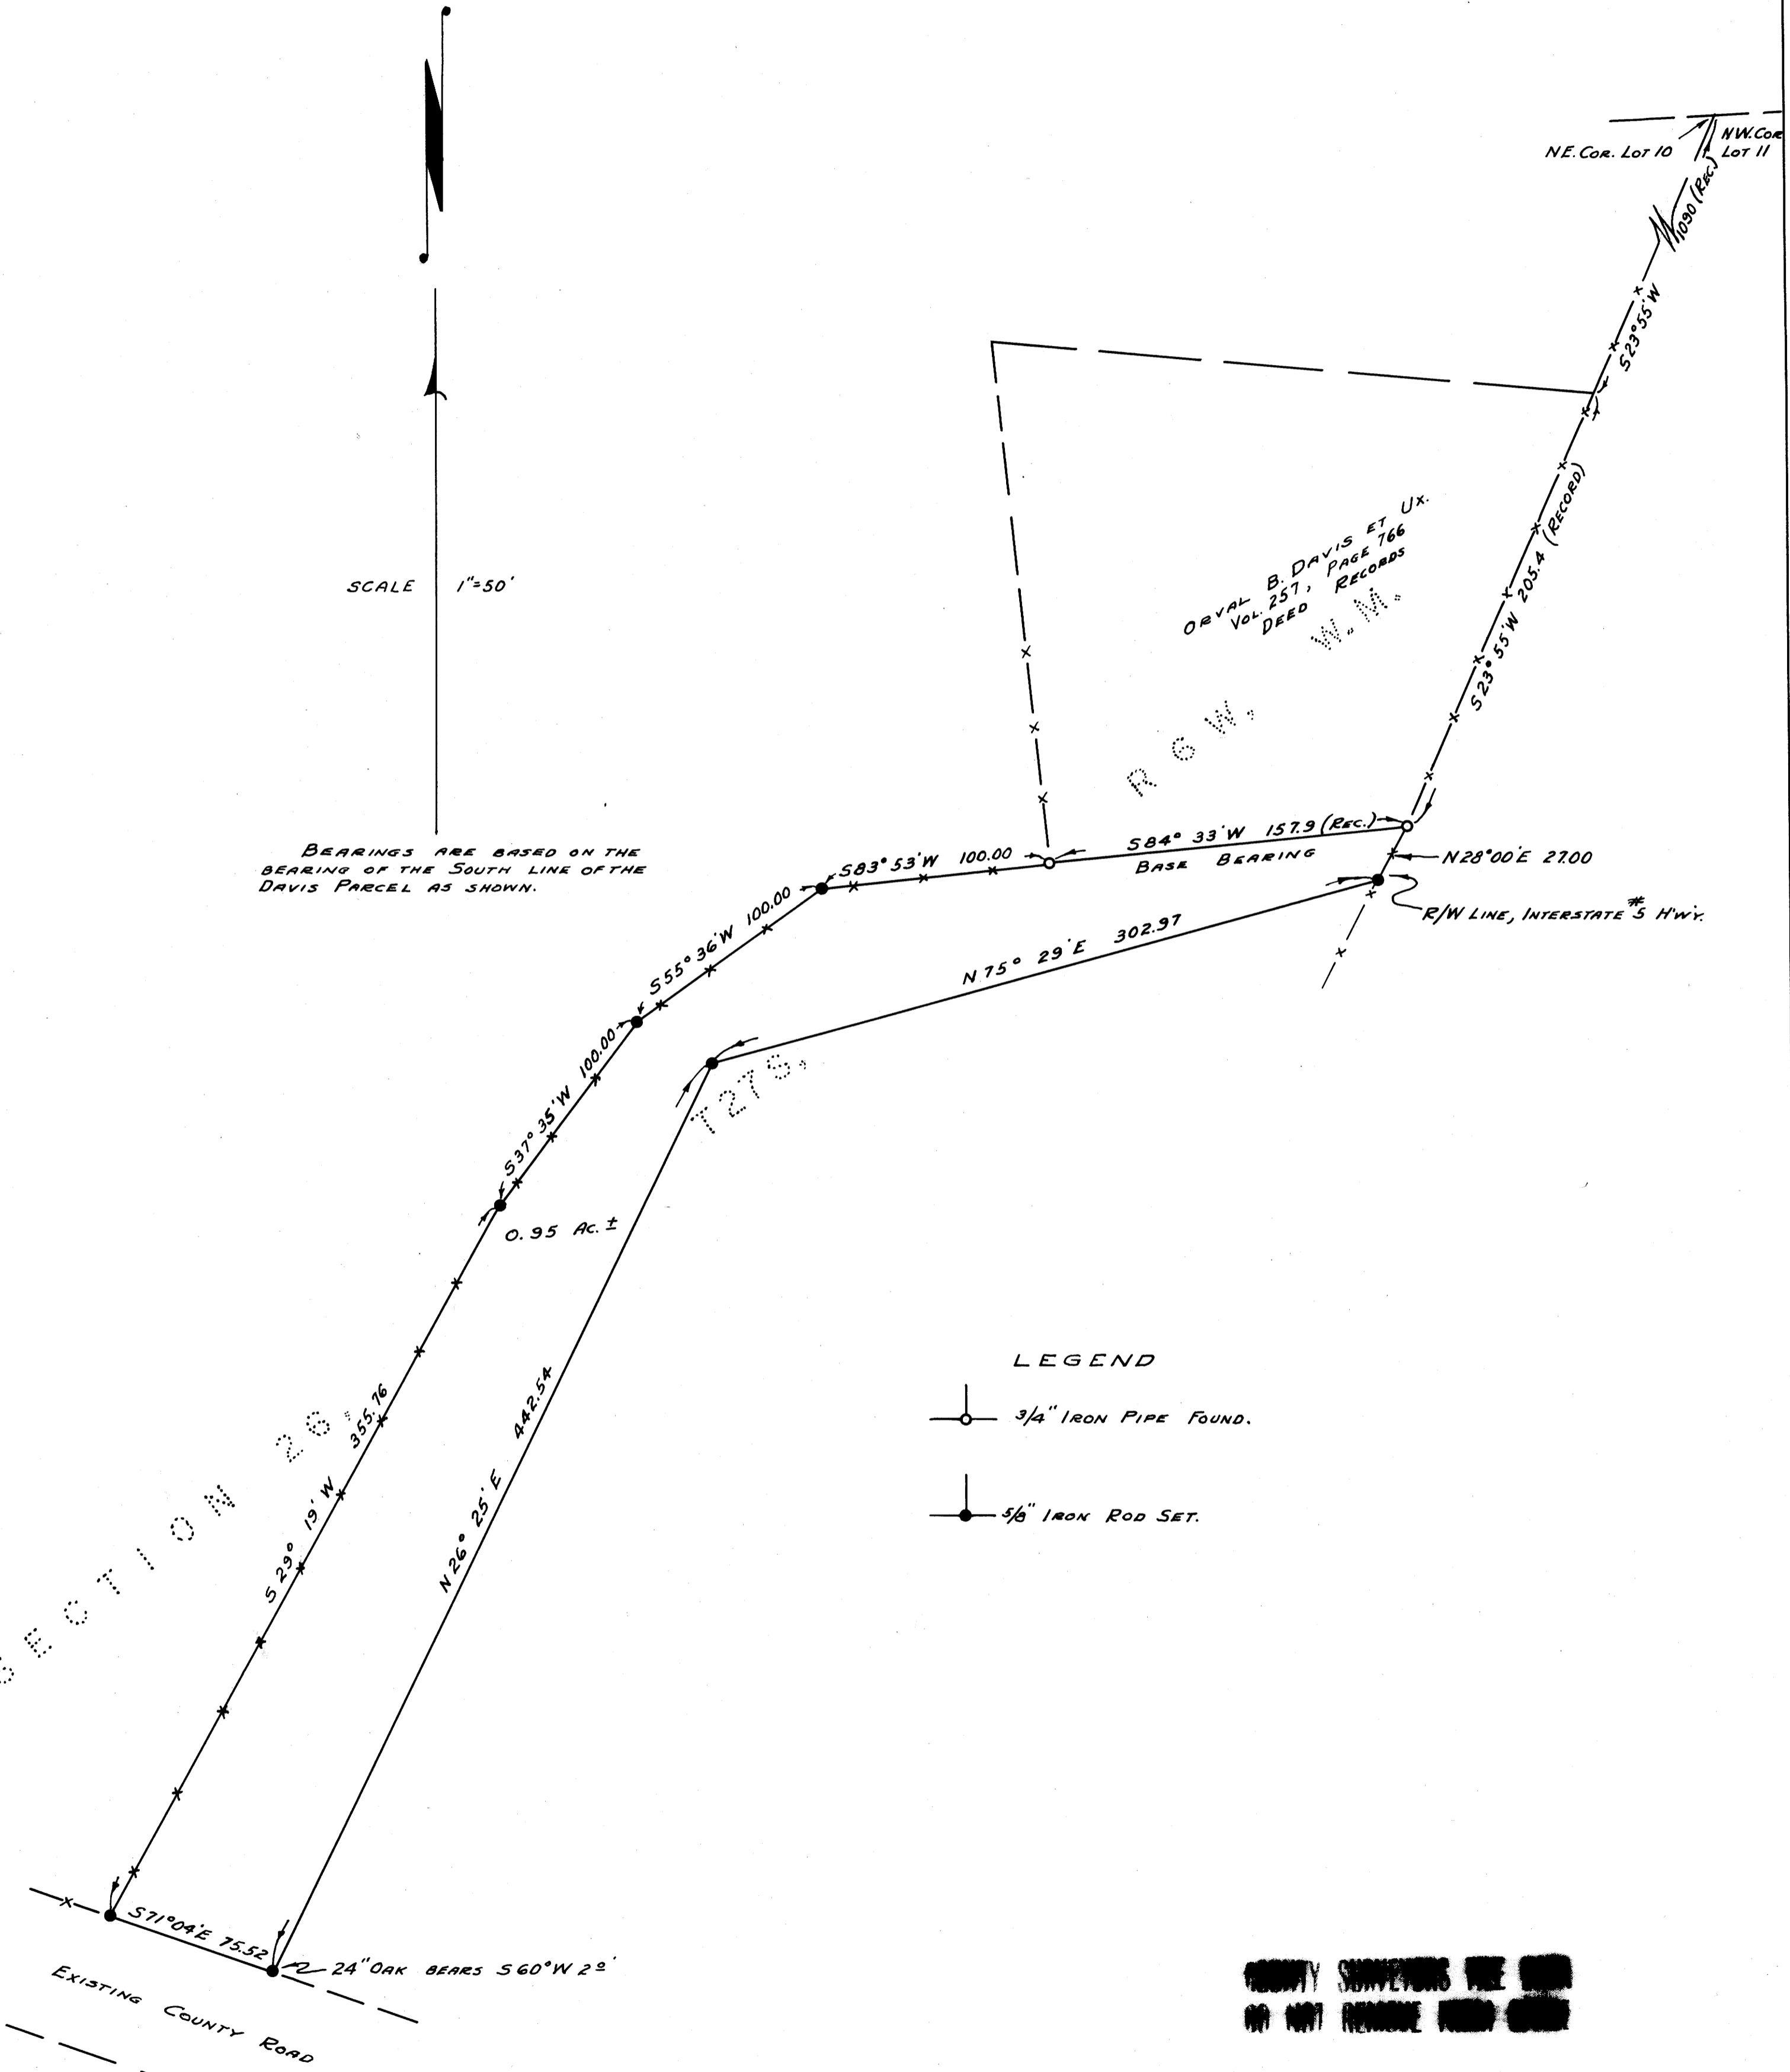

LEGEND

- 3/4" IRON PIPE FOUND.
- 5/8" IRON ROD SET.

SECTION 28

COUNTY SURVEYORS FILE NO. 101

FILED *LL*
RECEIVED
FEB 8 1965
COUNTY SURVEYOR
DOUGLAS COUNTY, ORE.



SURVEY FOR DEED DESCRIPTION
PART OF LOT 10, BLOCK B, OF
UMPQUA PARK FRUIT LANDS
SURVEYED FOR ORVAL DAVIS
SURVEYED BY BRUCE SHANER
FEBRUARY, 1965 SCALE 1" = 50'