


ESTABLISHMENT OF
 JAMES NEWELL PERDUE'S GATEWAY ROAD
 FOR PAUL JAFFARIAN
 N.E. 1/4 of SECTION 7, T30S, R3W, W.M.
 DOUGLAS COUNTY, OREGON
 WESTERN ENGINEERING CONSULTANTS
 1445 WILLAMETTE ST. EUGENE, OREGON
 DRWN. DS. DATE OF FIELD WORK 2-5-65
 DRWN DATE 2-10-65 JOB No. 3231 BK No. 234 TUBE

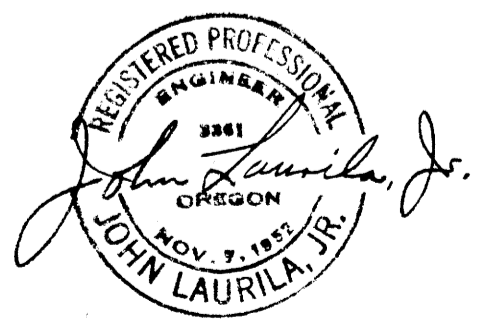

FILED
 RECEIVED
 FEB 2 1965
 COUNTY SURVEYOR
 DOUGLAS COUNTY, ORE.