


FILE M. 22. f. 32

RECEIVED
MAY 17 1965
SURVEYOR
CLATSOP COUNTY, ORE.

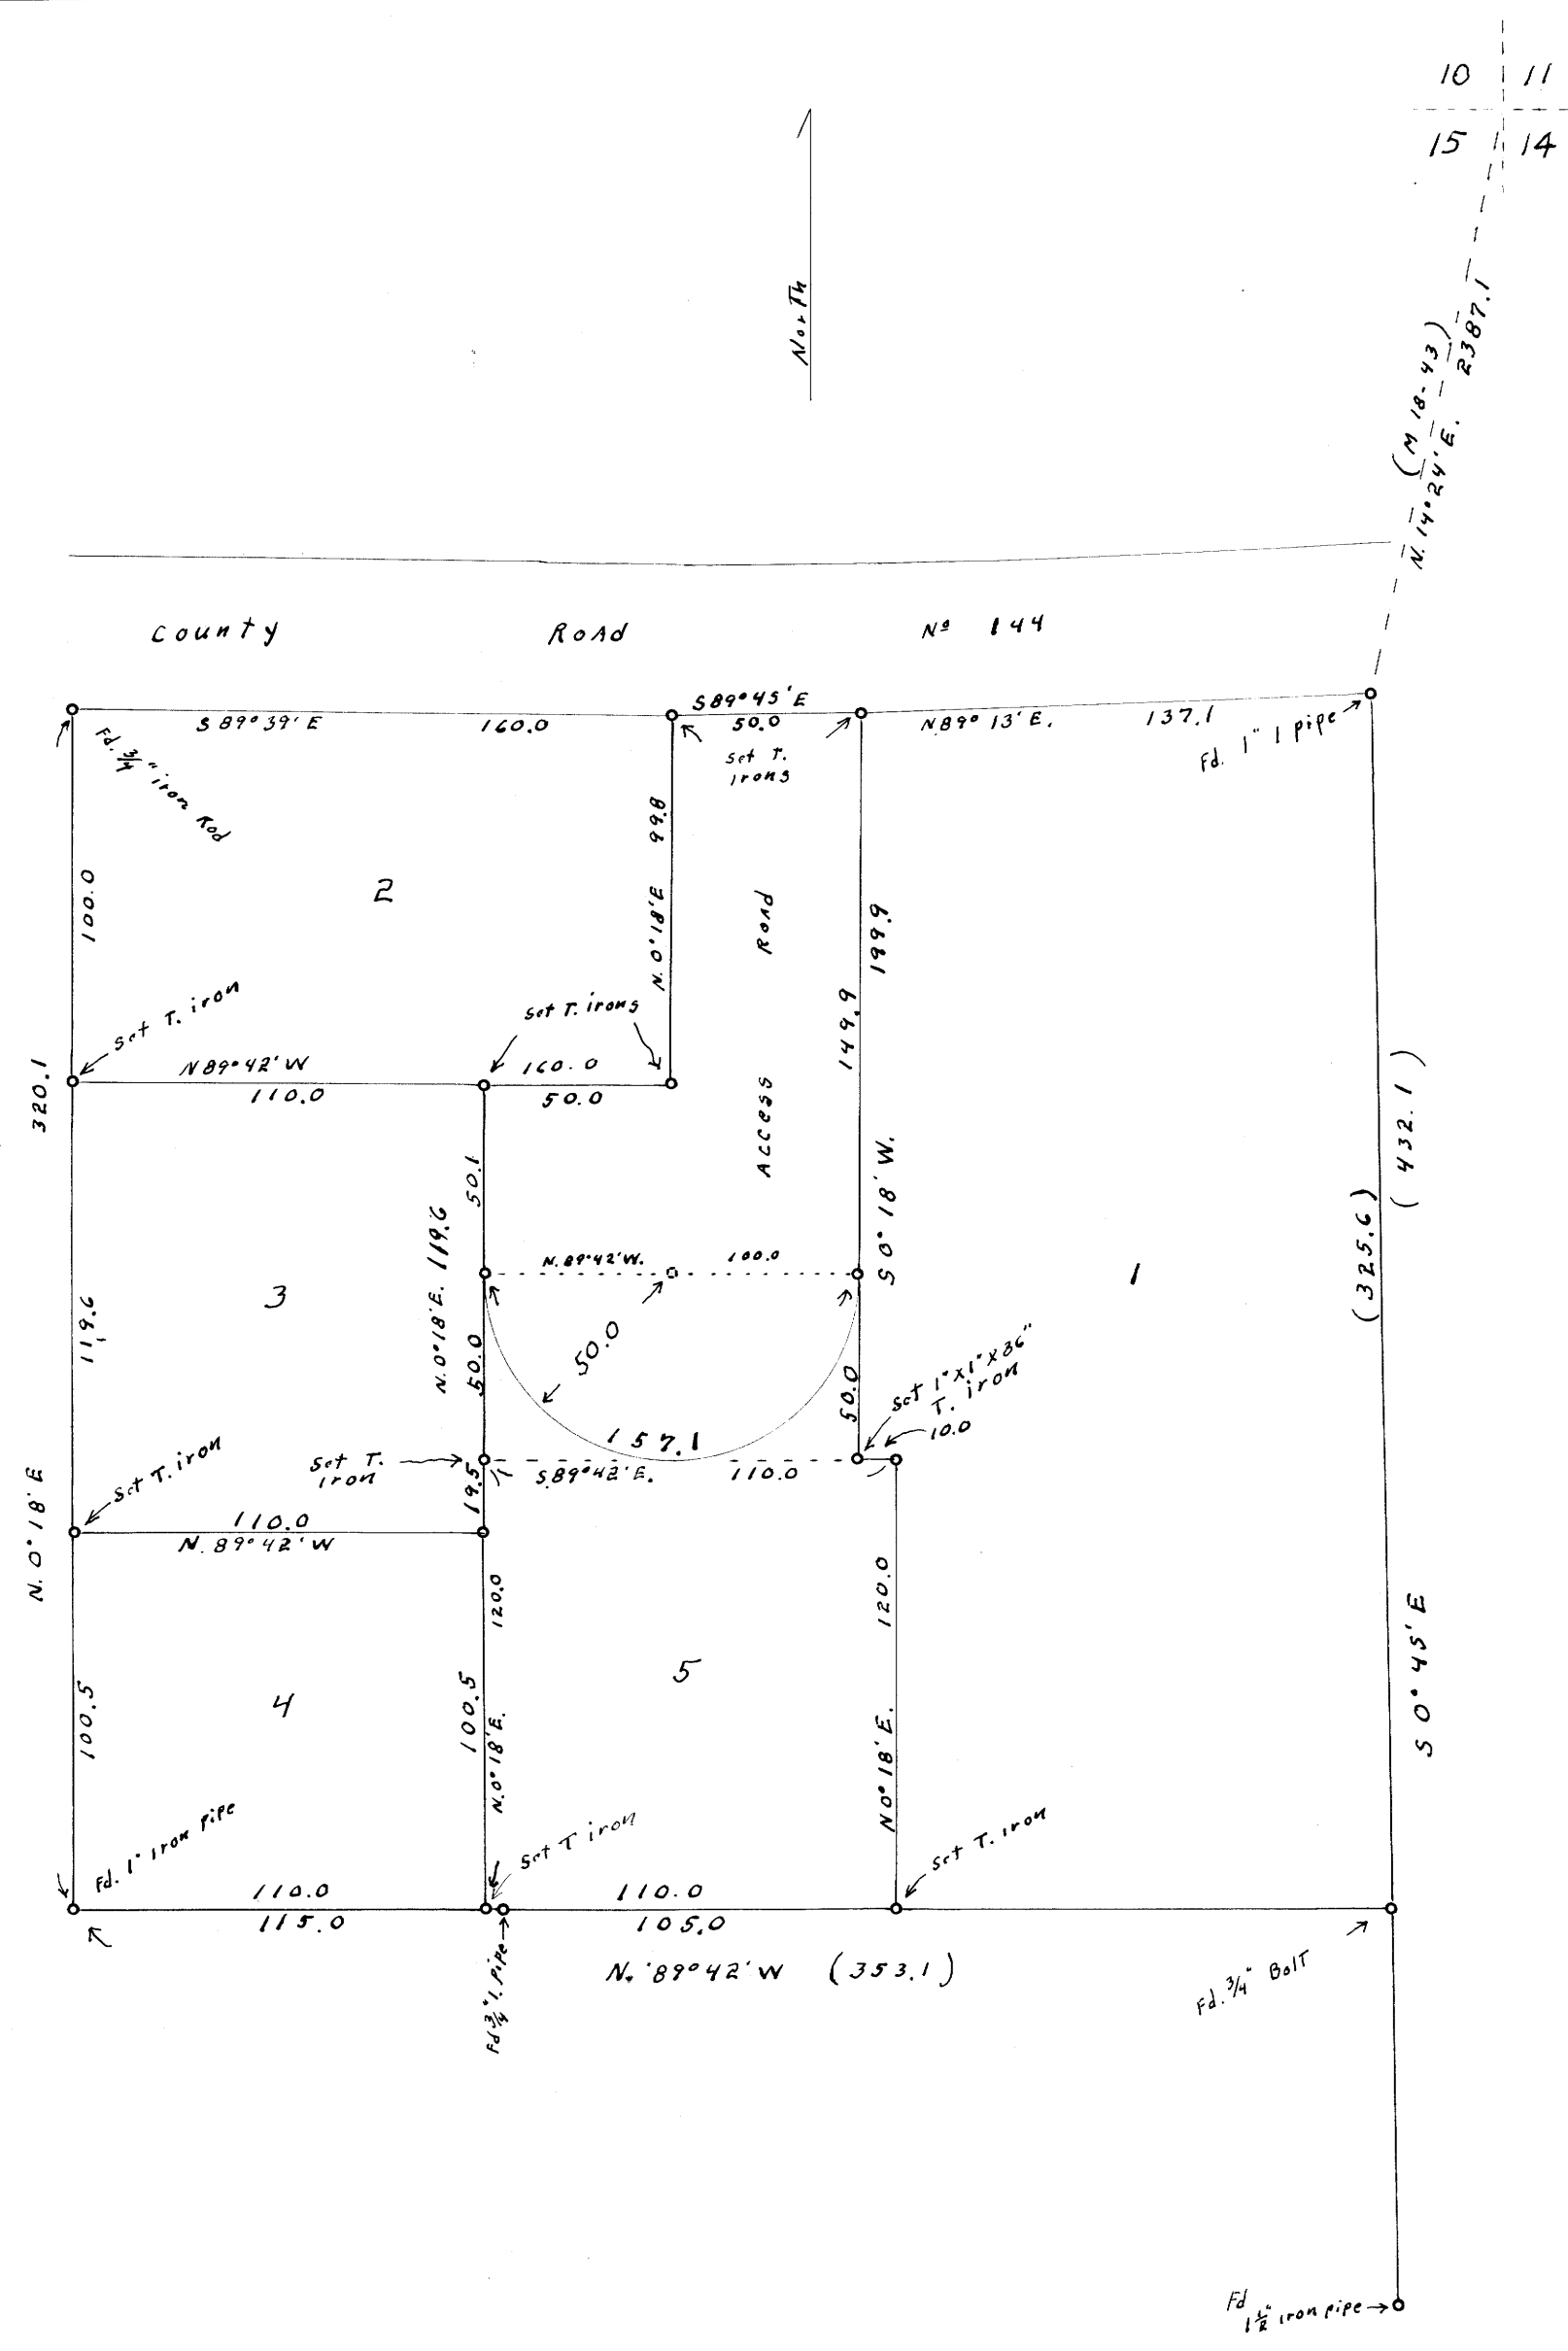

LONGTON PROPOSED SUBDIVISION
SECT. 15, T. 27 S., R. 6 W. W.M.
 For
HENERY L. LONGTON, 2727 N.W. CAIKINS ROAD
MARCH 2, 1965 Scale: 1" = 50'

REGISTERED
OREGON
 LAND SURVEYOR
Wilford N. Haines
 MAY 7, 1949
WILFORD N. HAINES
 239

RECORDS SECTION FILE DATA
 OF THIS RECORD FROM OFFICE

M. 22. f. 32