


BEARINGS ARE BASED ON THE SOUTH
LINE OF LOT 47 ESTABLISHED BY
ARTHUR BOYER C.S. FILE M-24-20

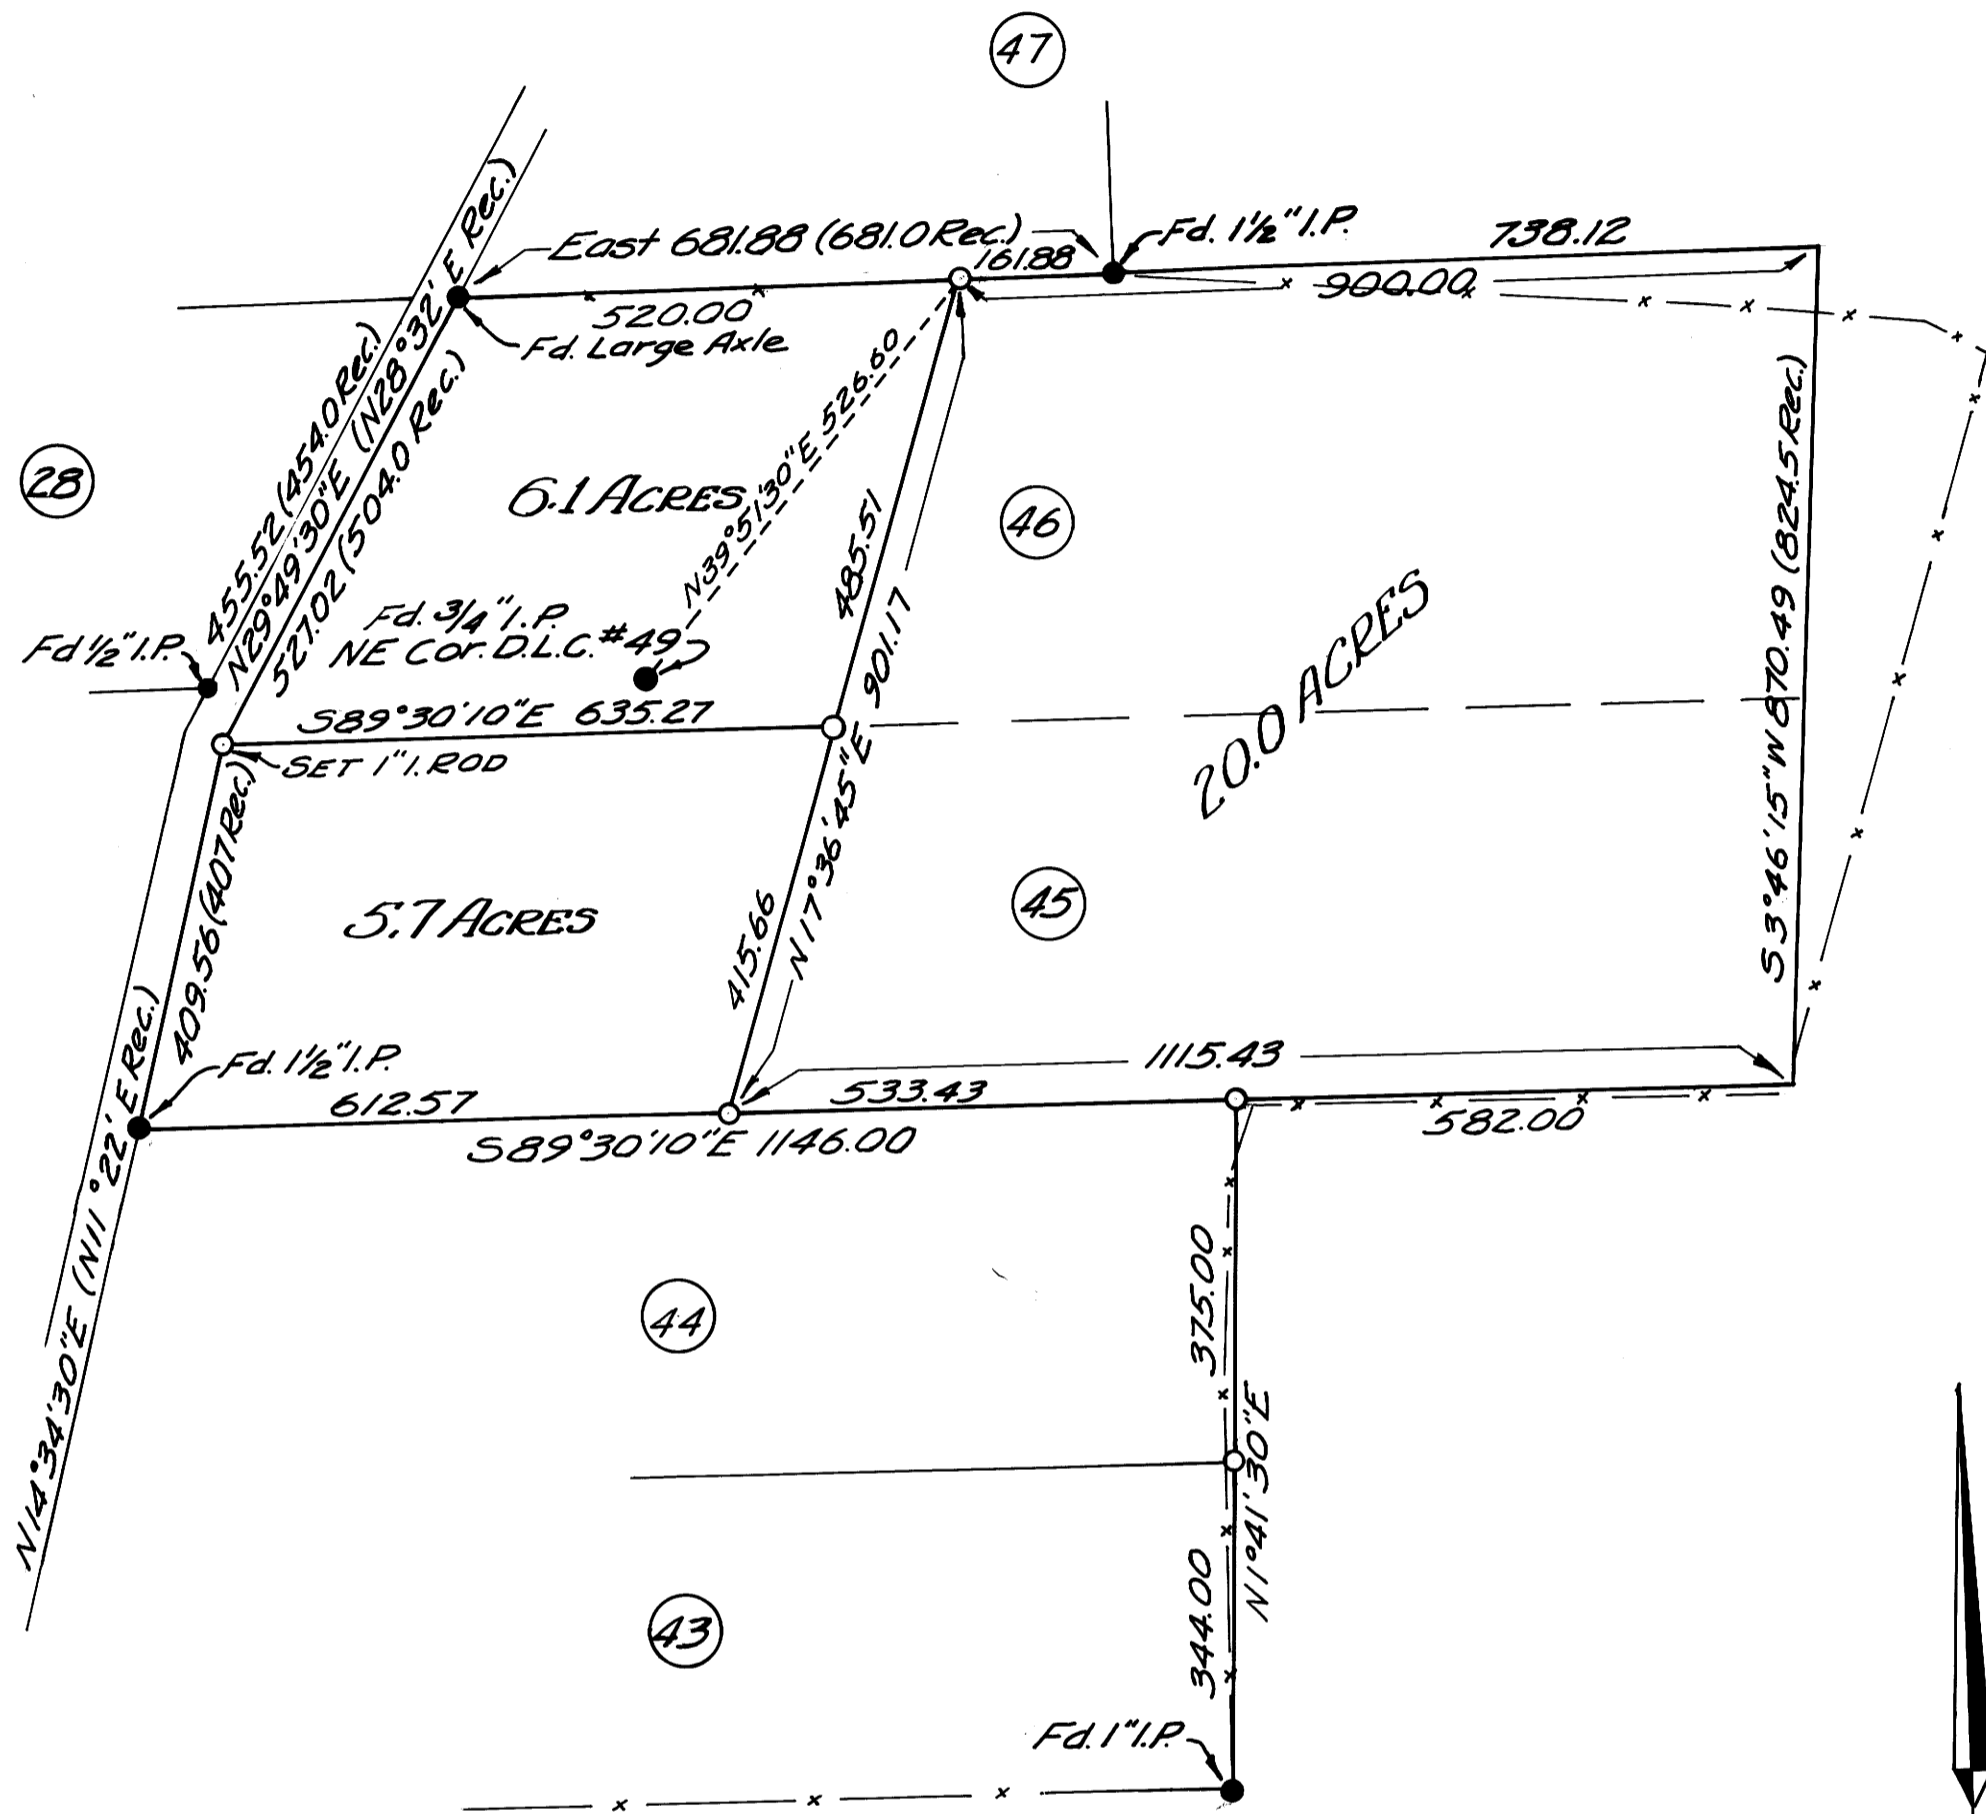

SCALE - 1" = 200'

REGISTERED
OREGON
LAND SURVEYOR

Bruce R. Rogers

JULY 30, 1965
BRUCE R. ROGERS
630

o DENOTES 3/4" I. ROD SET
UNLESS OTHERWISE NOTED



FILED
RECEIVED

APR 15 1965

COUNTY SURVEYOR
DOUGLAS COUNTY, ORE.

**SURVEY FOR DEED DESCRIPTIONS
LOTS 45 & 46 ROSEBURG ORCHARD CO. PLAT 1 TRACT 1
AND ESTABLISHING THE EASTERLY BOUNDARY OF LOTS 43 & 44
SURVEYED BY BRUCE R. ROGERS APRIL, 1965
FOR CHARLES MARKILLIE
SECTION 6 T27S R5W, WM**

COUNTY SURVEYORS FILE
DO NOT REMOVE FROM