


3 Chs N. of D.L.C. corner

3 Chs N. of D.L.C. Cor.

FILED *LL*
 RECEIVED
 APR 26 1965
 COUNTY SURVEYOR
 DOUGLAS COUNTY, ORE.

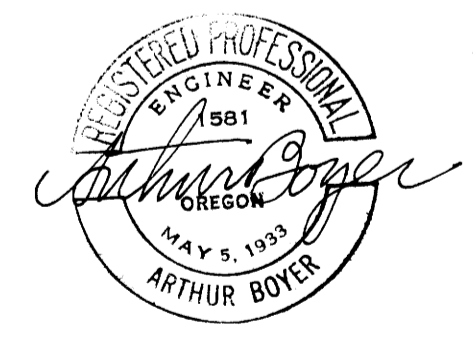

COUNTY SURVEYORS FILE DATA
 DO NOT REMOVE FROM OFFICE

A. O. ANDERSON, RICE HILL
 TRIANGULAR PARCEL OF LAND
 N. OF S. LINE D.L.C. 47, SEC. 28, T. 23 S.; R. 5 W.; W.M.
 DOUGLAS COUNTY, ORE.
 APR. 1965 1" = 40'

Found Orig. Rock & B.T.'s
 for S.W. Cor. D.L.C. 47, 23/5

Robert Smith D.L.C. - S. Line #47

Found Orig. Rock & B.T.'s for SE Cor. D.L.C. 47, 23/5