

FILED *LL*  
RECEIVED

MAY 14 1965

COUNTY SURVEYOR  
DOUGLAS COUNTY, ORE.

# SURVEY FOR DEED DESCRIPTION FOR DAVID C. STINE

## SOUTH HALF LOT 18 SUKSDORF COOS JUNCTION ORCHARD TRACTS

SECTION 21, T.28S. R.6W.W.M.  
May 12, 1965  
Scale 1" = 50'  
REV. May 26, 1965


COUNTY SURVEYORS FILE DATA  
DO NOT REMOVE FROM OFFICE

MAP FILE M.227 7 61

REGISTERED  
OREGON  
LAND SURVEYOR

*Glenn S. Baughman*

JULY 14, 1961  
GLENN S. BAUGHMAN  
536

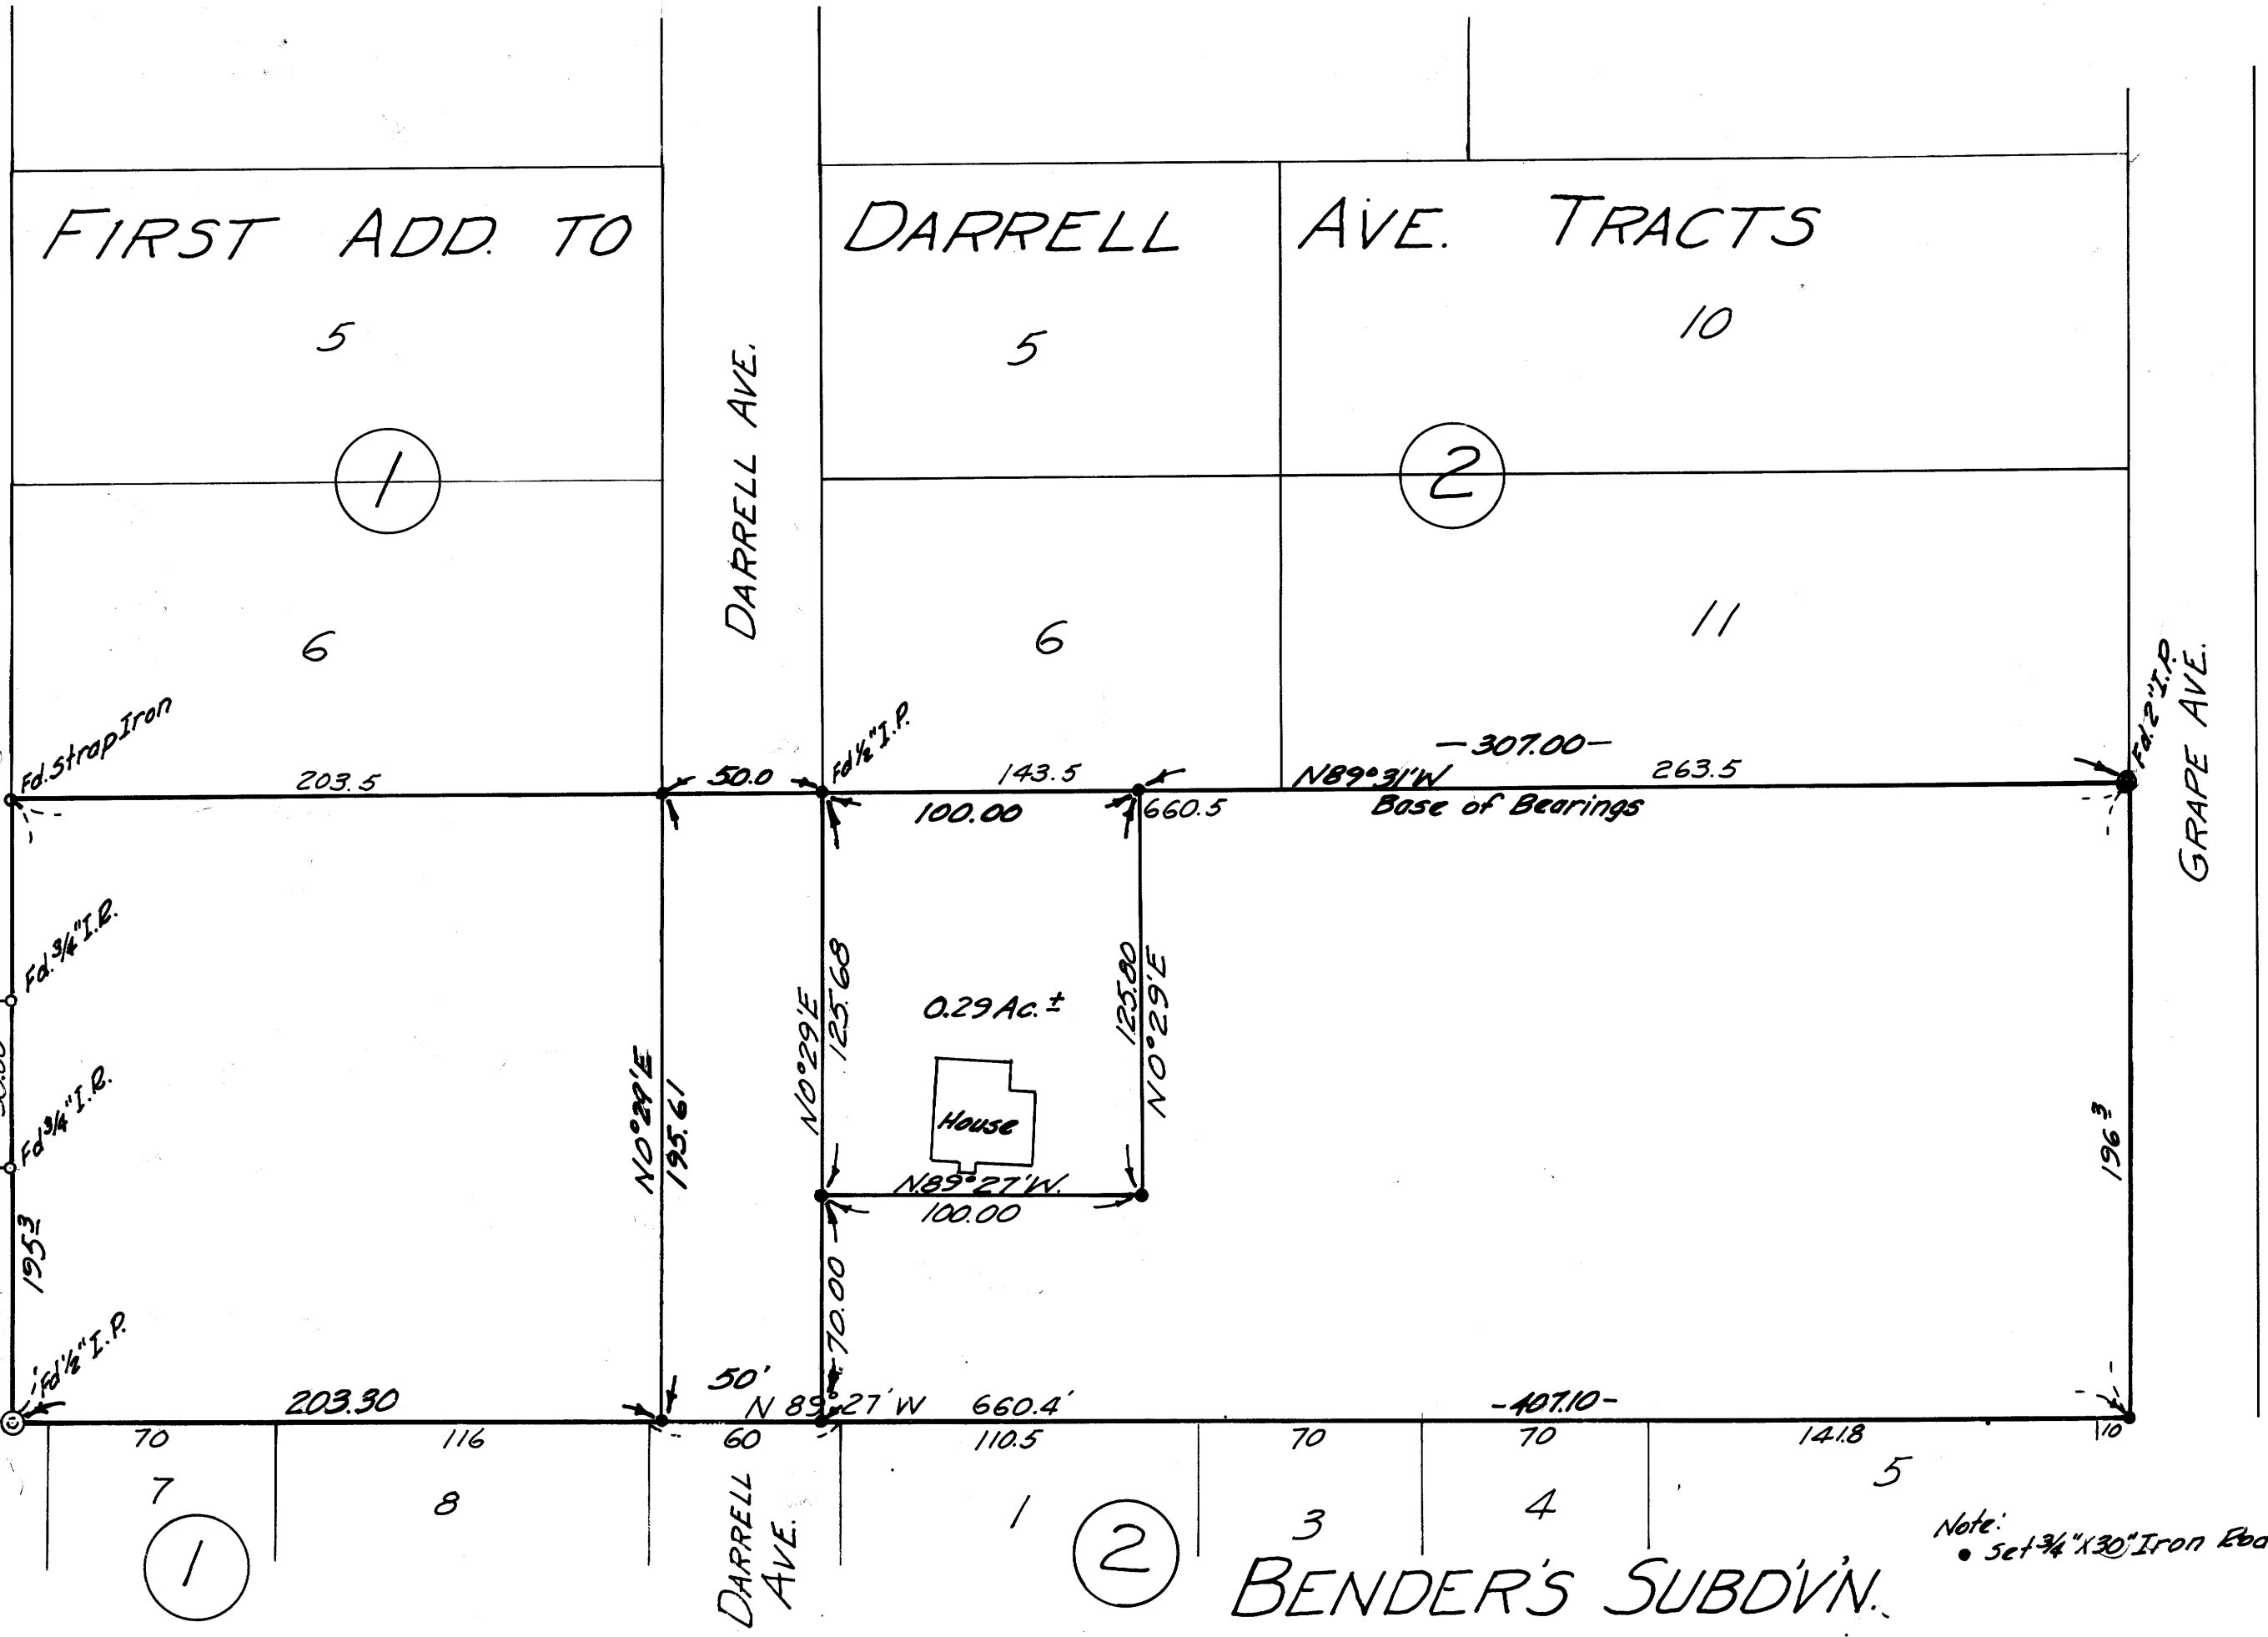

TRACTS  
2  
2

CARTER ST.

CAPTER  
4

BENDER'S SUBDV'N.



MAP FILE M.227 7 61