

FD $\frac{1}{4}$ COR. AS PER U.S. ORIG. NOTES. STONE & B.T.'S IN GOOD SHAPE

N $\frac{1}{4}$ COR. SEC. 26
 N88°57'44"E 1313.21'
 RANDOM LINE
 SET $\frac{3}{4}$ " I.P. FROM WHICH A
 28" FIR BRS, S0°45'W, 12.0'
 36" FIR BRS, N72½°W, 16.6'


W $\frac{1}{4}$ COR. SEC. 26
 SET 1" I.P. FROM WHICH A
 11" FIR, BRS. S33°20'W 14.1'
 12" FIR, BRS. N64°45'E 18.4'

FD COR. AS RENEWED BY WENDEROTH, 1948

FD B.T.'S FOR $\frac{1}{4}$ COR

FD 1" I.P. & I.B.T. FOR $\frac{1}{4}$ COR, FD FIR STUMP FOR B.T.

THIS COPY MADE FROM A XEROX 2510
 DATE July 31, 89

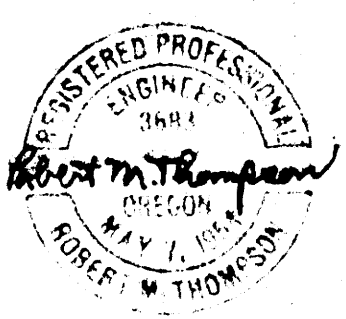

SURVEY TO LOCATE NORTH $\frac{1}{4}$ COR. 27 + 26
T31S, R3W, W.M., DOUGLAS COUNTY, ORE.

FILED RECEIVED 12 MAY 1960

SCALE 1 INCH = 400 FEET

MAR 11 1966
 COUNTY SURVEYOR DOUGLAS COUNTY, ORE.

Drawn By R.D.G

For R.M. THOMPSON COUNTY SURVEYORS FILE DATA

DONE FOR SUPERIOR LUMBER CO. (DO NOT REMOVE FROM OFFICE)