

COUNTY SURVEYORS FILE DATA  
DO NOT REMOVE FROM OFFICE

# SURVEY TO ESTABLISH PROPERTY CORNERS IN LOT 2, BLOCK 1, LONDON TRACT SUB., ROSEBURG, ORE.


SURVEYED FOR- JOHN HORN  
" BY - W. S. BARNES

APRIL 1966  
SCALE 1" = 30'

FILED  
RECEIVED

APR 18 1966

COUNTY SURVEYOR  
DOUGLAS COUNTY, ORE.

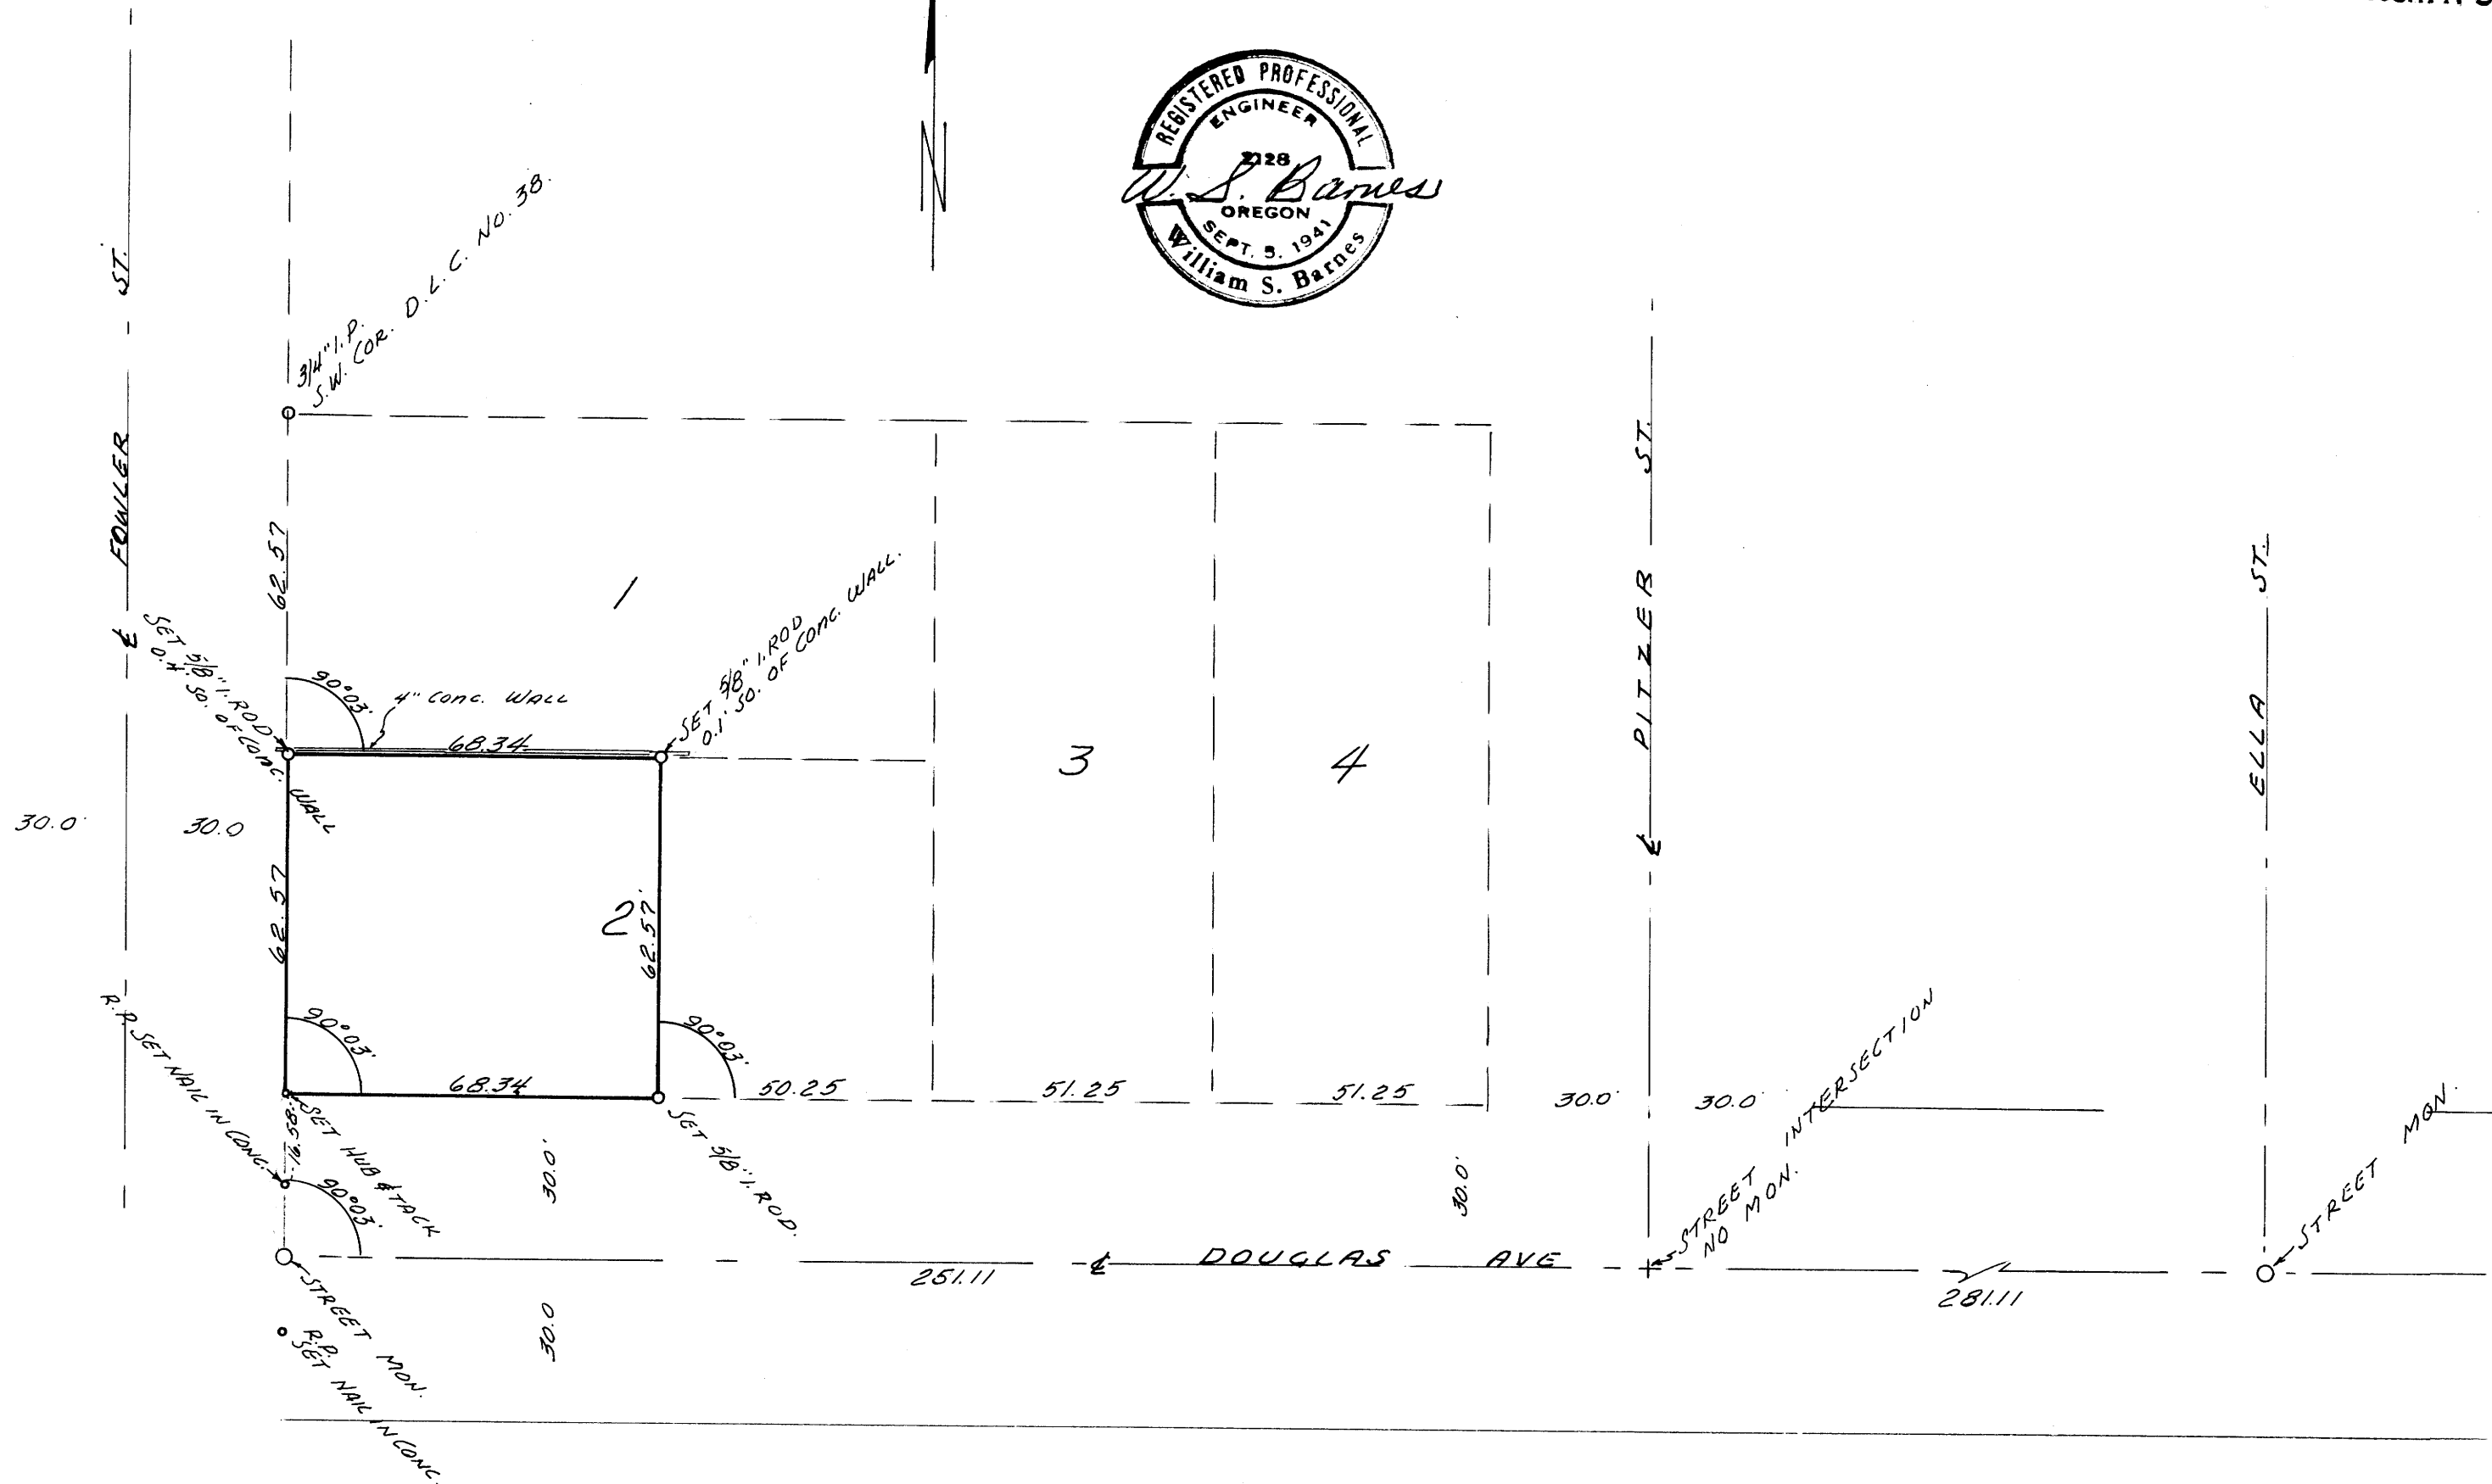

M 31-37

MAP FILE M 31-37