


COUNTY SURVEYORS FILE DATA  
DO NOT REMOVE FROM OFFICE

SURVEY TO ESTABLISH PROPERTY CORNERS  
IN G.A. BURT D.L.C. NO. 40,  
T23S, R5W, W.M. YONCALLA, ORE.

SURVEYED FOR - KITTIE EMERY  
SURVEYED BY - W. S. BARNES

MAY 1966  
SCALE 1" = 60'

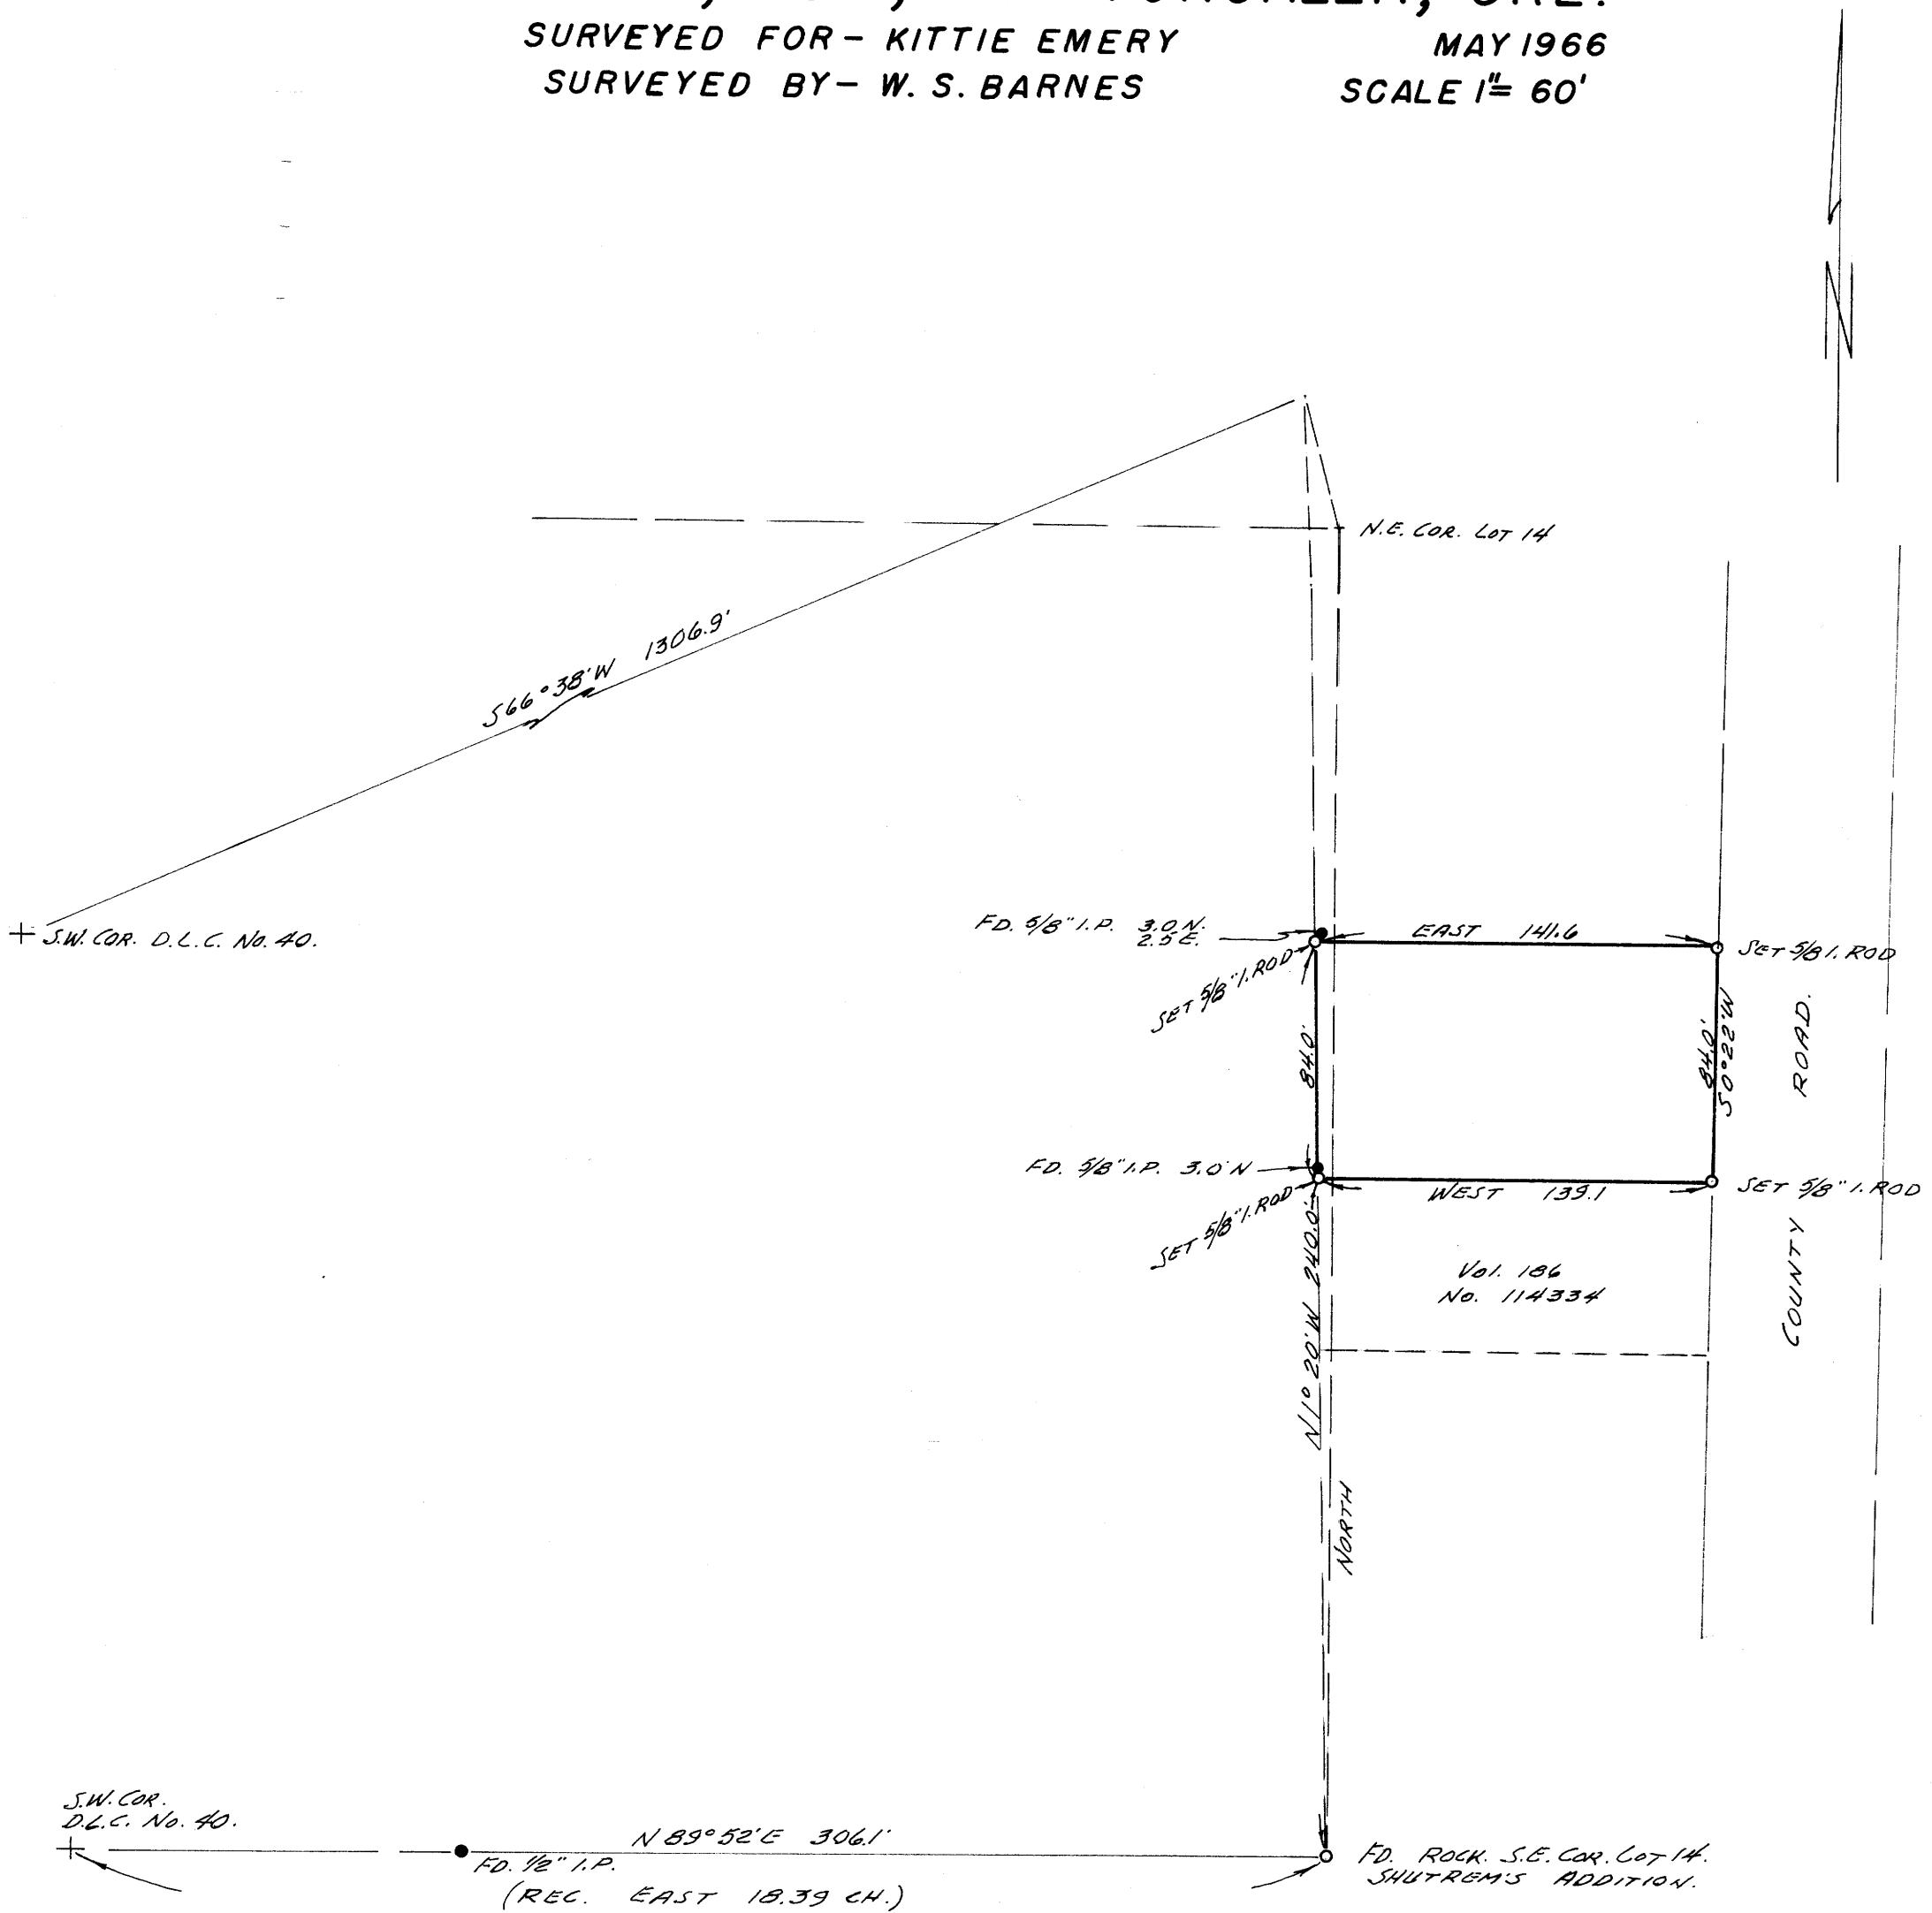

NOTE: BEARING BASE TAKEN FROM SOUTH LINE -  
N 89° 52' E. SEE CO. FILE M 14 - 67.



FILED  
RECEIVED

MAY 5 1966

COUNTY SURVEYOR  
DOUGLAS COUNTY, ORE.

POSTED

MAP FILE M.31. P. 48...