


SURVEY FOR WM. WRIGHT
IN SEC. 32, T25SR6W

MAR. 29, 1966

T - GODFREY
CH - W. J. KEHARD
AXE - WRIGHT

TIE TO S.W. COR. CHAS. BARRETT
D.L.C. # 54

BASE OF BEARINGS IN FIELD NOTES
WAS NEEDLE BEARING BETWEEN
HUBS 1 & 2 - CORRECTED IN
DESCRIPTION TO MAKE STARTING
POINT OF SURVEY LINE DIRECTLY
SOUTH OF D.L.C. COR.

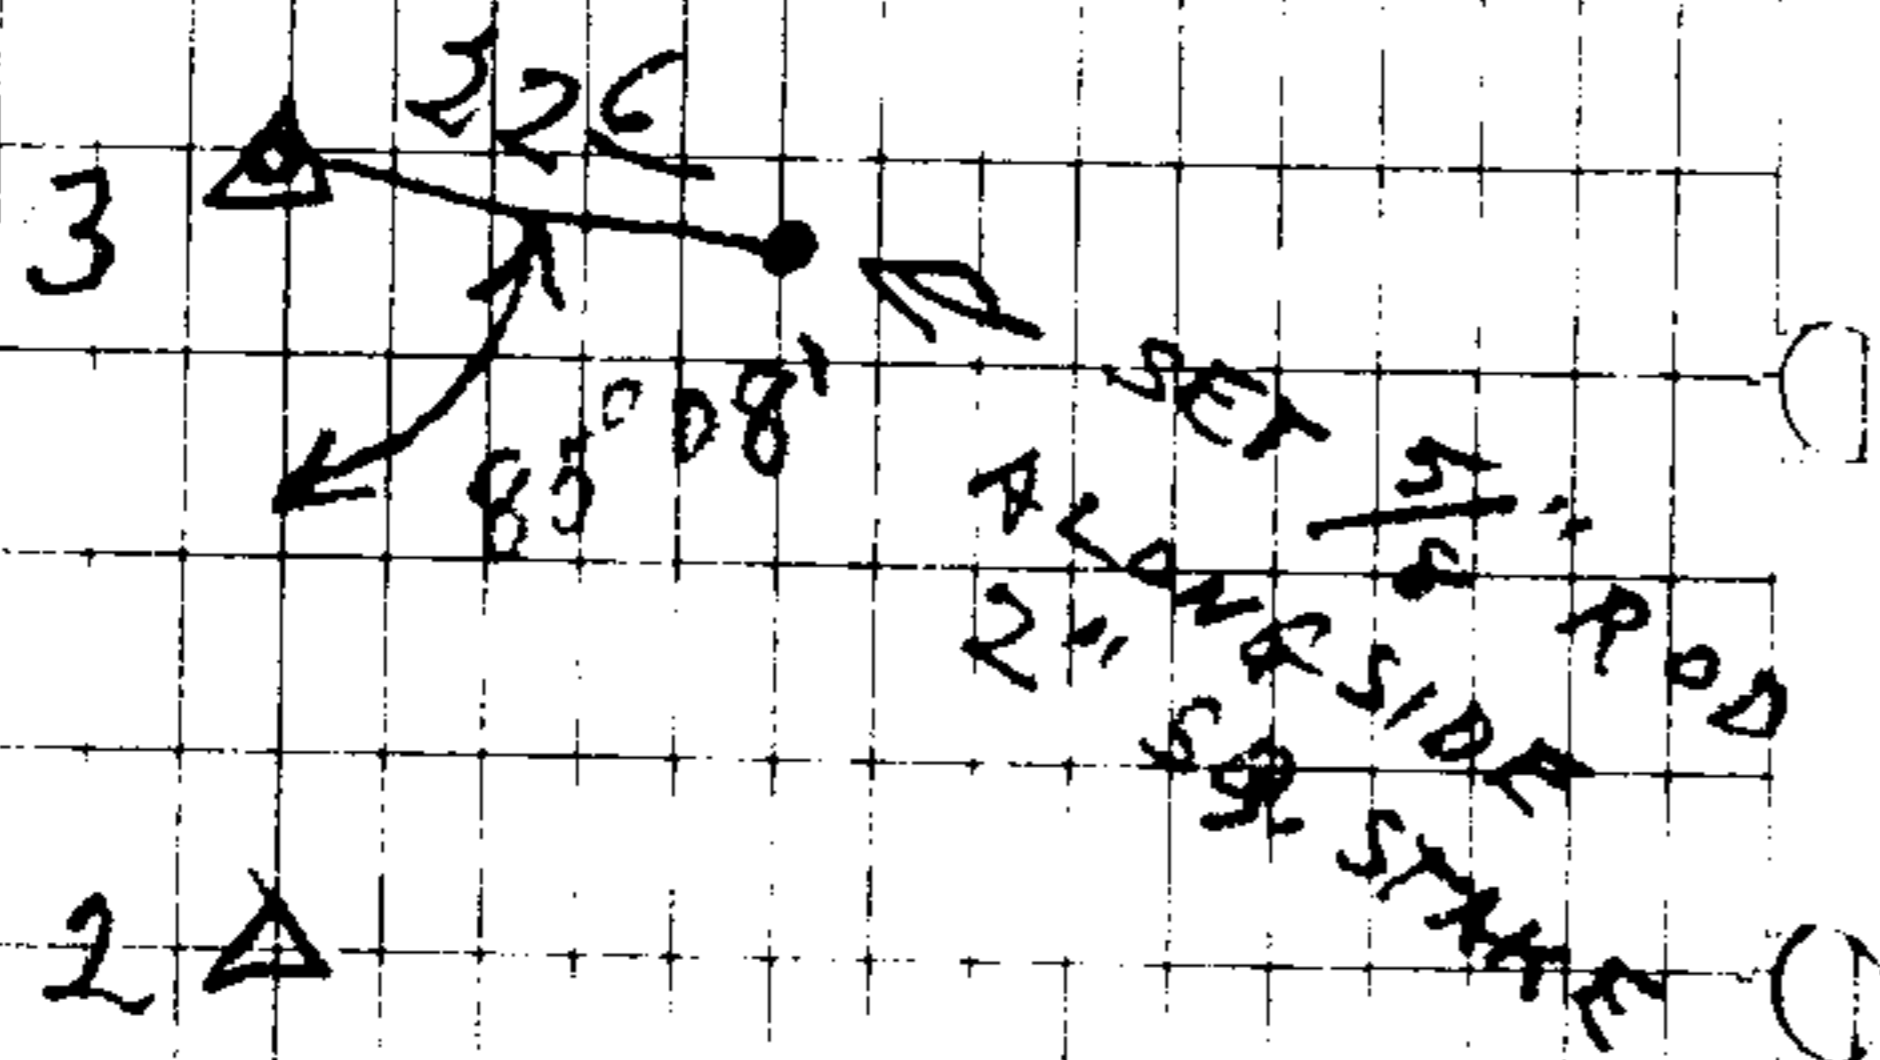

C.S. File No. 51/34B

RUN FOR WM. WRIGHT
R, WITH B.T.s, WHICH MARKS THE
BARRETT D.L.C. # 54, IN

TO A 5/8" IRON ROD DRIVEN ALONGSIDE

26.9 FT. TO A 5/8" IRON ROD IN THE
WAY, AND WHICH IS THE TRUE POINT
VEYED.

POINT, THENCE N 74° 11' E 1047.95 FT.

IN THE TOP OF A FIR STUMP;

475.1 FT. TO A 5/8" IRON ROD;

6.9 FT. TO A 5/8" IRON ROD;

10.05 FT. TO A 5/8" IRON ROD;

7.5 FT. TO A 7/8" STEEL BAR IN

FENCE ALONG THE OAK HILLS COUNTY

REGISTERED
OREGON
LAND SURVEYOR

Milo E. Godfrey

MAY 13, 1960
MILO E. GODFREY
496

(SEE FOLDER FOR MORE INFO)