


COUNTY SURVEYORS FILE DATA
DO NOT REMOVE FROM OFFICE

SURVEY FOR DEED DESCRIPTION
AND TO SET PROPERTY CORNERS
IN SECTION 30, TWP. 26S, R. 5W. W.M.
SURVEYED FOR- EMIL ANTONEN
SURVEYED BY- W.S. BARNES
MAY 1966
SCALE - 1" = 30'

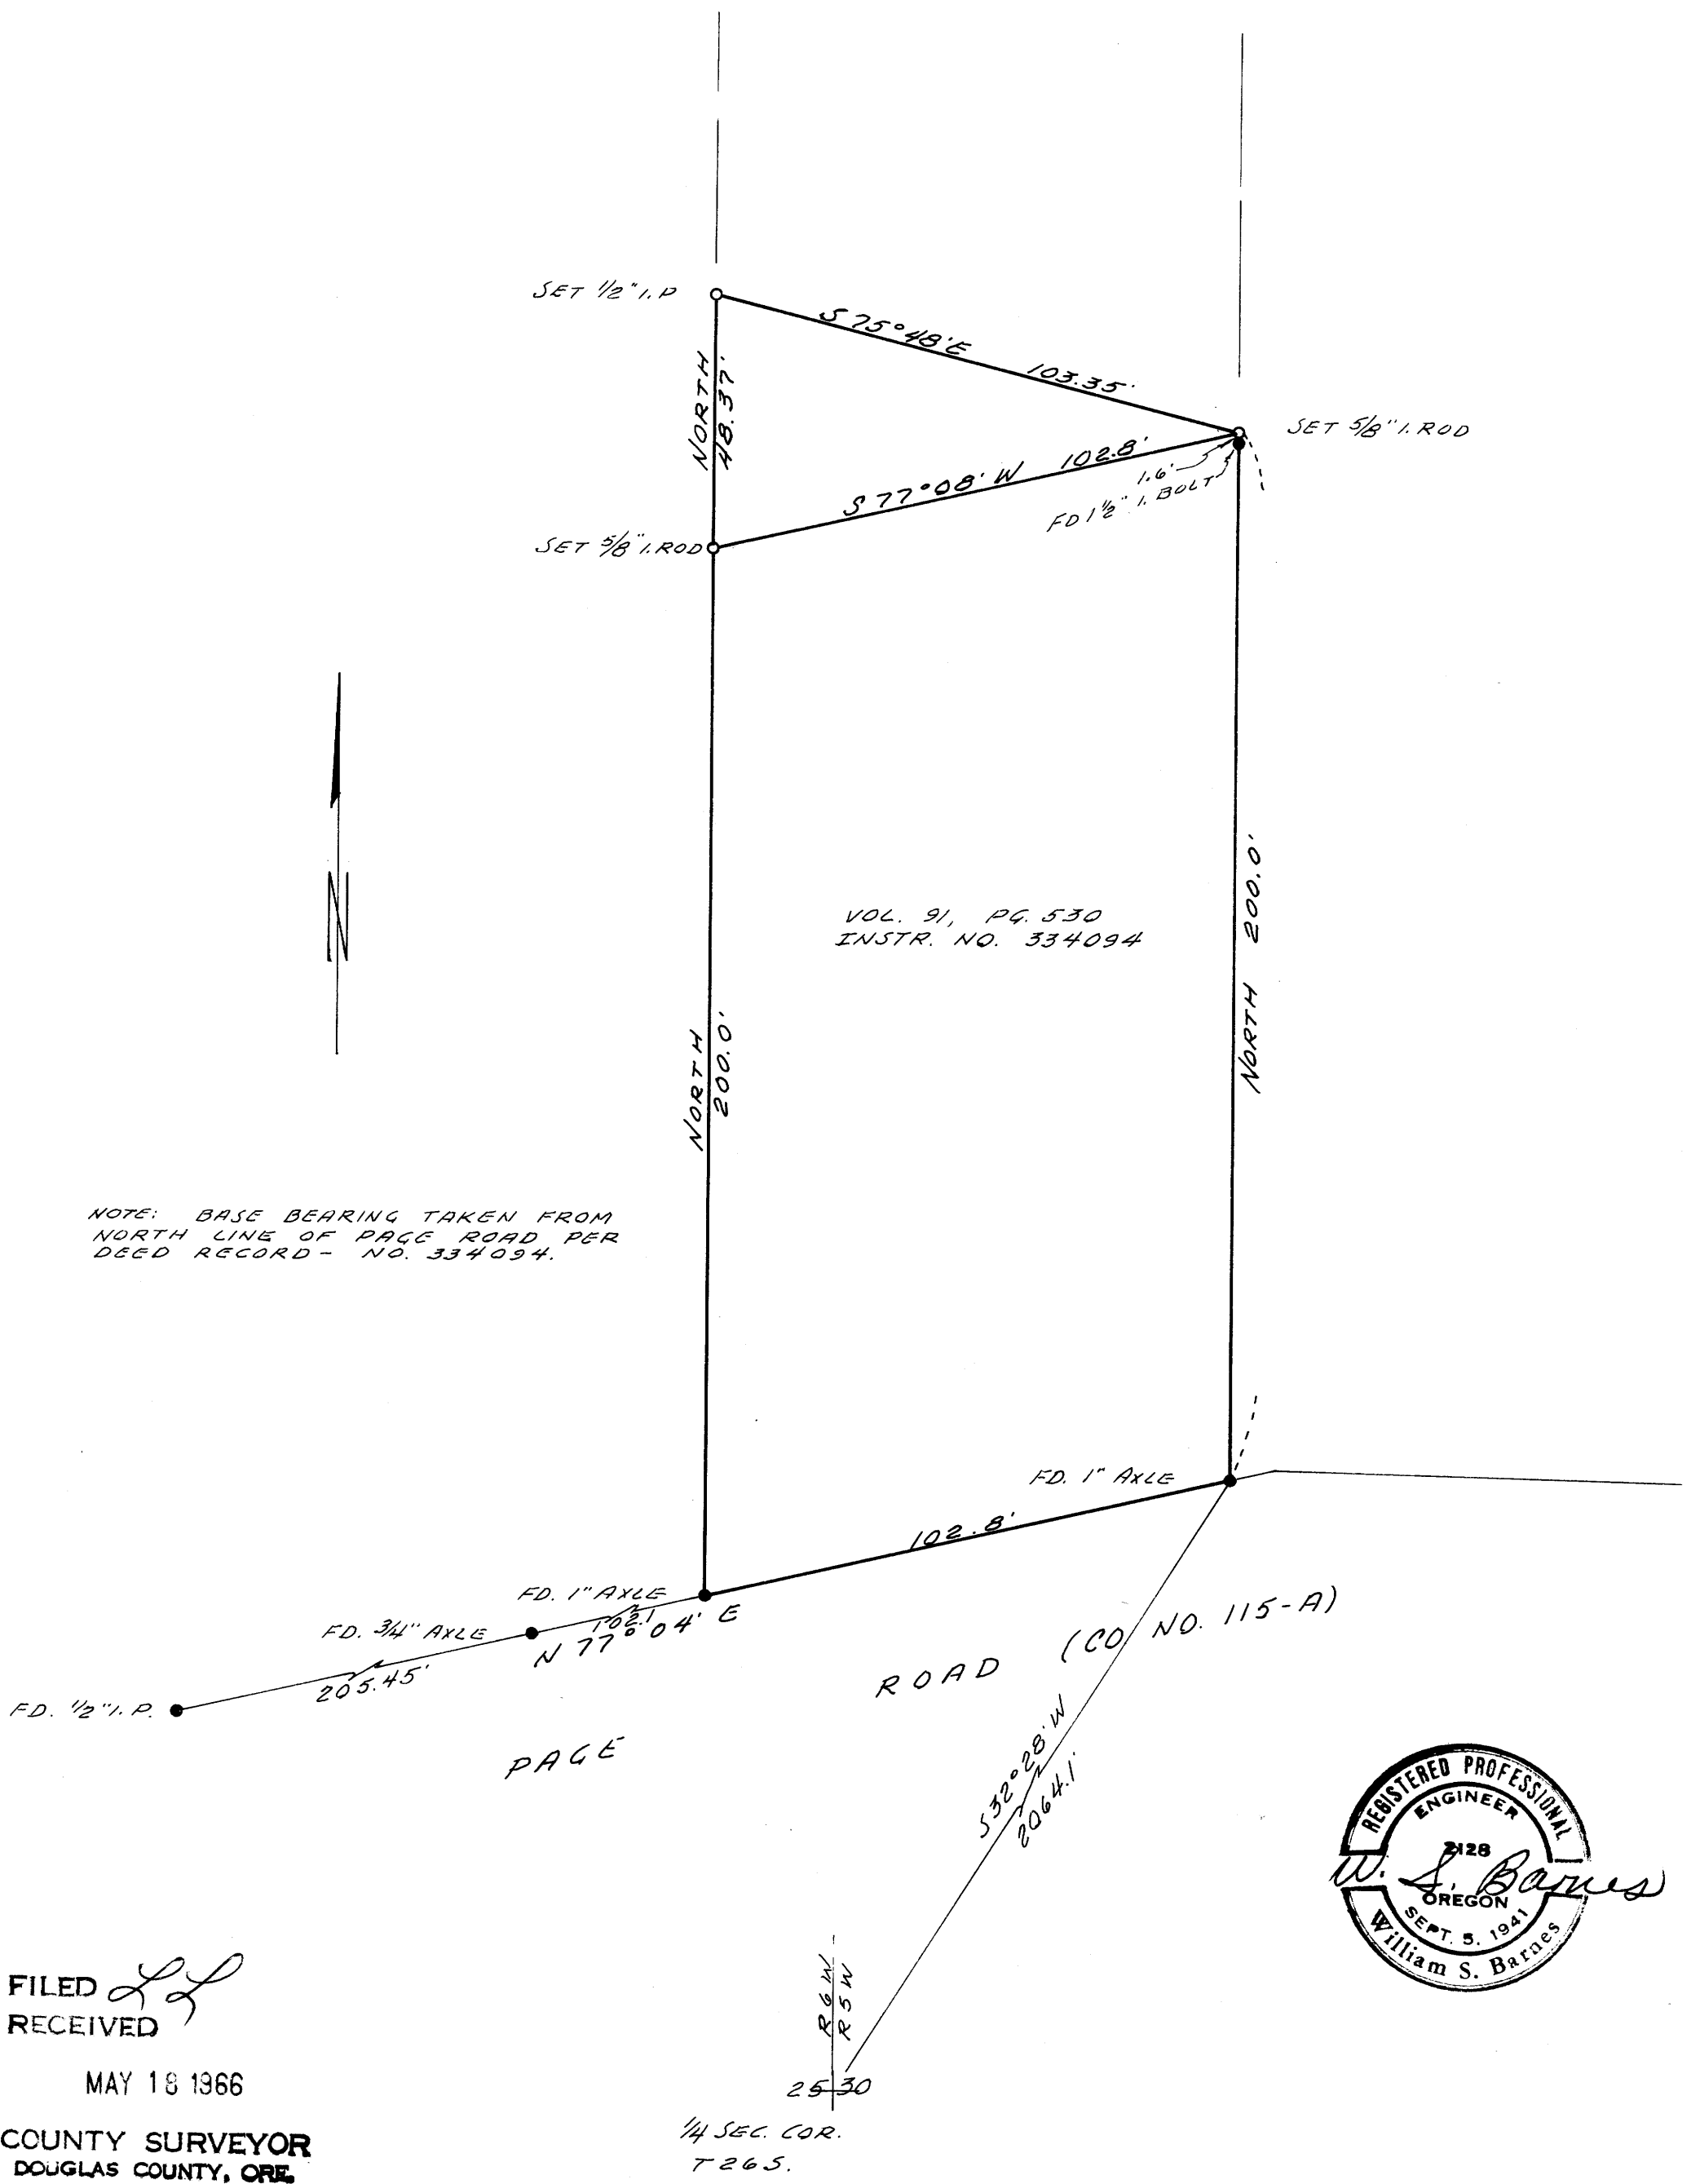

VOL. 91, PG. 530
INSTR. NO. 334094

NOTE: BASE BEARING TAKEN FROM
NORTH LINE OF PAGE ROAD PER
DEED RECORD - NO. 334094.



FILED *LL*
RECEIVED
MAY 18 1966

COUNTY SURVEYOR
DOUGLAS COUNTY, ORE.

1/4 SEC. COR.
T 265.