


COUNTY SURVEYORS FILE DATA
DO NOT REMOVE FROM OFFICE

SURVEY FOR DEED DESCRIPTION IN SEC. 7, T25S, R7W. W.M.

SURVEYED FOR - JOE PRUITT
ENG'R. - W.S. BARNES

JUNE 1966
SCALE 1" = 100'

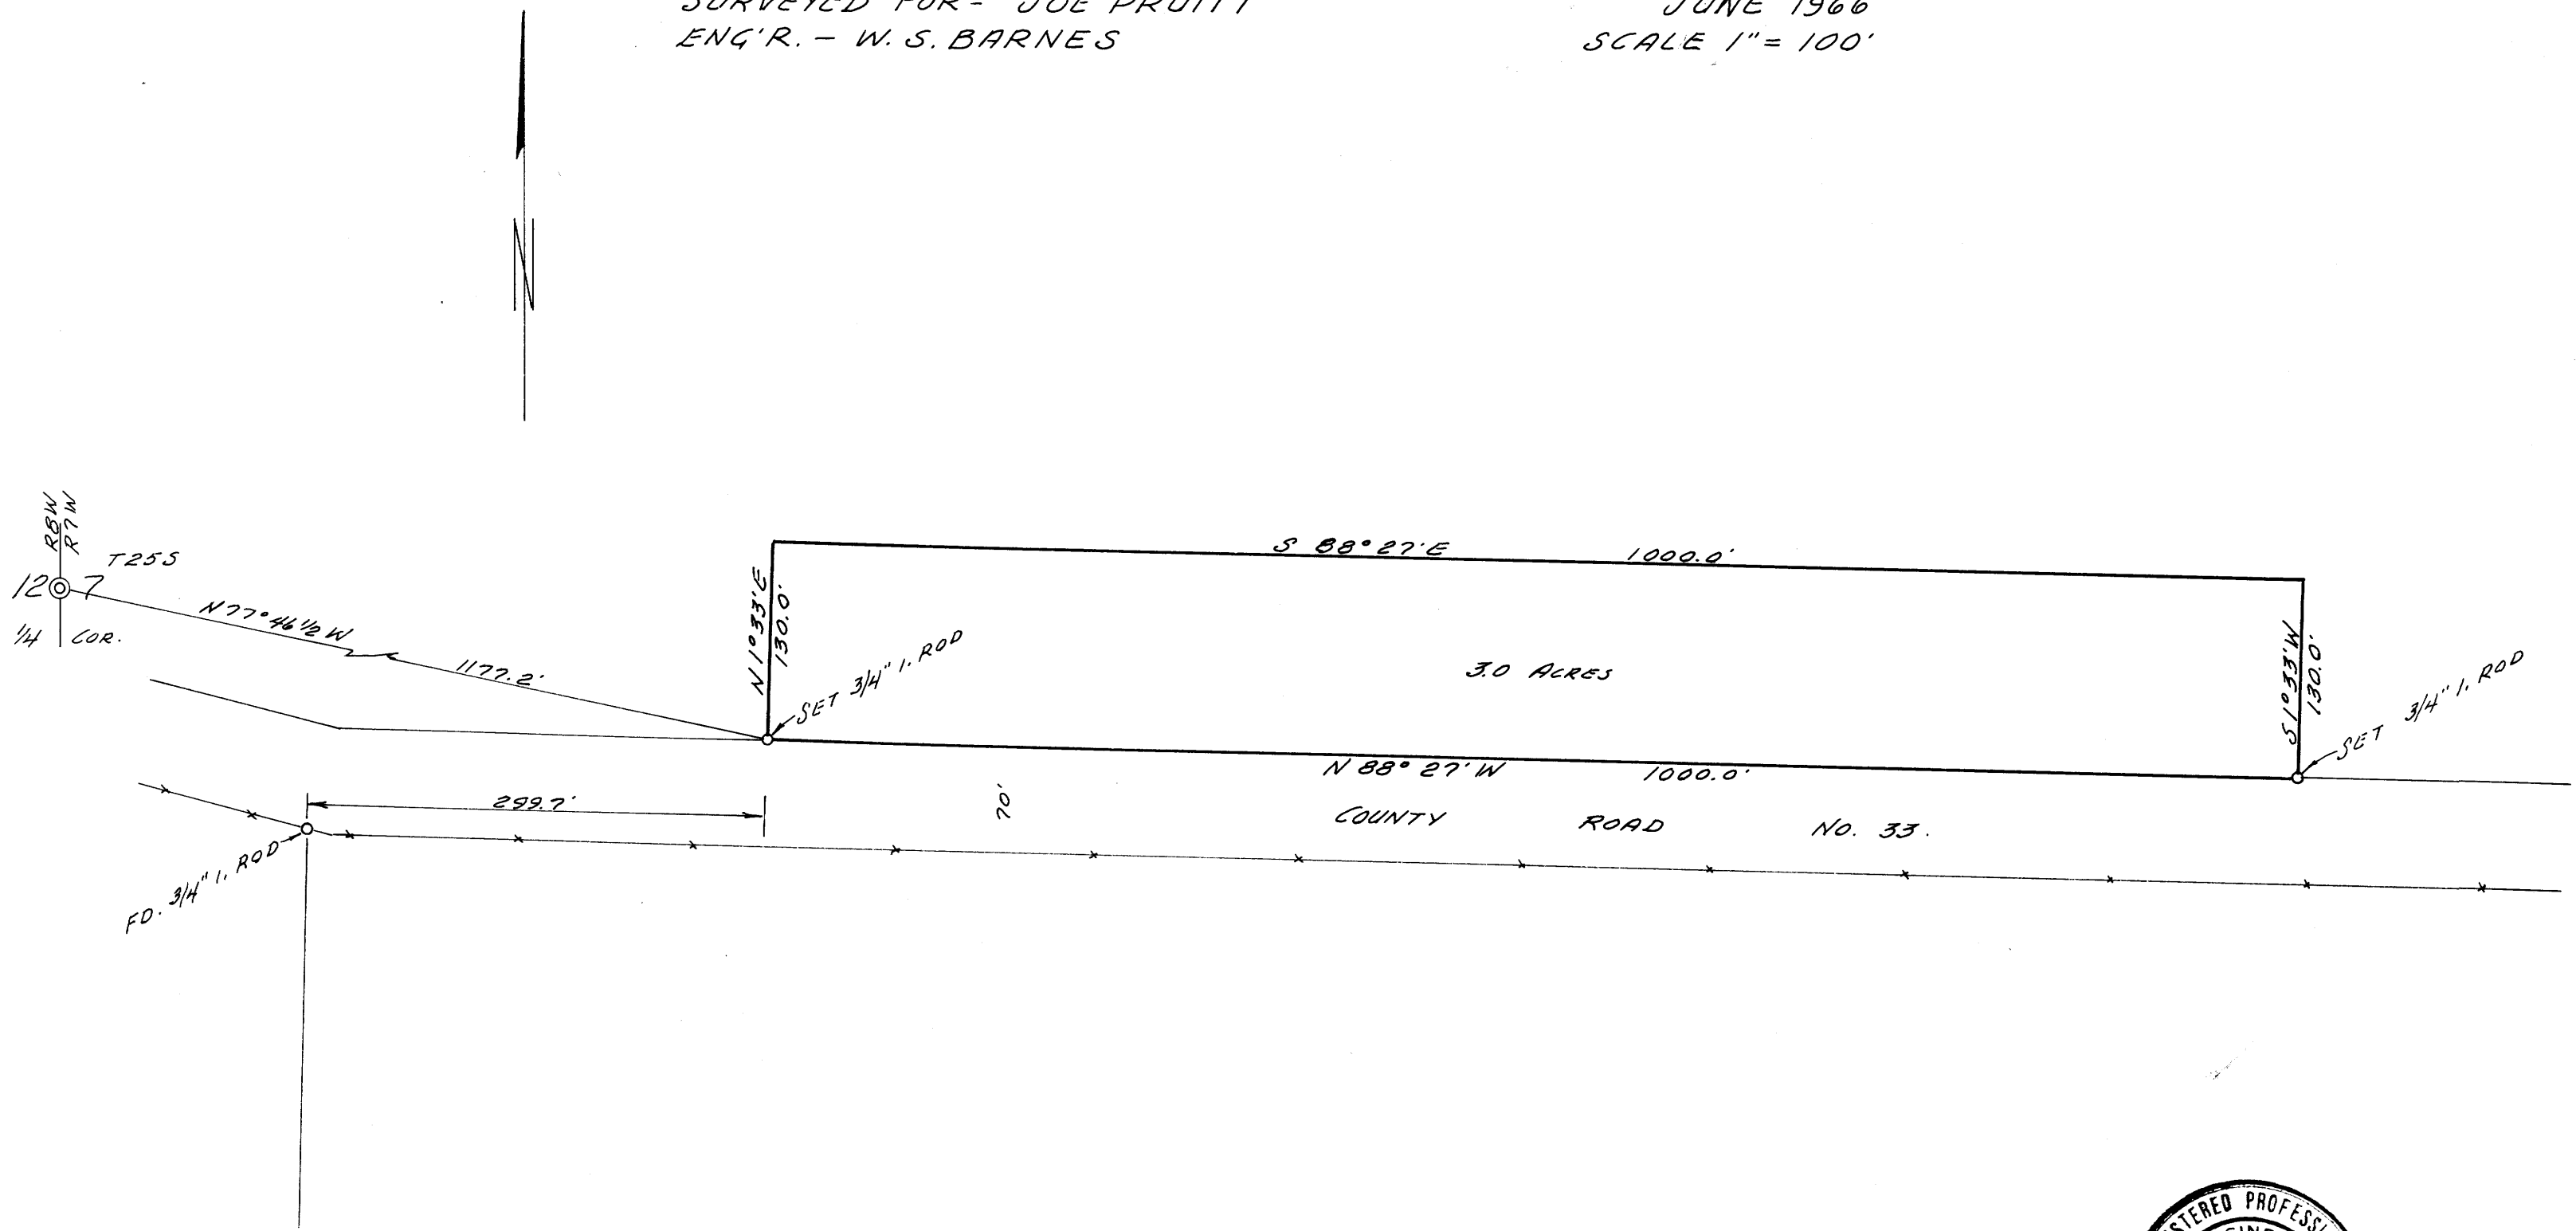

Note: Base bearing taken from Magnetic North.



FILED *LL*
RECEIVED

JUN 13 1966

COUNTY SURVEYOR
DOUGLAS COUNTY, ORE.

MAP FILE M 31 F 65

MAP FILE M 31 F 65