


COUNTY SURVEYORS FILE DATA
DO NOT REMOVE FROM OFFICE

SURVEY IN SECTION 16, T. 27 S., R. 6 W., W.M.
SURVEYED FOR TED SMALLE
SURVEYED BY R.H.GEE
JUNE, 1966
SCALE 1" = 50'

- DENOTES IRON ROD FOUND
- DENOTES 5/8" IRON ROD SET

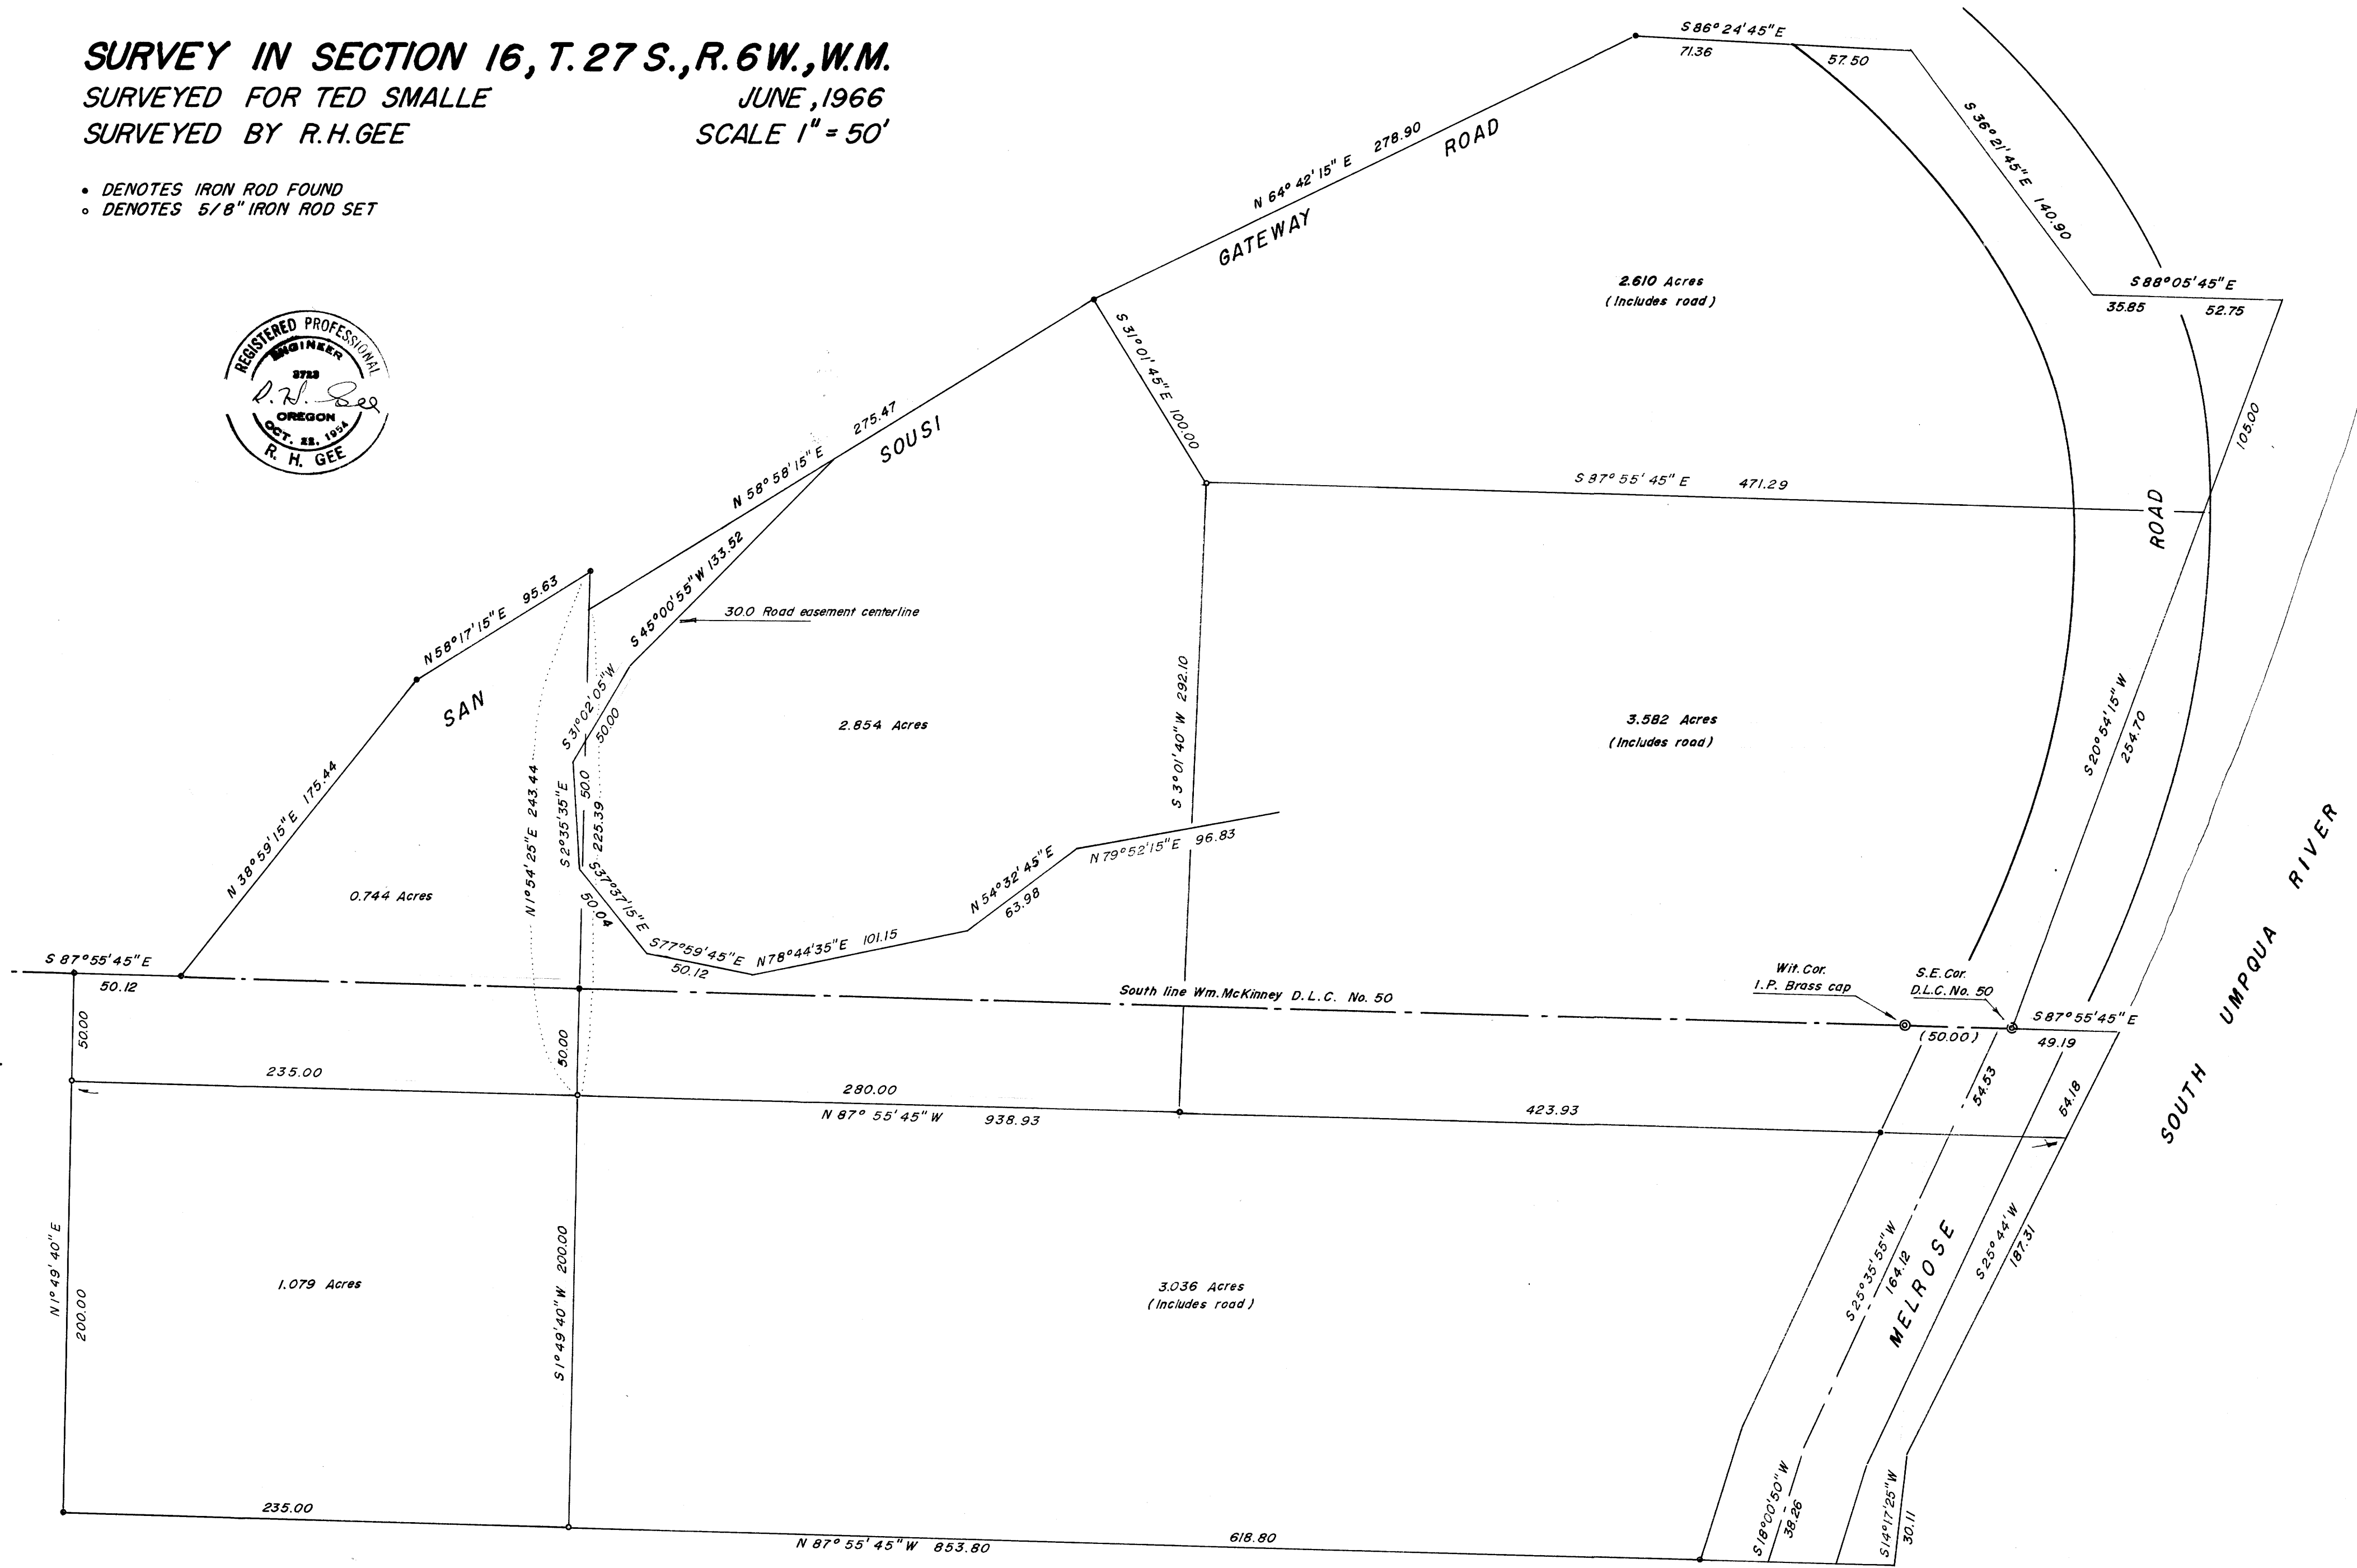

MAP FILE M 311-69
SEE ALSO C.S. 103-57

FILED
RECEIVED
JUN 20 1966
COUNTY SURVEYOR
DOUGLAS COUNTY, ORE.

FILE M 311-69