


SURVEY FOR PROPERTY DESCRIPTION  
 SEC. 3 T. 25 S. R. 5 W. W.M.  
 SURVEYED FOR RALPH BROWN  
 SURVEYED BY BAUGHMAN SURVEYING SERVICE  
 JAN., 1966 SCALE: 1" = 50'

COUNTY SURVEYORS FILE DATA  
 DO NOT REMOVE FROM OFFICE

REGISTERED  
 OREGON  
 LAND SURVEYOR  
*Glenn S. Baughman*  
 JULY 14, 1961  
 GLENN S. BAUGHMAN  
 536

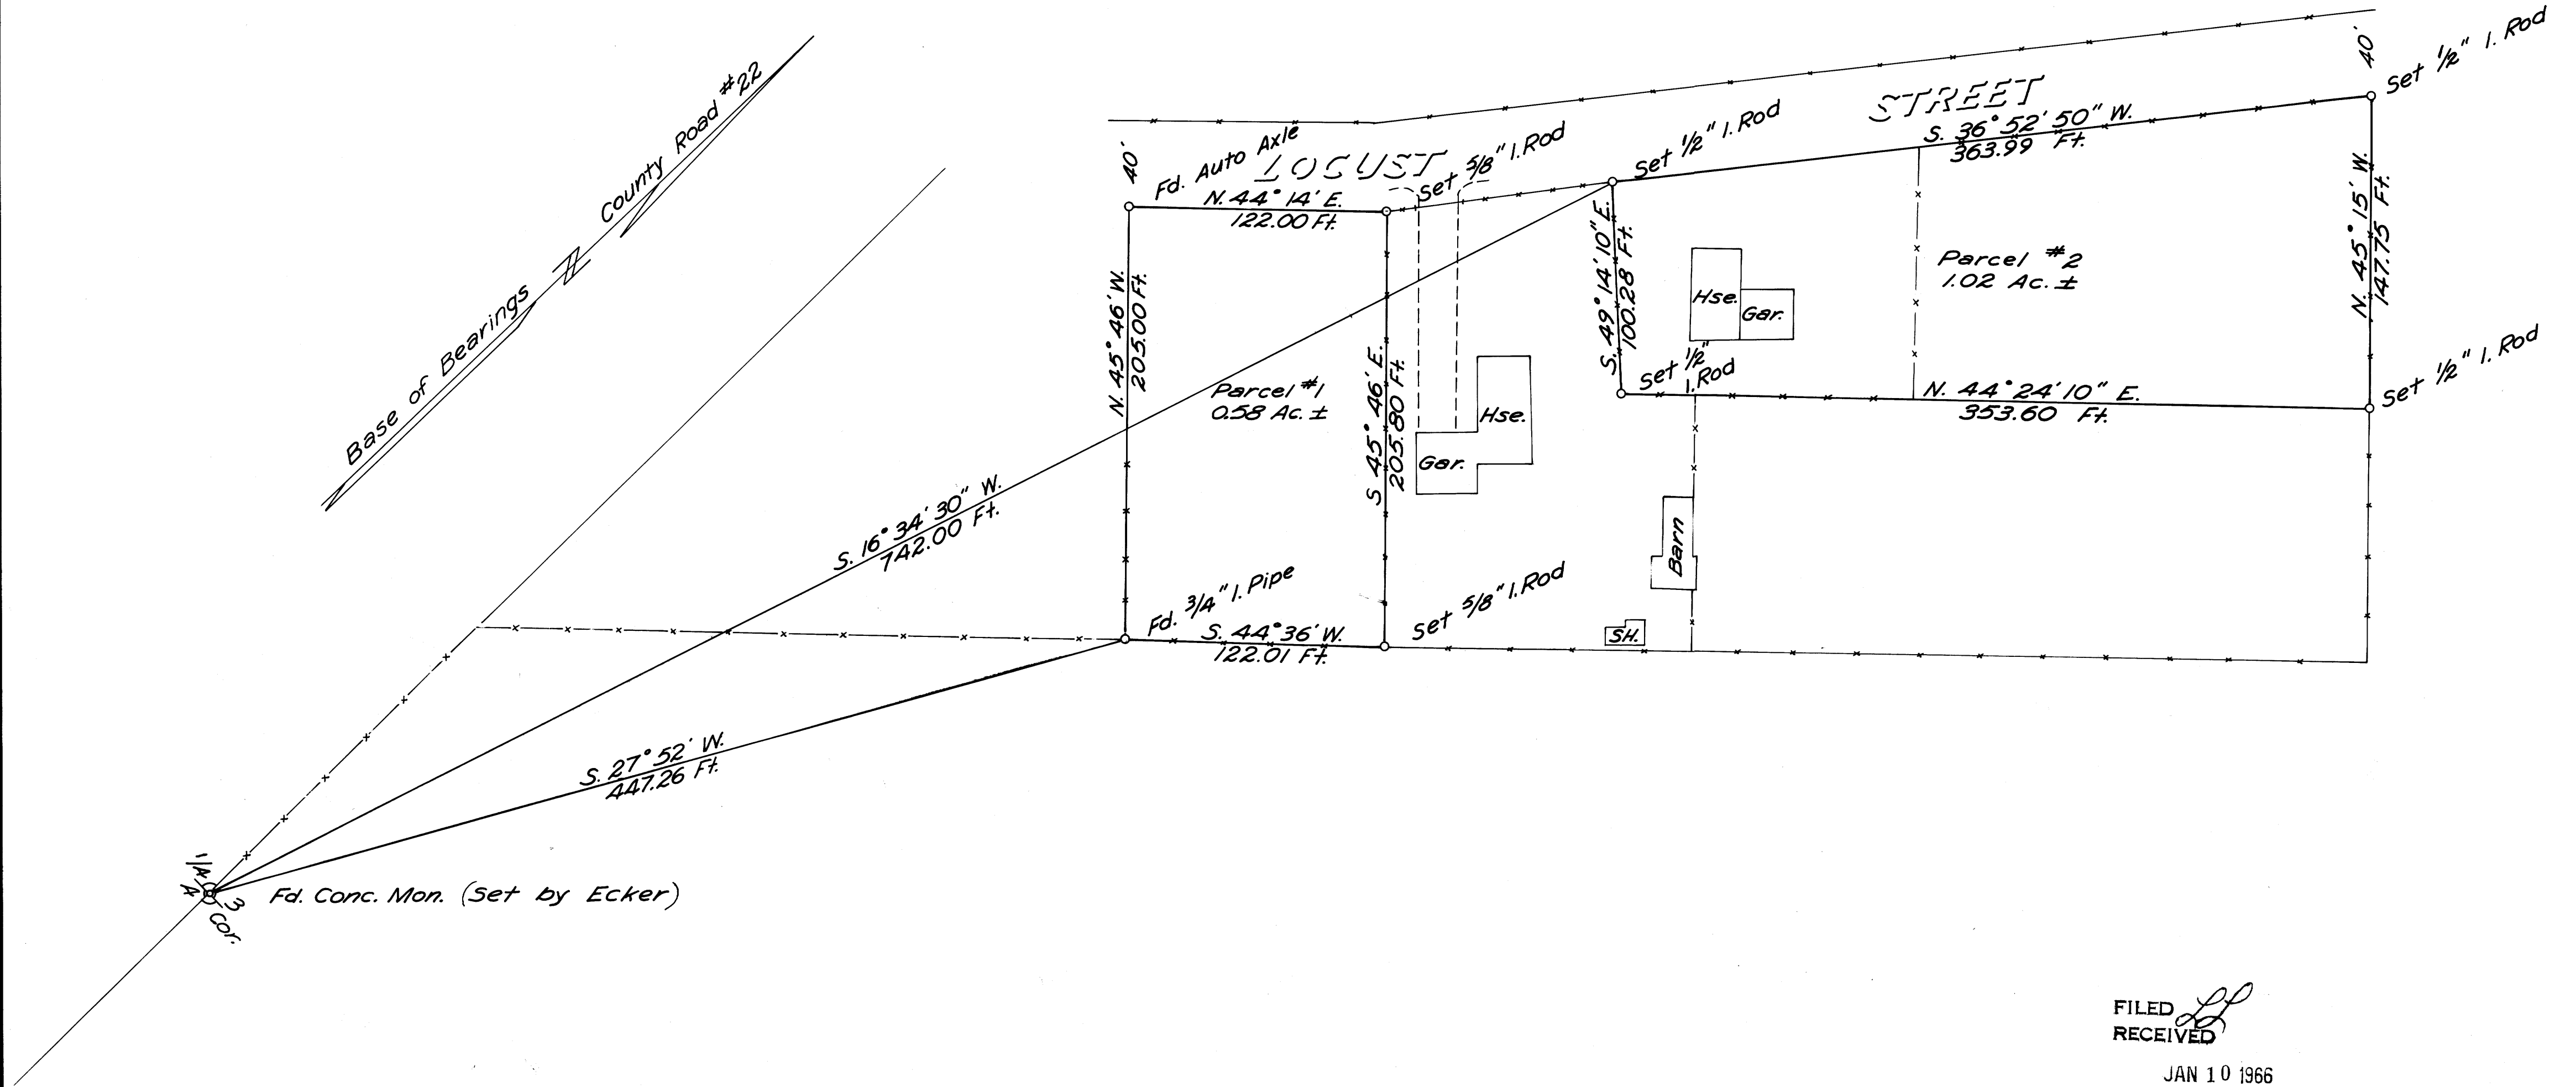

FILED *LL*  
 RECEIVED  
 JAN 10 1966  
 COUNTY SURVEYOR  
 DOUGLAS COUNTY, ORE.

FILE # 31-8

MAP FILE # 31-8