

INTERSTATE HIGHWAY NO.5

COUNTY SURVEYORS FILE DATA
DO NOT REMOVE FROM OFFICE

MAP OF SURVEY
LOCATED IN
LOTS 1, 2 AND 3, BLOCK 12 AND
LOTS 3, 7 AND 8, BLOCK 9 OF THE
CITY OF CANYONVILLE
DOUGLAS COUNTY, OREGON
FOR
GORDON HARRY, CLYDE MARRIOTT & TEXACO, INC.

FILED *LL*
RECEIVED
AUG 29 1966
COUNTY SURVEYOR
DOUGLAS COUNTY, ORE.

REGISTERED
OREGON
LAND SURVEYOR
J. A. Hoffbuhr
NOVEMBER 7, 1947
J. A. HOFFBUHR
222

J. A. HOFFBUHR, REG. L. S., MEDFORD, OREGON
SCALE 1"=50'
BASIS OF BEARING - COUNTY SURVEYORS FILE 40/104
ALL MONUMENTS FOUND AND SET ARE SHOWN AS SUCH ON MAP

P. Page 9 Canyonville
C.S. FILE. 55/13
MAP FILE M.327-15

Survey Narrative To Comply With Paragraph 209.250
Oregon Revised Statutes

SURVEY FOR: Gordon Harry, Canyonville, Oregon
and
Clyde Marriott, Canyonville, Oregon
and
Texaco, Inc., Attention: J.C. Brookman,
255 California Street, San Francisco, California

LOCATION: (Gordon Harry) Tract situated in Lot 3, Block 9;
(Clyde Marriott) tract situated in Lots 7 and 8,
Block 9; and (Texaco, Inc.) tract situated in
Lots 1, 2 and 3, Block 12; all within the City of
Canyonville, Douglas County, Oregon.

PURPOSE: To monument the corners of the tracts as shown
on the attached map.

PROCEDURE: Center line controls were developed on Pine
Street, Main Street, and Third, Fourth and Fifth Streets as indicated
from the survey bearings, distances and survey monuments established
by Baker in 1948 (Recorded Survey No. 40/104 Douglas County Surveyors
Office), the center line of Wall Street could not be retraced,
therefore Baker's distances and bearings were used to obtain pro-
portional measurements. All lots were set by proportional measure-
ments after the street widths were deducted. A variance was found
in the Oregon State Highway Department right of way monuments, as
indicated on the attached map.


August 18, 1966

FILED *LL*
RECEIVED

AUG 29 1966

COUNTY SURVEYOR
DOUGLAS COUNTY, ORE.

J.A. Hoffbuhr
Registered Land Surveyor

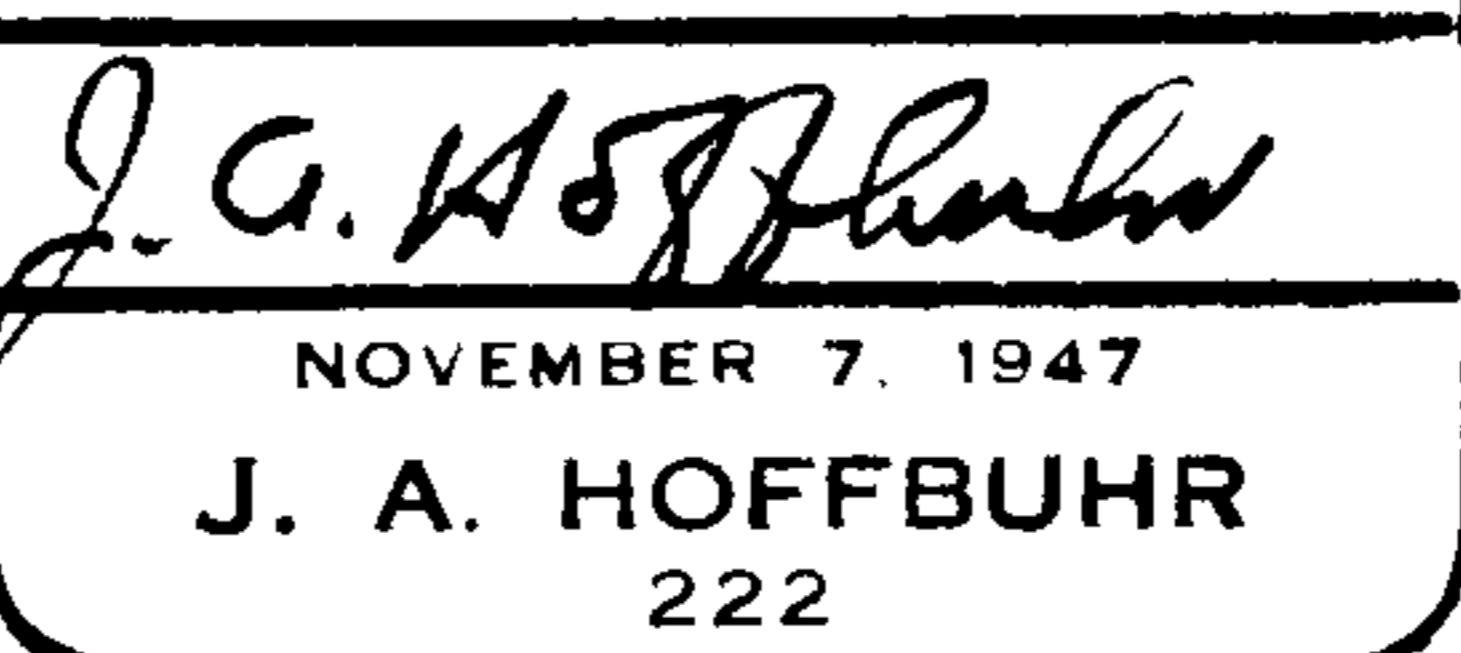

C.S. File 55/13

Map File M32T-15