


COUNTY SURVEYORS FILE DATA  
DO NOT REMOVE FROM OFFICE

**SURVEY FOR DEED DESCRIPTIONS  
IN SEC. 28 & 29, T28S, R6W, W.M.**  
ENGINEER - W.S. BARNES      SCALE 1"=200'      AUG. 1966  
SURVEYED FOR - PAUL HULT.

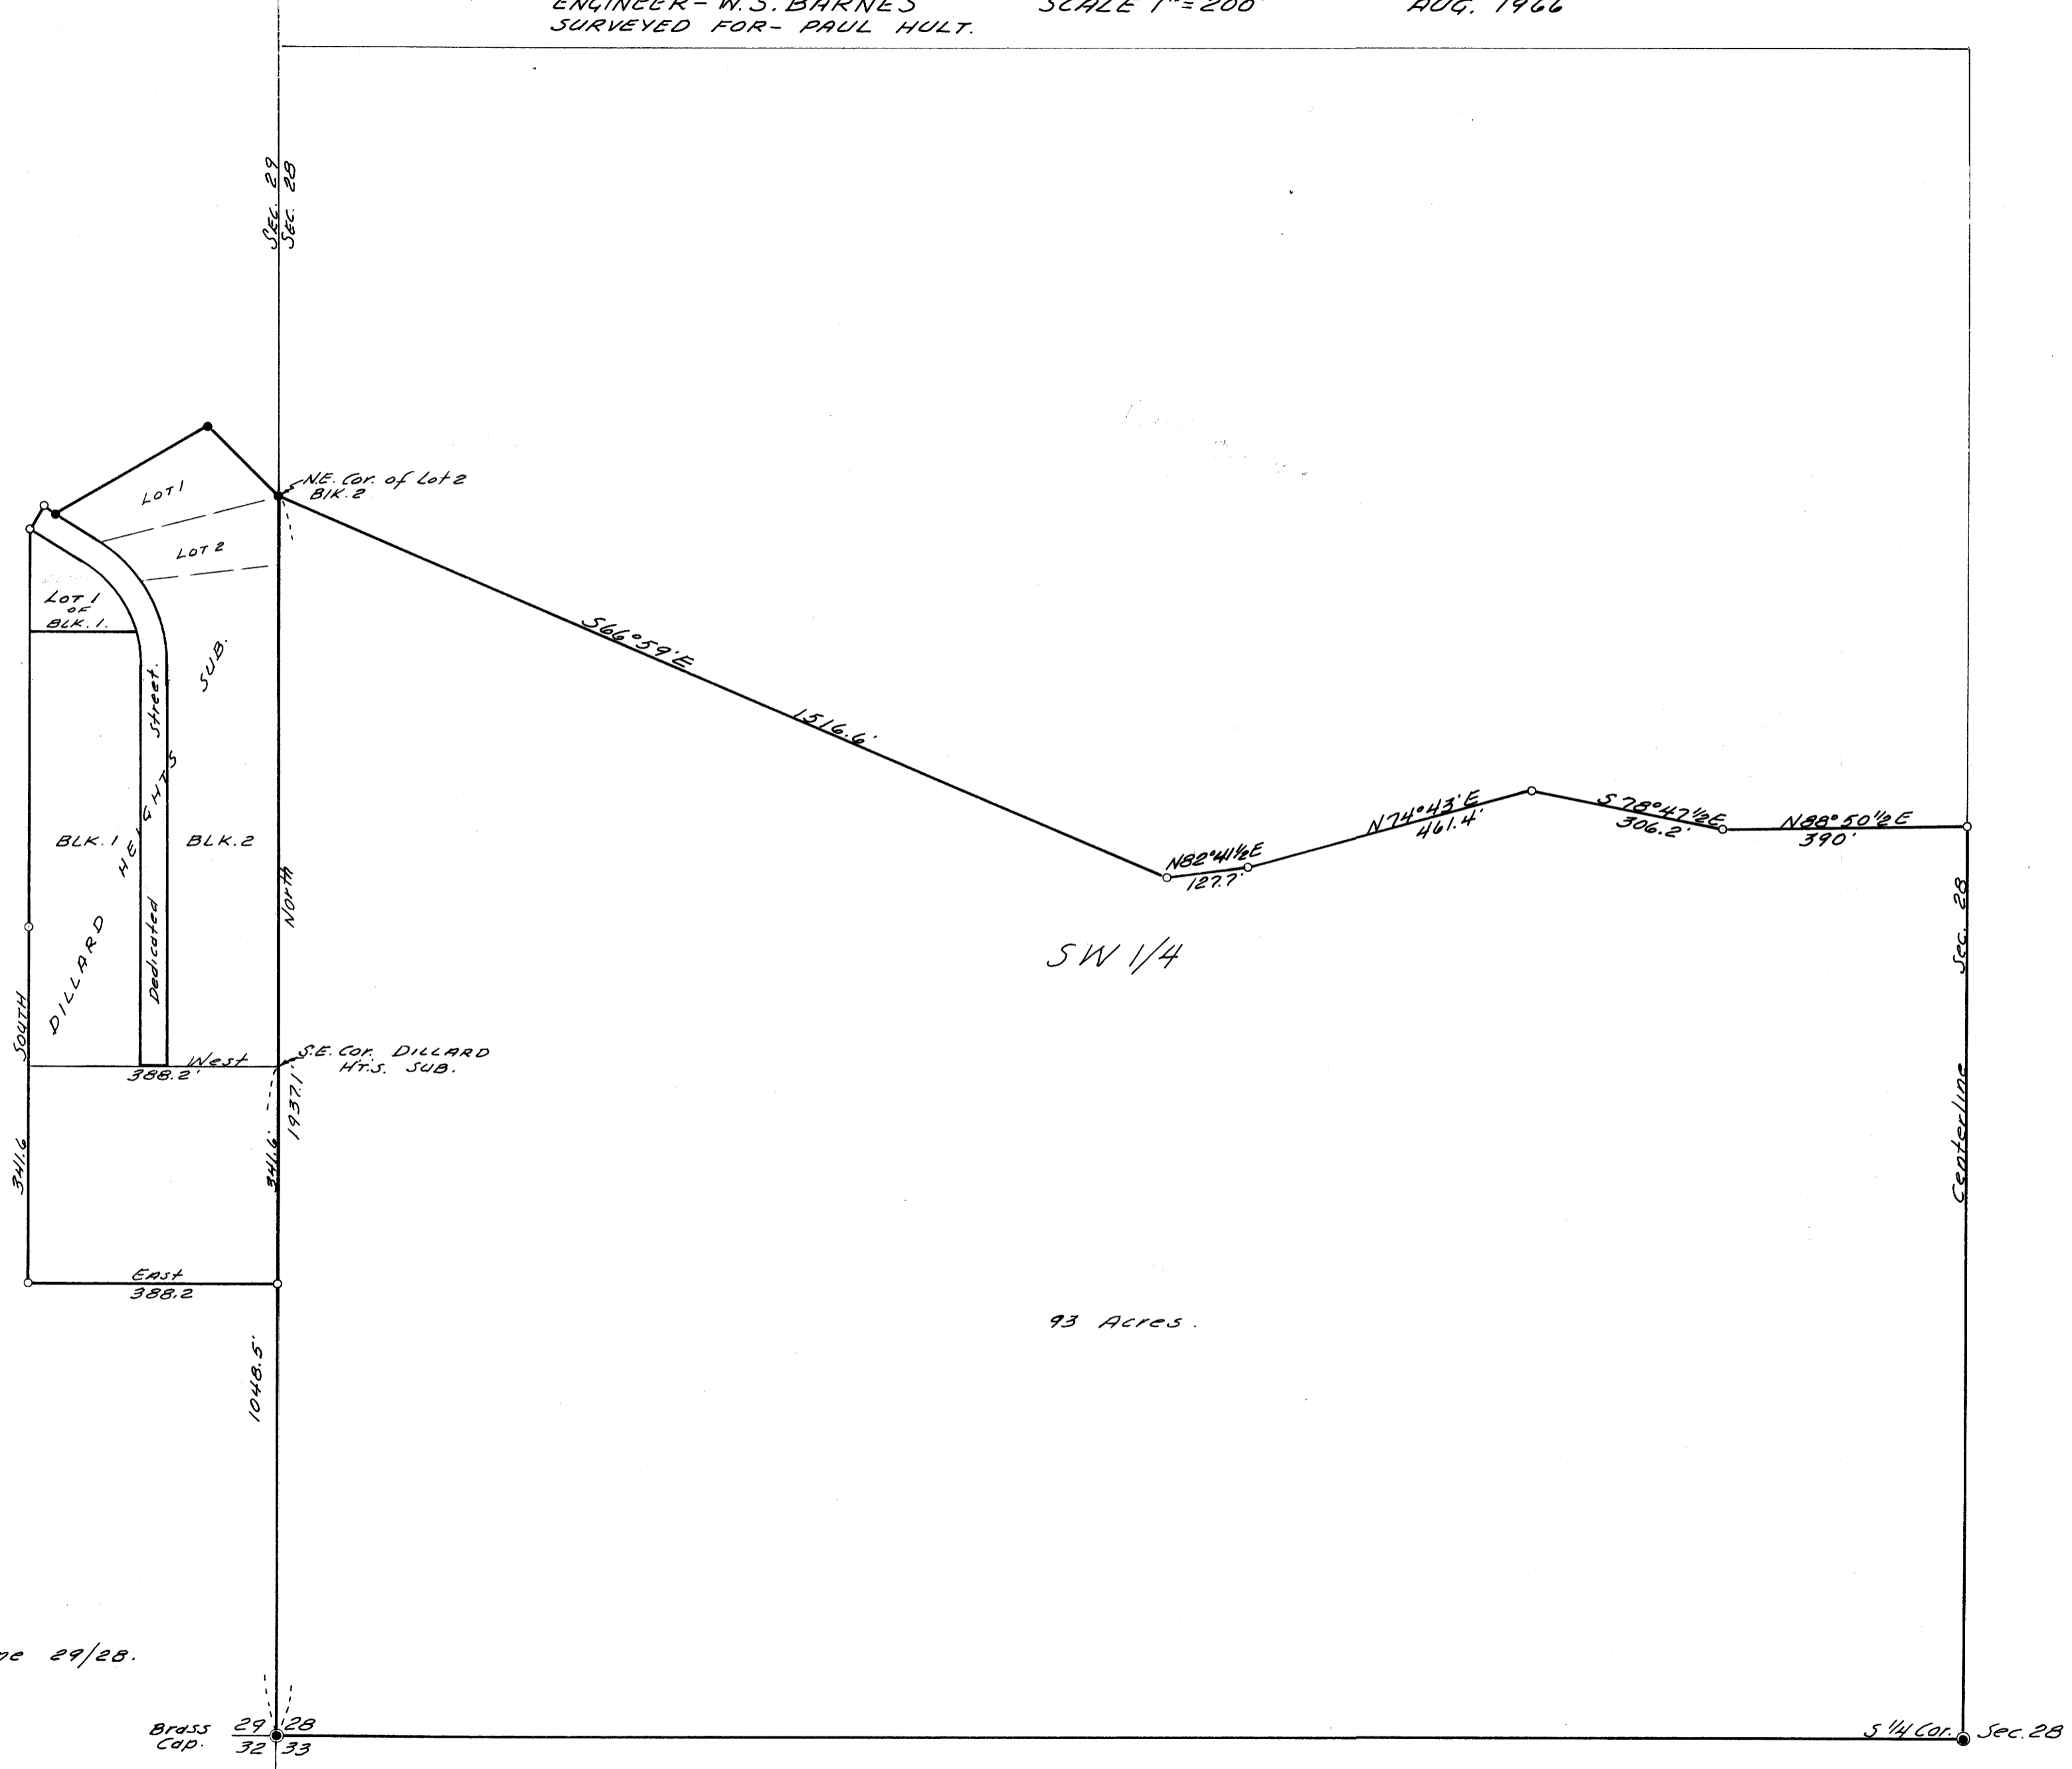

- Denotes monuments found.
- Denotes 3/4" iron rods set.

Base bearing taken from sec. line 29/28.



FILED  
RECEIVED  
SEP 19 1966  
COUNTY SURVEYOR  
DOUGLAS COUNTY, ORE.

MAP FILE M32 P 20

MAP FILE M32 P 20