
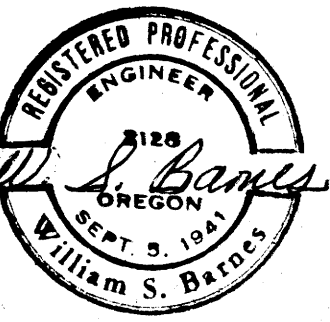


COUNTY SURVEYORS FILE DATA
DO NOT REMOVE FROM OFFICE

SURVEY FOR DEED DESCRIPTION IN
JACOB JONES D.L.C. NO. 43.
T. 27 S., R. 6. W. W.M. DOUGLAS CO., ORE.
SURVEYED FOR - OTIS CLAYTON
SURVEYED BY - W.S. BARNES

SEPT. 1966
SCALE 1" = 100'

L. Sig. & Phillis M. Wolf.

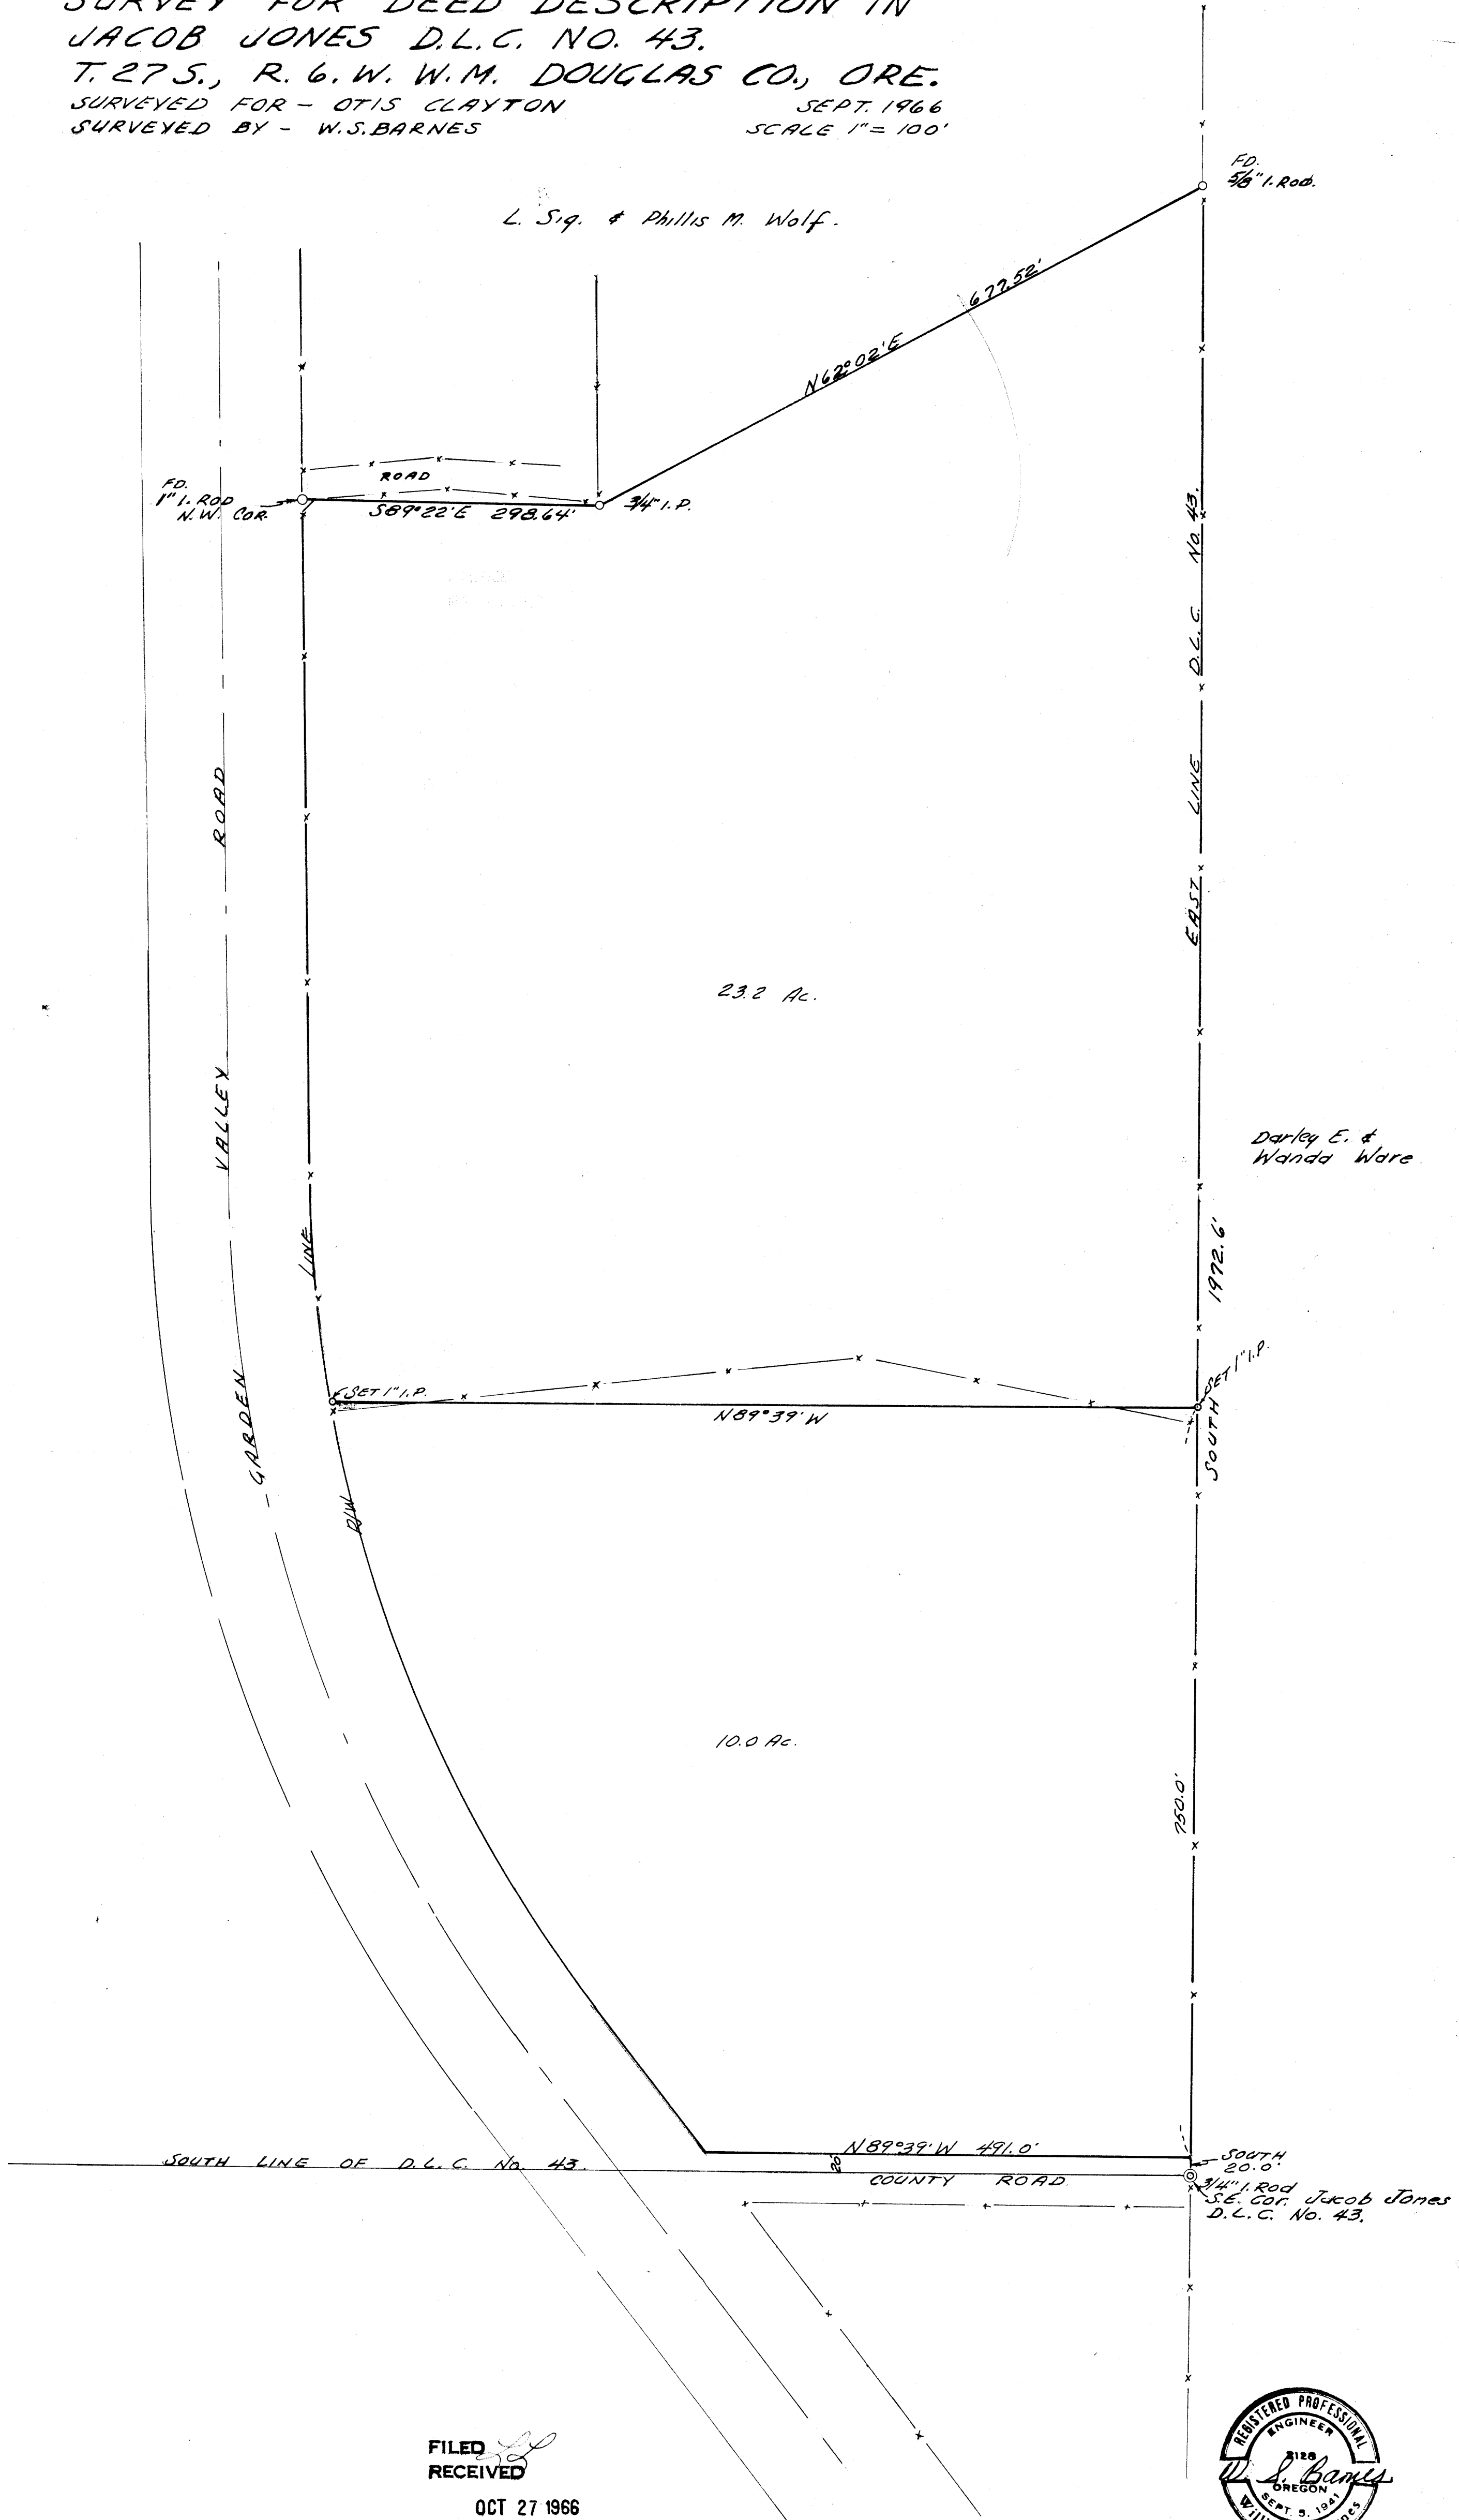

FILED
RECEIVED
OCT 27 1966
COUNTY SURVEYOR
DOUGLAS COUNTY, ORE.