

COUNTY SURVEYORS FILE DATA
DO NOT REMOVE FROM OFFICE


SURVEY IN SECTION 16, T.27 S., R.6 W., W.M.
SURVEYED FOR TED SMALLE
SURVEYED BY R. H. GEE
JUNE, 1966
SCALE 1" = 50'

- DENOTES IRON ROD FOUND
- DENOTES 5/8" IRON ROD SET

FILED
RECEIVED


JAN 19 1967

COUNTY SURVEYOR
DOUGLAS COUNTY, ORE.

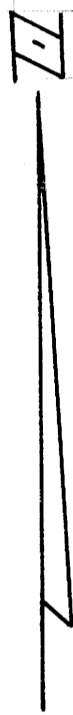

BEARINGS BASED ON
SOLAR OBSERVATION

SOUTH
2966.83
17 16
20 21

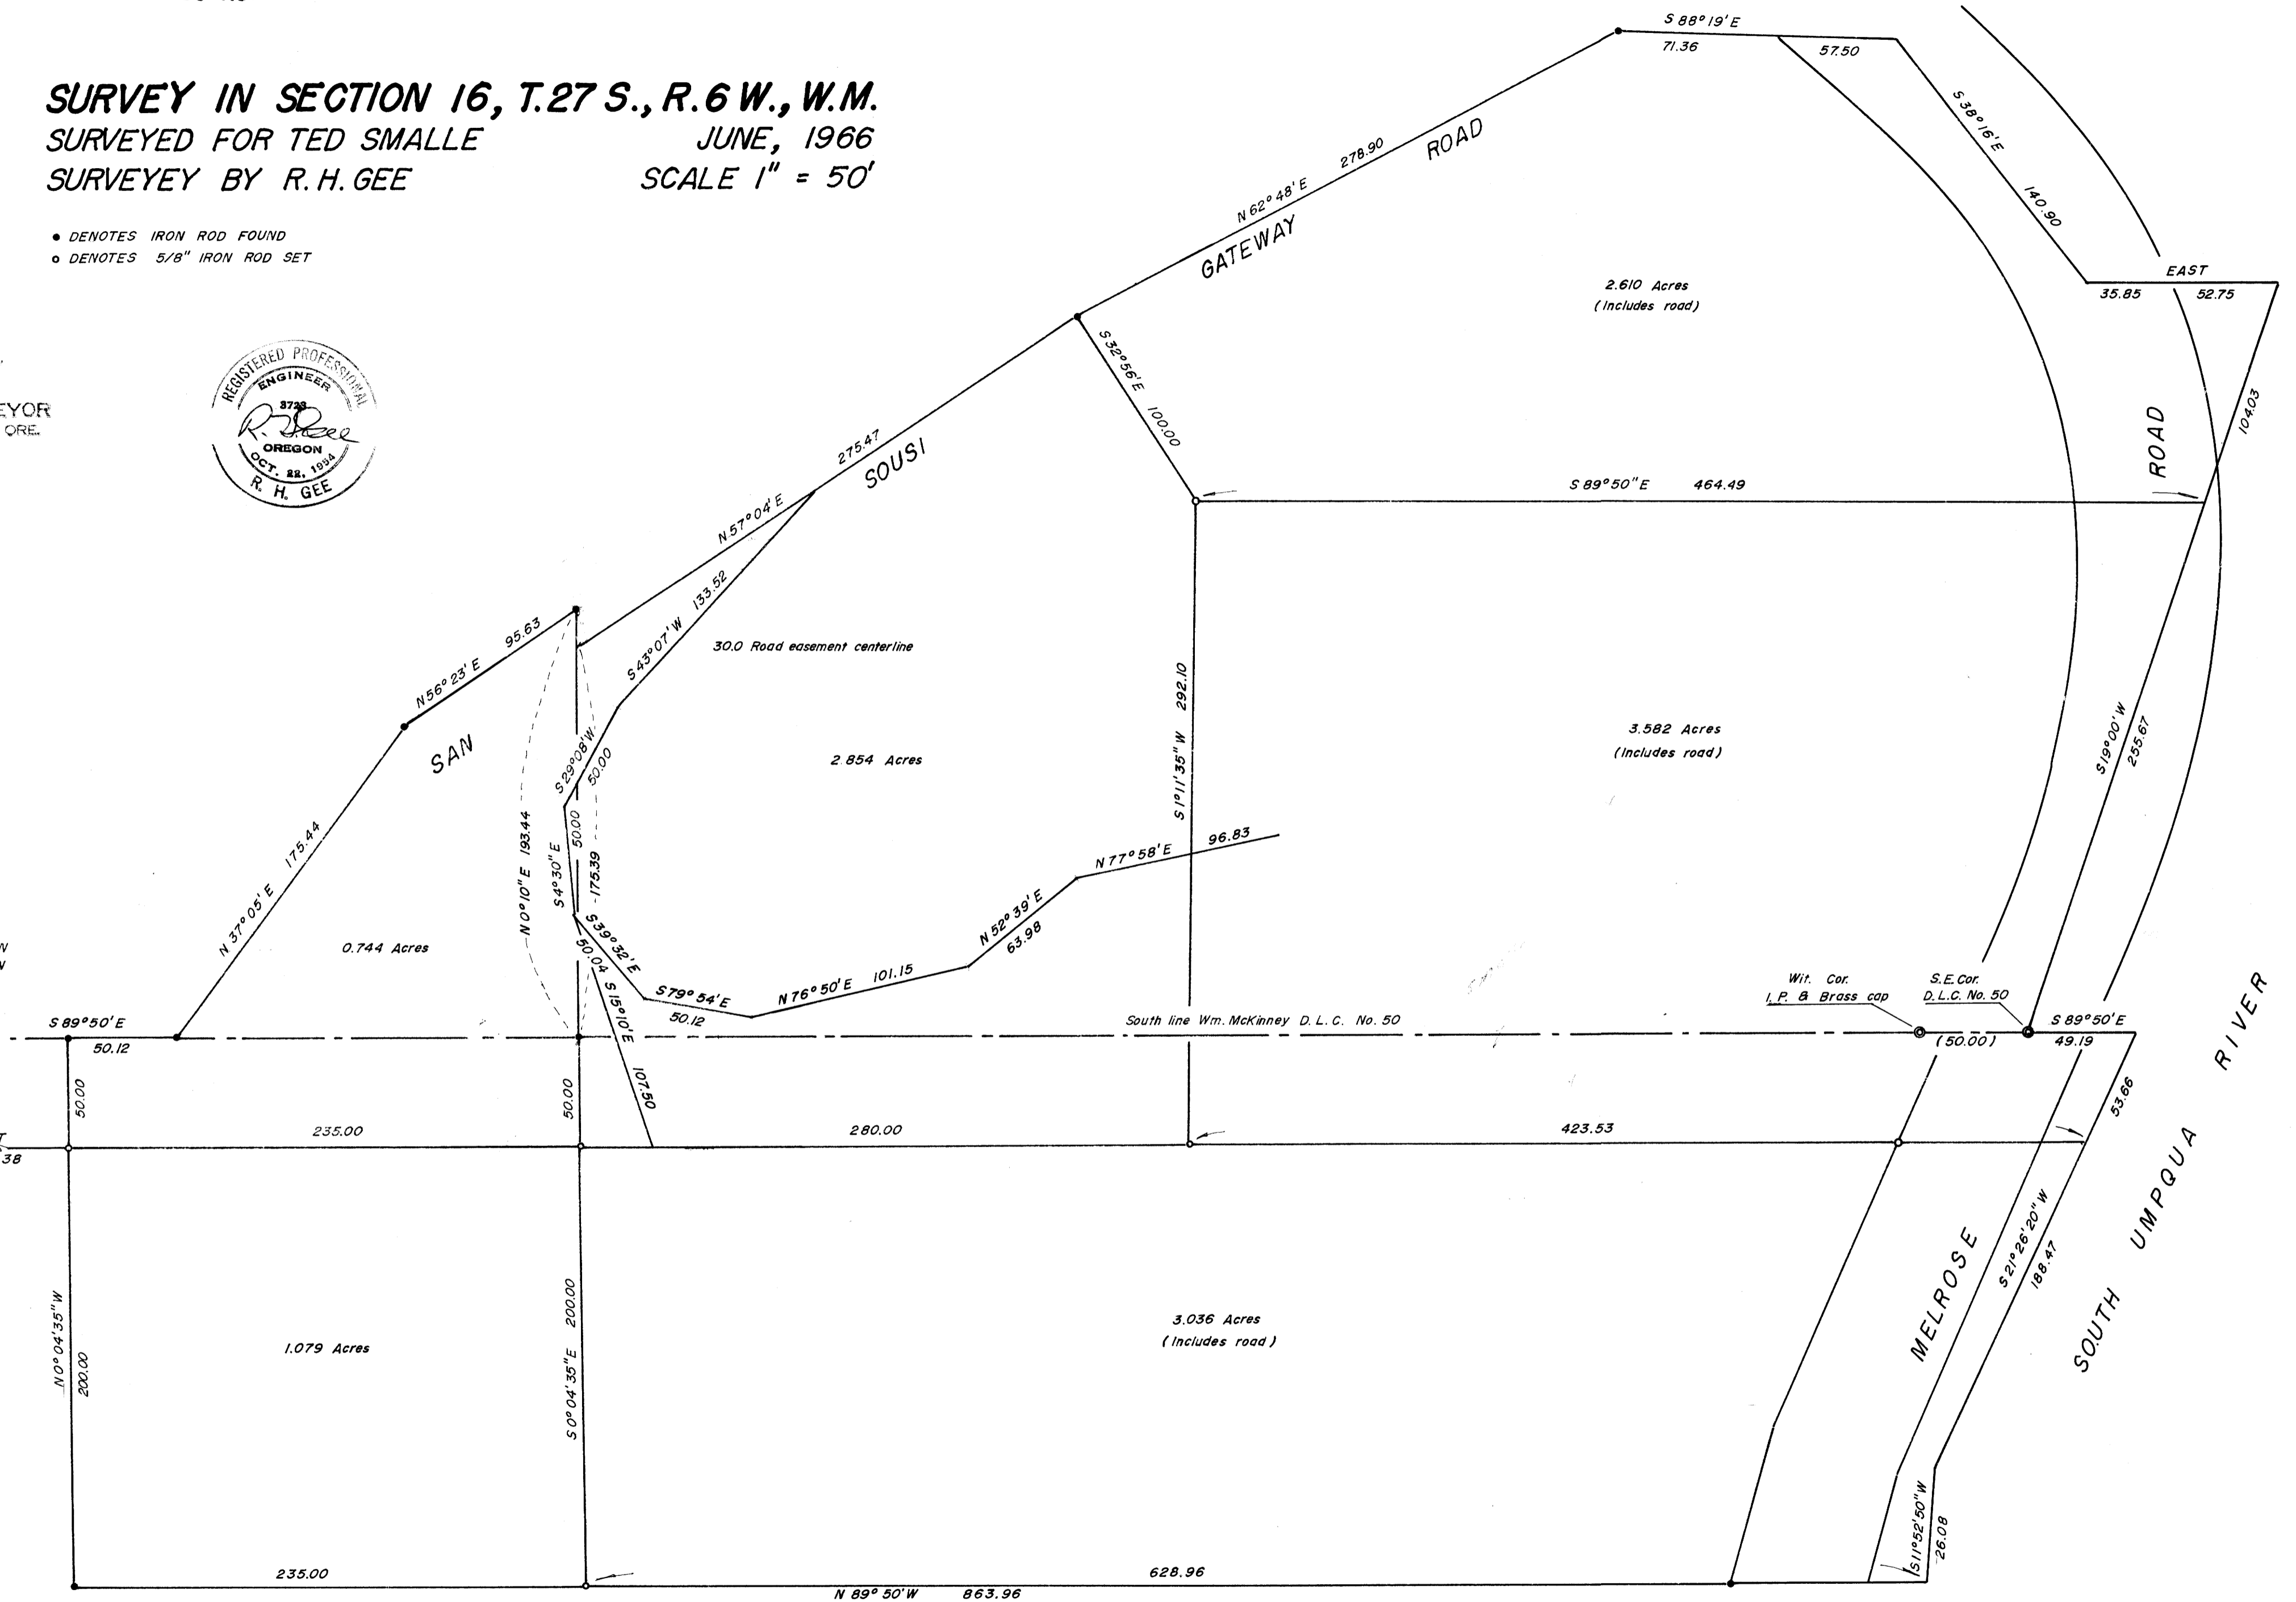

MAP FILE M.32-51

SEE ALSO M.32-51

MAP FILE M.32-51