

22 23 Brass Cap Found
 27 26 20° Fir S. 39° E. 45.0
 17° Cedar S. 7° W. 54.8
 19° Cedar N. 56° E. 100.0

N. 88° 42' W. 2728.8

1364.4

Set 3/4 I.P.
 10° Maple N. 56° 48' W. 16.0
 14° Yew S. 70° 02' W. 37.2

1364.4

Found Brass Cap
 27° Fir S. 64° E. 48.7
 26° Fir N. 56° 30' E. 66.0

517.5

1352.8

N. 88° 56' W. 2705.7

676.4
 37° Fir N. 66° 15' E. 39.6

1352.8

3/4 I.P.
 6° Madrona N. 6° 10' E. 9.4
 4° Cedar N. 50° 58' E. 8.0

16° Cedar N. 11° E. 62.0
 12° Madrona N. 6° W. 20.1
 10° Cedar S. 32° 30' W. 93.4
 Found Brass Cap

23 24
 26 25

40.28 Ac.

12.25 Ac.

16.24 Ac.


VIEW LANE

VIEW

HIGHWAY

NO. 227

Center Umpqua River

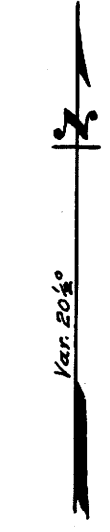

FILED RECEIVED
 MAR 6 1967
 COUNTY SURVEYOR
 DOUGLAS COUNTY, ORE.

COUNTY SURVEYOR'S OFFICE
 DOUGLAS COUNTY, OREGON.
 SURVEY FOR
 FRANCIS SINCOMB, SEC. 26, T. 30S, R. 3W.
 Geo. J. Wenderoth, Deputy, Mar. 1967.
 Scale 1" = 200 ft.

REGISTERED
 OREGON
 LAND SURVEYOR
 George J. Wenderoth
 MARCH 10, 1944
 George J. Wenderoth
 5

COUNTY SURVEYORS FILE DATA
 DO NOT REMOVE FROM OFFICE

MAP FILE M 32 67

MAP FILE M 32 67