

COUNTY SURVEYORS FILE DATA
DO NOT REMOVE FROM OFFICE


SURVEY OF

ROLLING HILLS MOTEL IN LOT 4 DIXONS ADDITION

For Wayne Johnson Investments

March 17, 1967

Scale: 1" = 50'

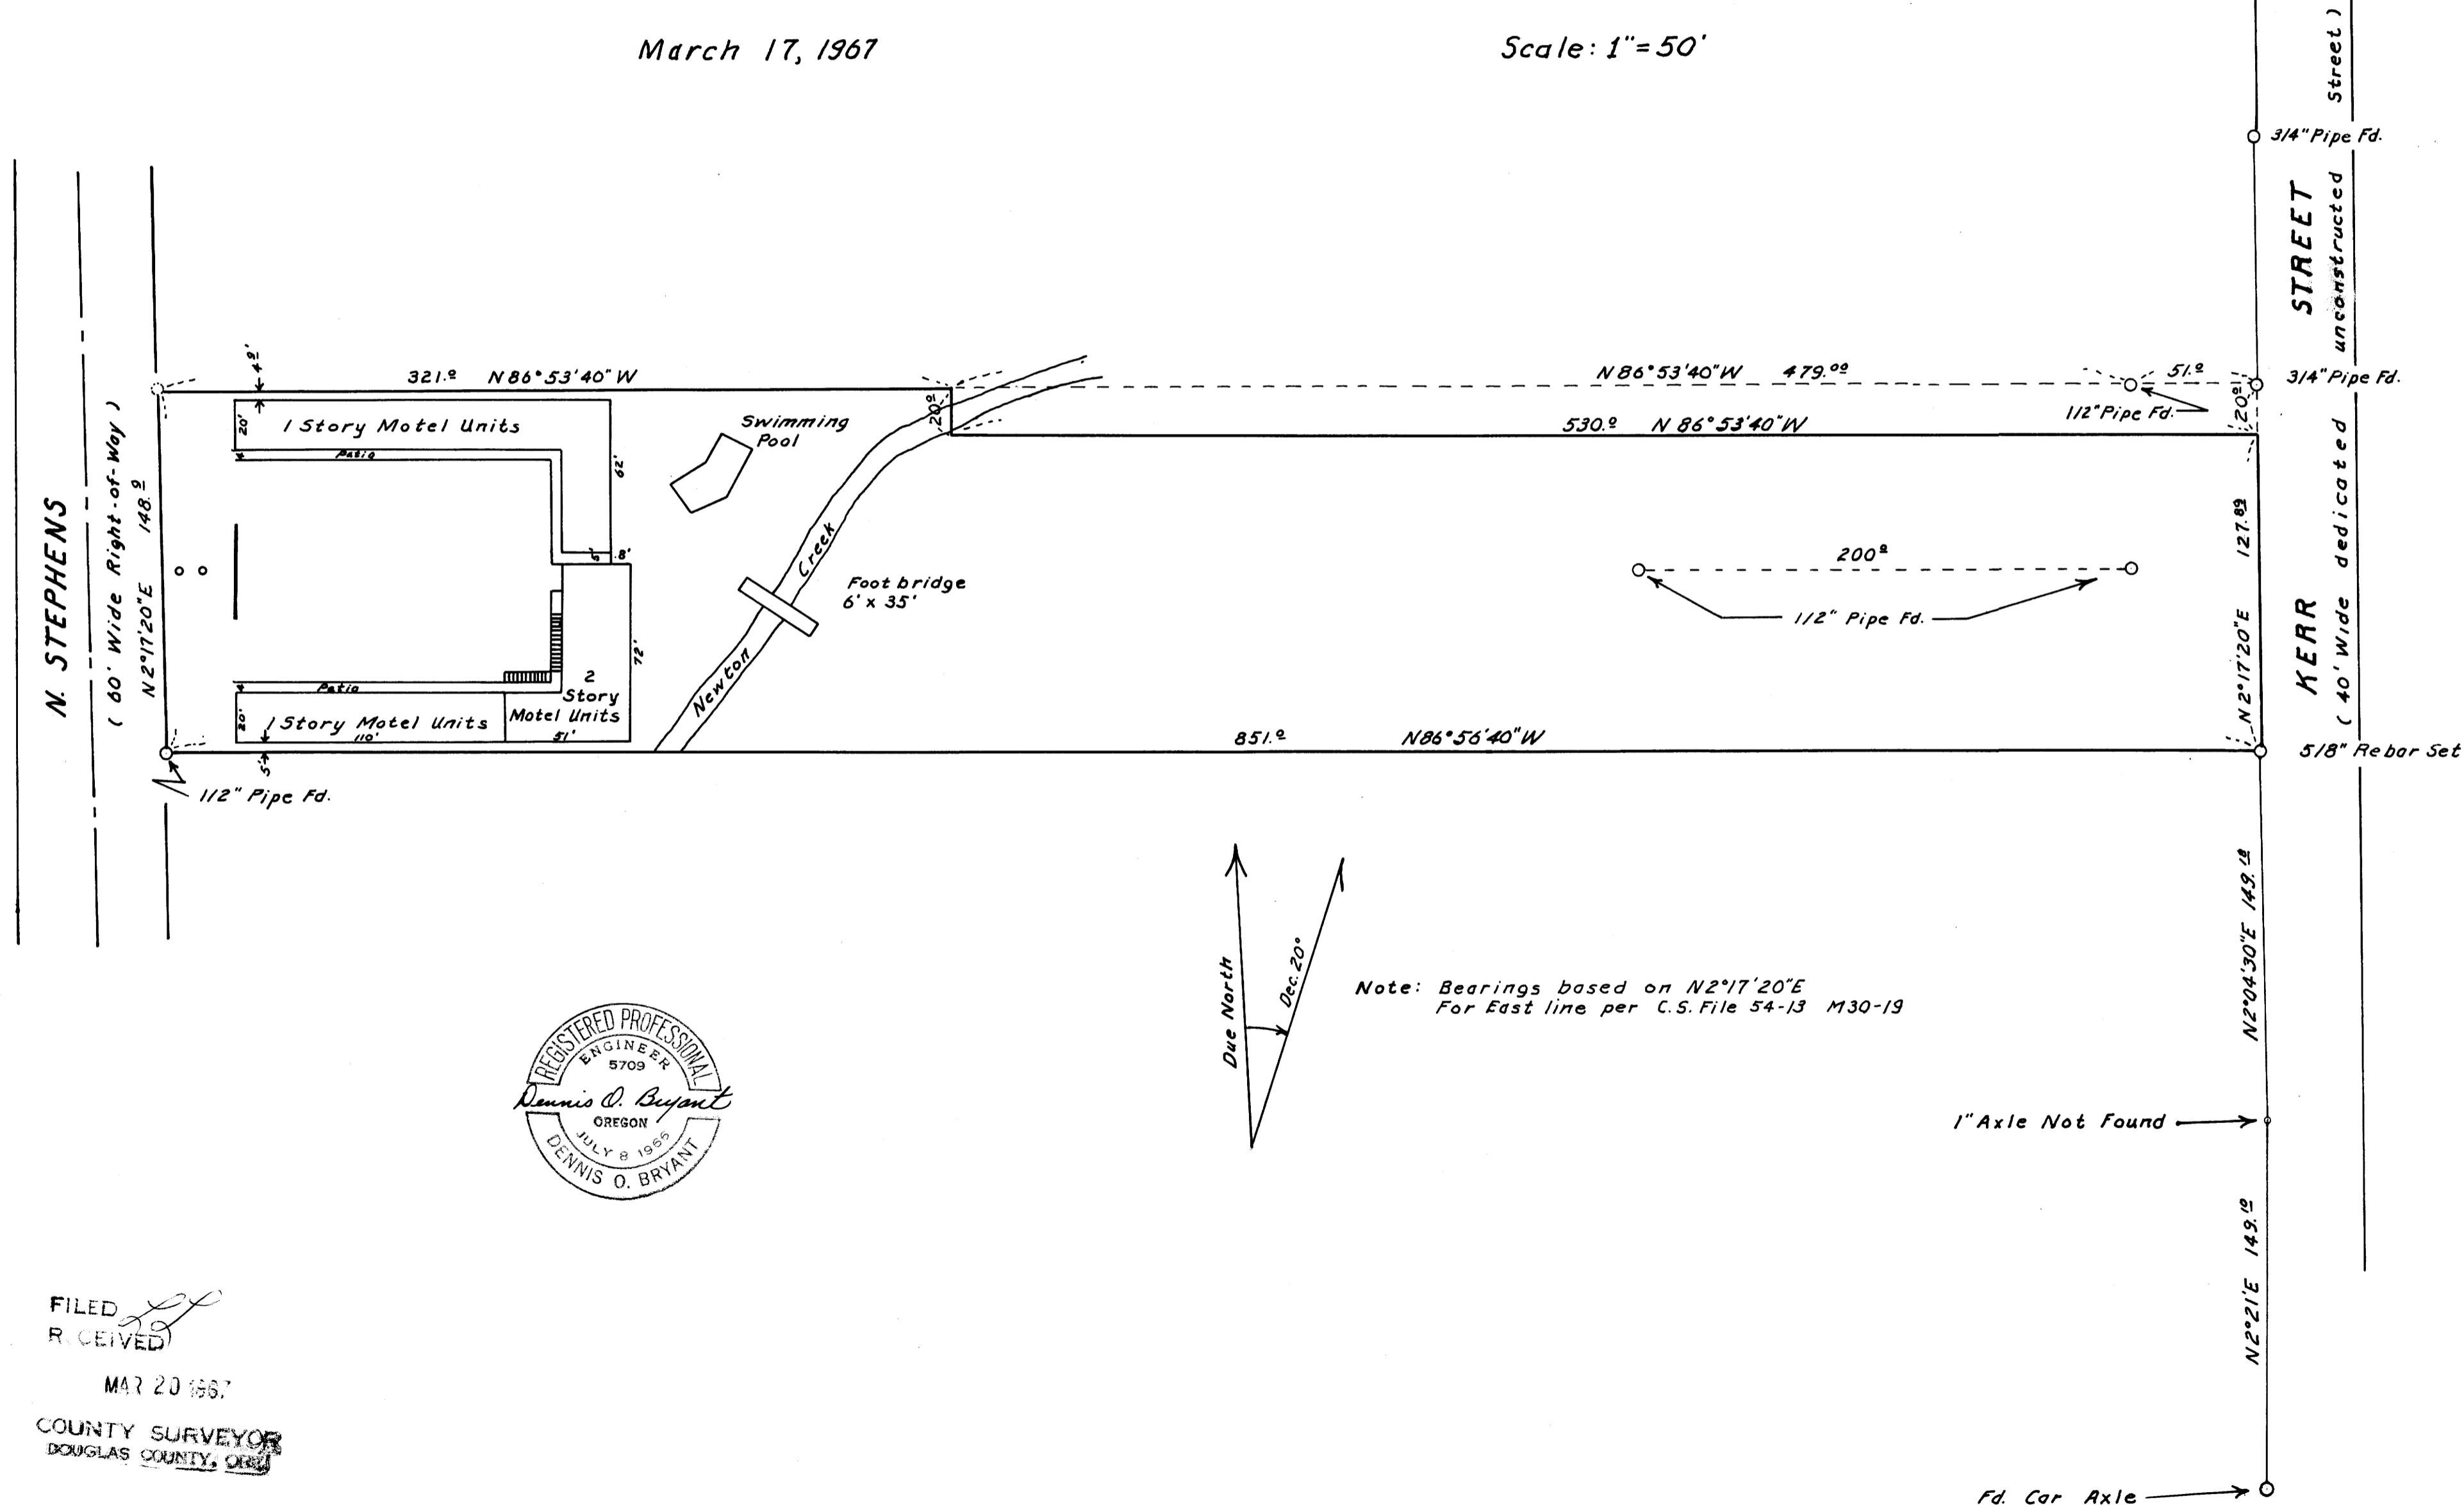

MAP FILE M32-1-67

MAP FILE M32-1-67