


SURVEY FOR DEED DESCRIPTION
IN JACOB JONES D.L.C. NO. 43
T.27S., R.6W. W.M. DOUGLAS CO., ORE.

SURVEYED FOR - O.E. CLAYTON
SURVEYED BY - W.S. BARNES

MAR. 1967
SCALE 1" = 100'

COUNTY SURVEYORS FILE DATA
DO NOT REMOVE FROM OFFICE

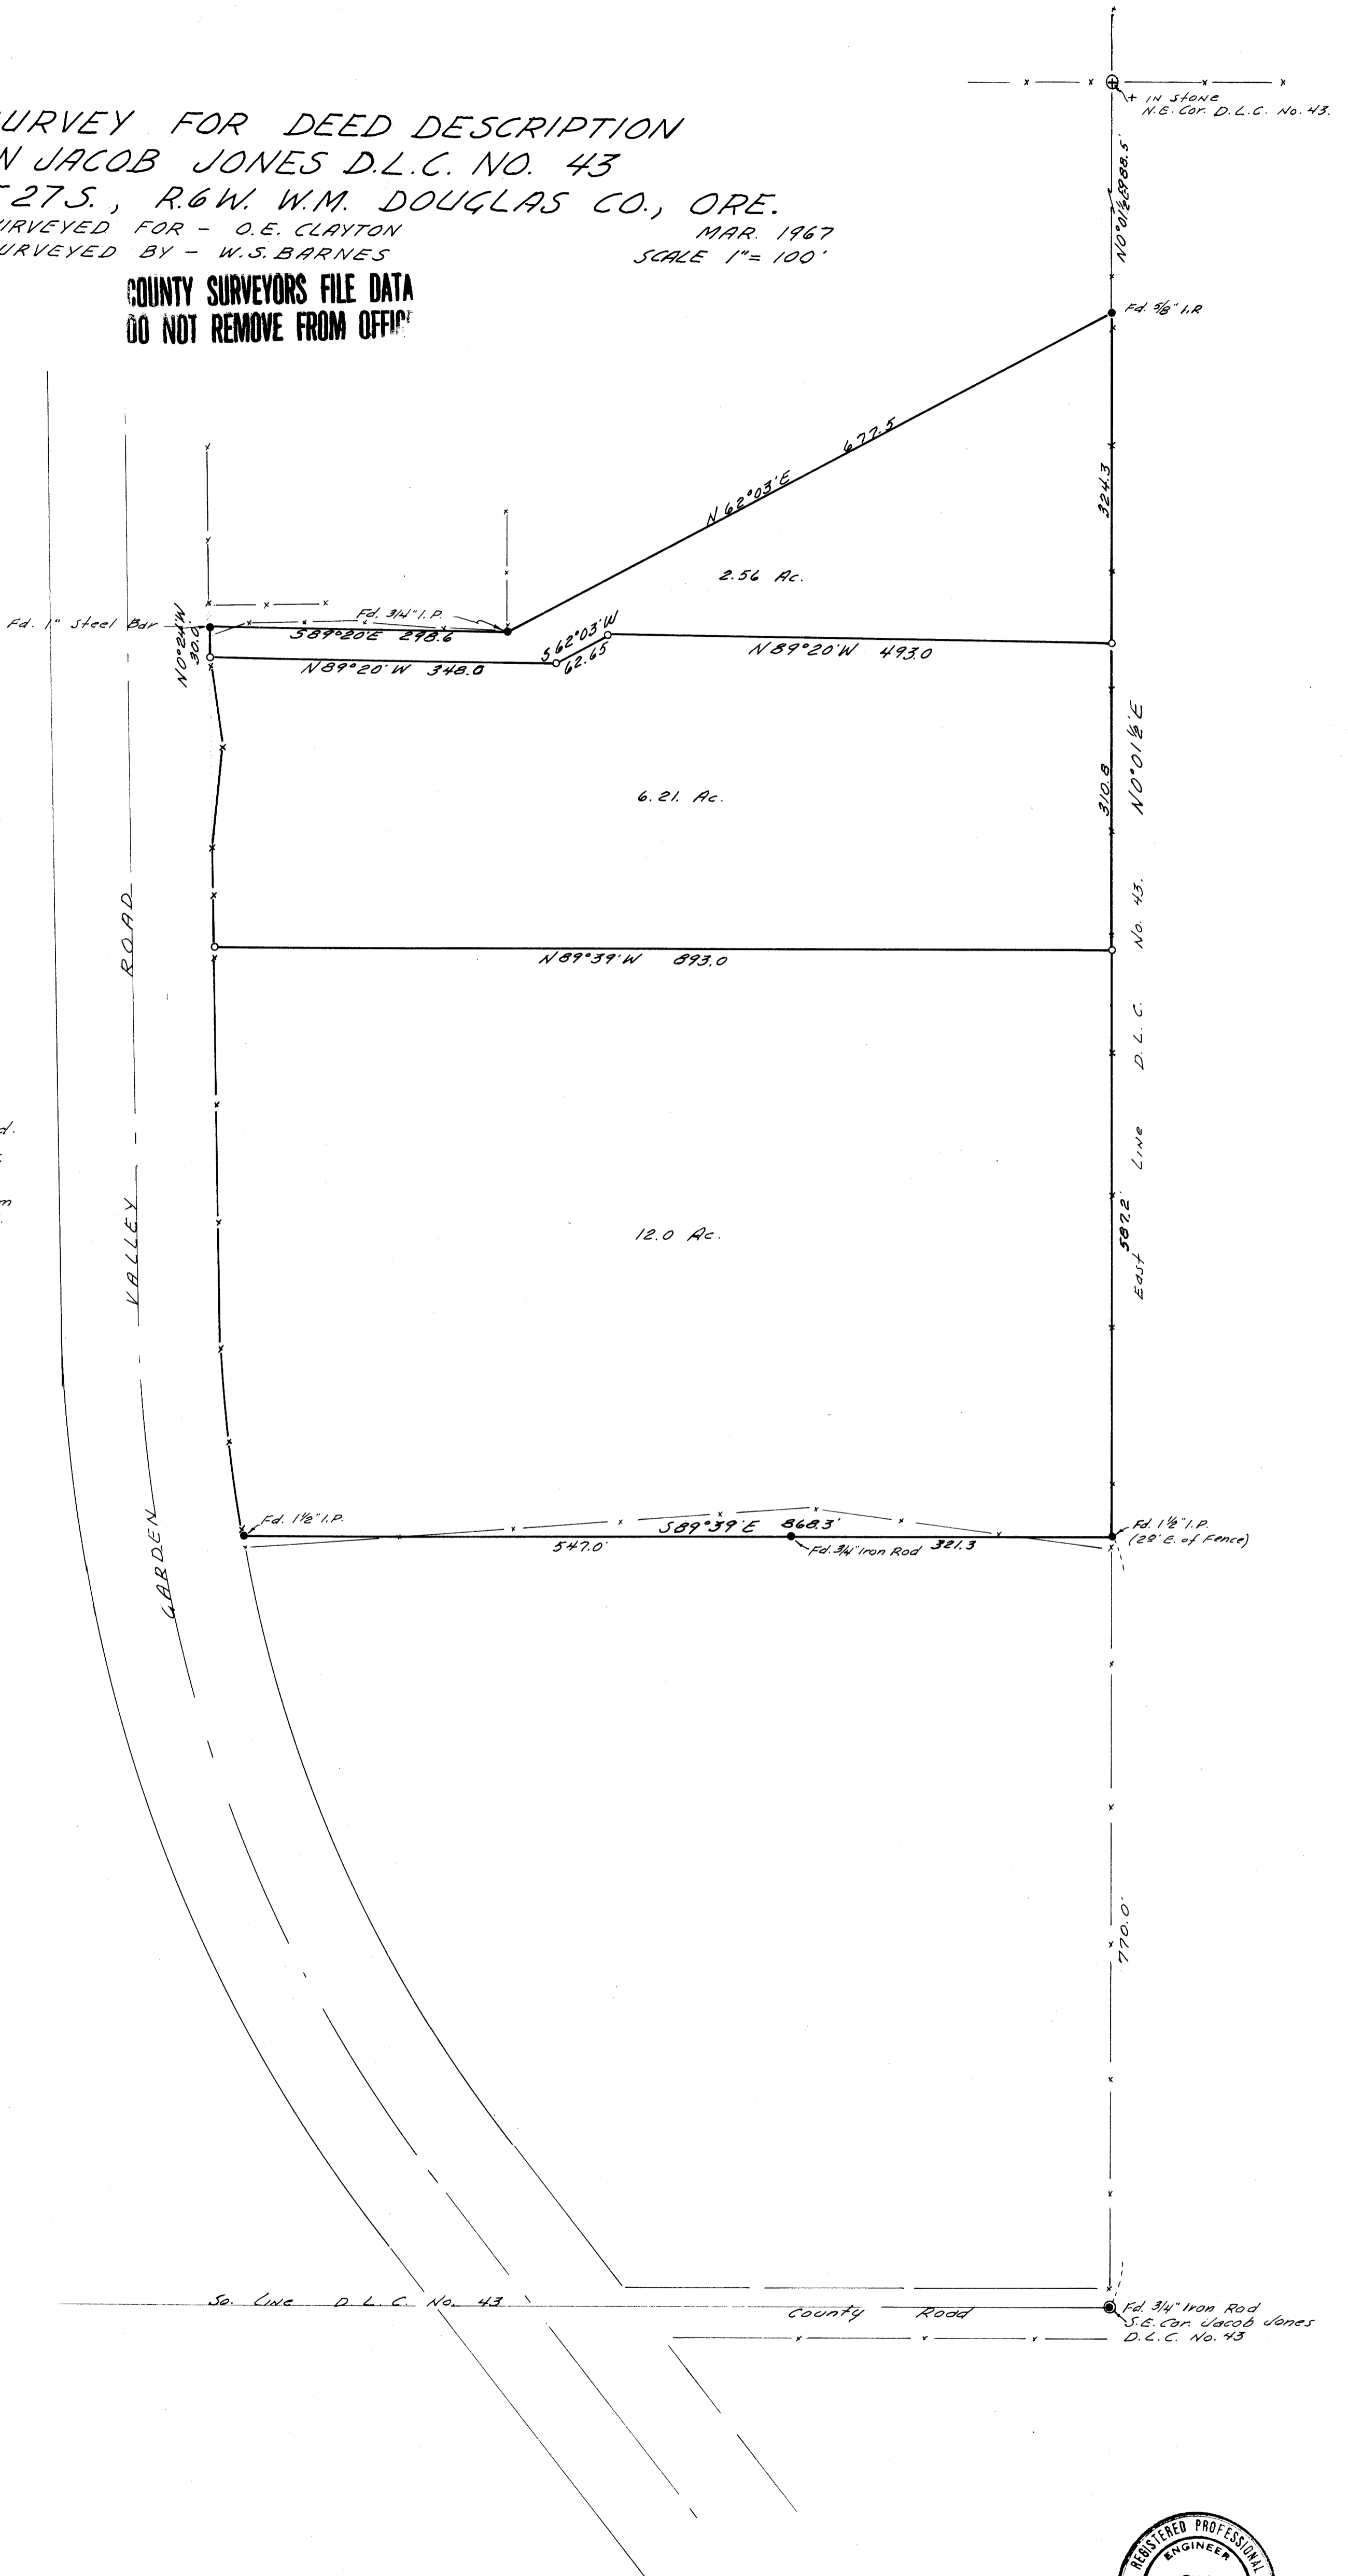

- Denotes monuments found.
- " 1/4" Iron pipes set.

Note: Base bearing taken from East line of D.L.C. No. 43.

FILED
RECEIVED
MAR 3 1967
COUNTY SURVEYOR
DOUGLAS COUNTY, ORE.

