


N.W. corner John Lieser D.L.C. NO. 53
 T. 27 S., R. 6 W., W. M. Douglas County, Ore.
 (Tie by record only)



BEARINGS BASED ON
 RECORD BEARING OF
 WESTERLY SIDE OF
 MURPHYVILLE SUBDIVISION.

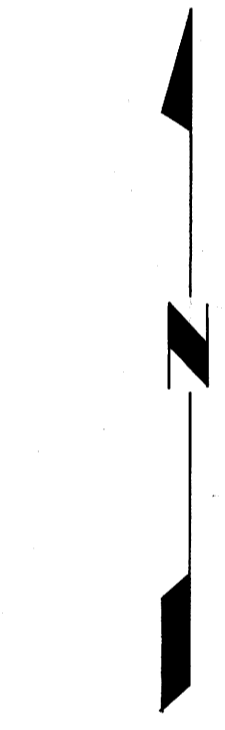


JULY 20, 1967

PROPERTY SURVEY FOR W.C. and M.C. PETERSEN
 IN LOT 1 OF MURPHYVILLE SUBDIVISION IN SECTION 23,
 T. 27 S., R. 6 W., W. M., ROSEBURG, OREGON.

LEGEND

- CORNERS FOUND
- CORNERS SET - 5/8" IRON ROD

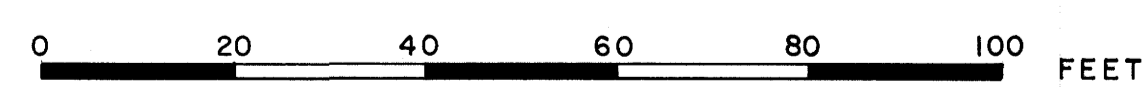

FILED
 RECEIVED

JUL 20 1967

COUNTY SURVEYOR
 DOUGLAS COUNTY, ORE.

SCALE: 1" = 20'

