


COUNTY SURVEYORS FILE DATA  
DO NOT REMOVE FROM OFFICE

FILED  
RECEIVED  
FEB 26 1969  
COUNTY SURVEYOR  
DOUGLAS COUNTY, ORE

MAP FILE M-337-53




Basis of Bearings=  
Recorded Bearings  
on County Road

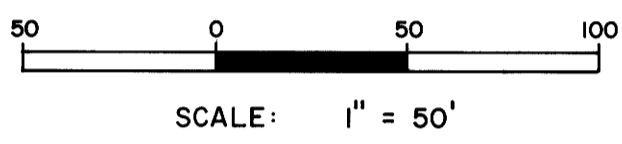

BLOCK 1, PLAT C  
S.L. & W. Co.

BLOCK 2, PLAT C  
Sutherlin Land & Water Co.

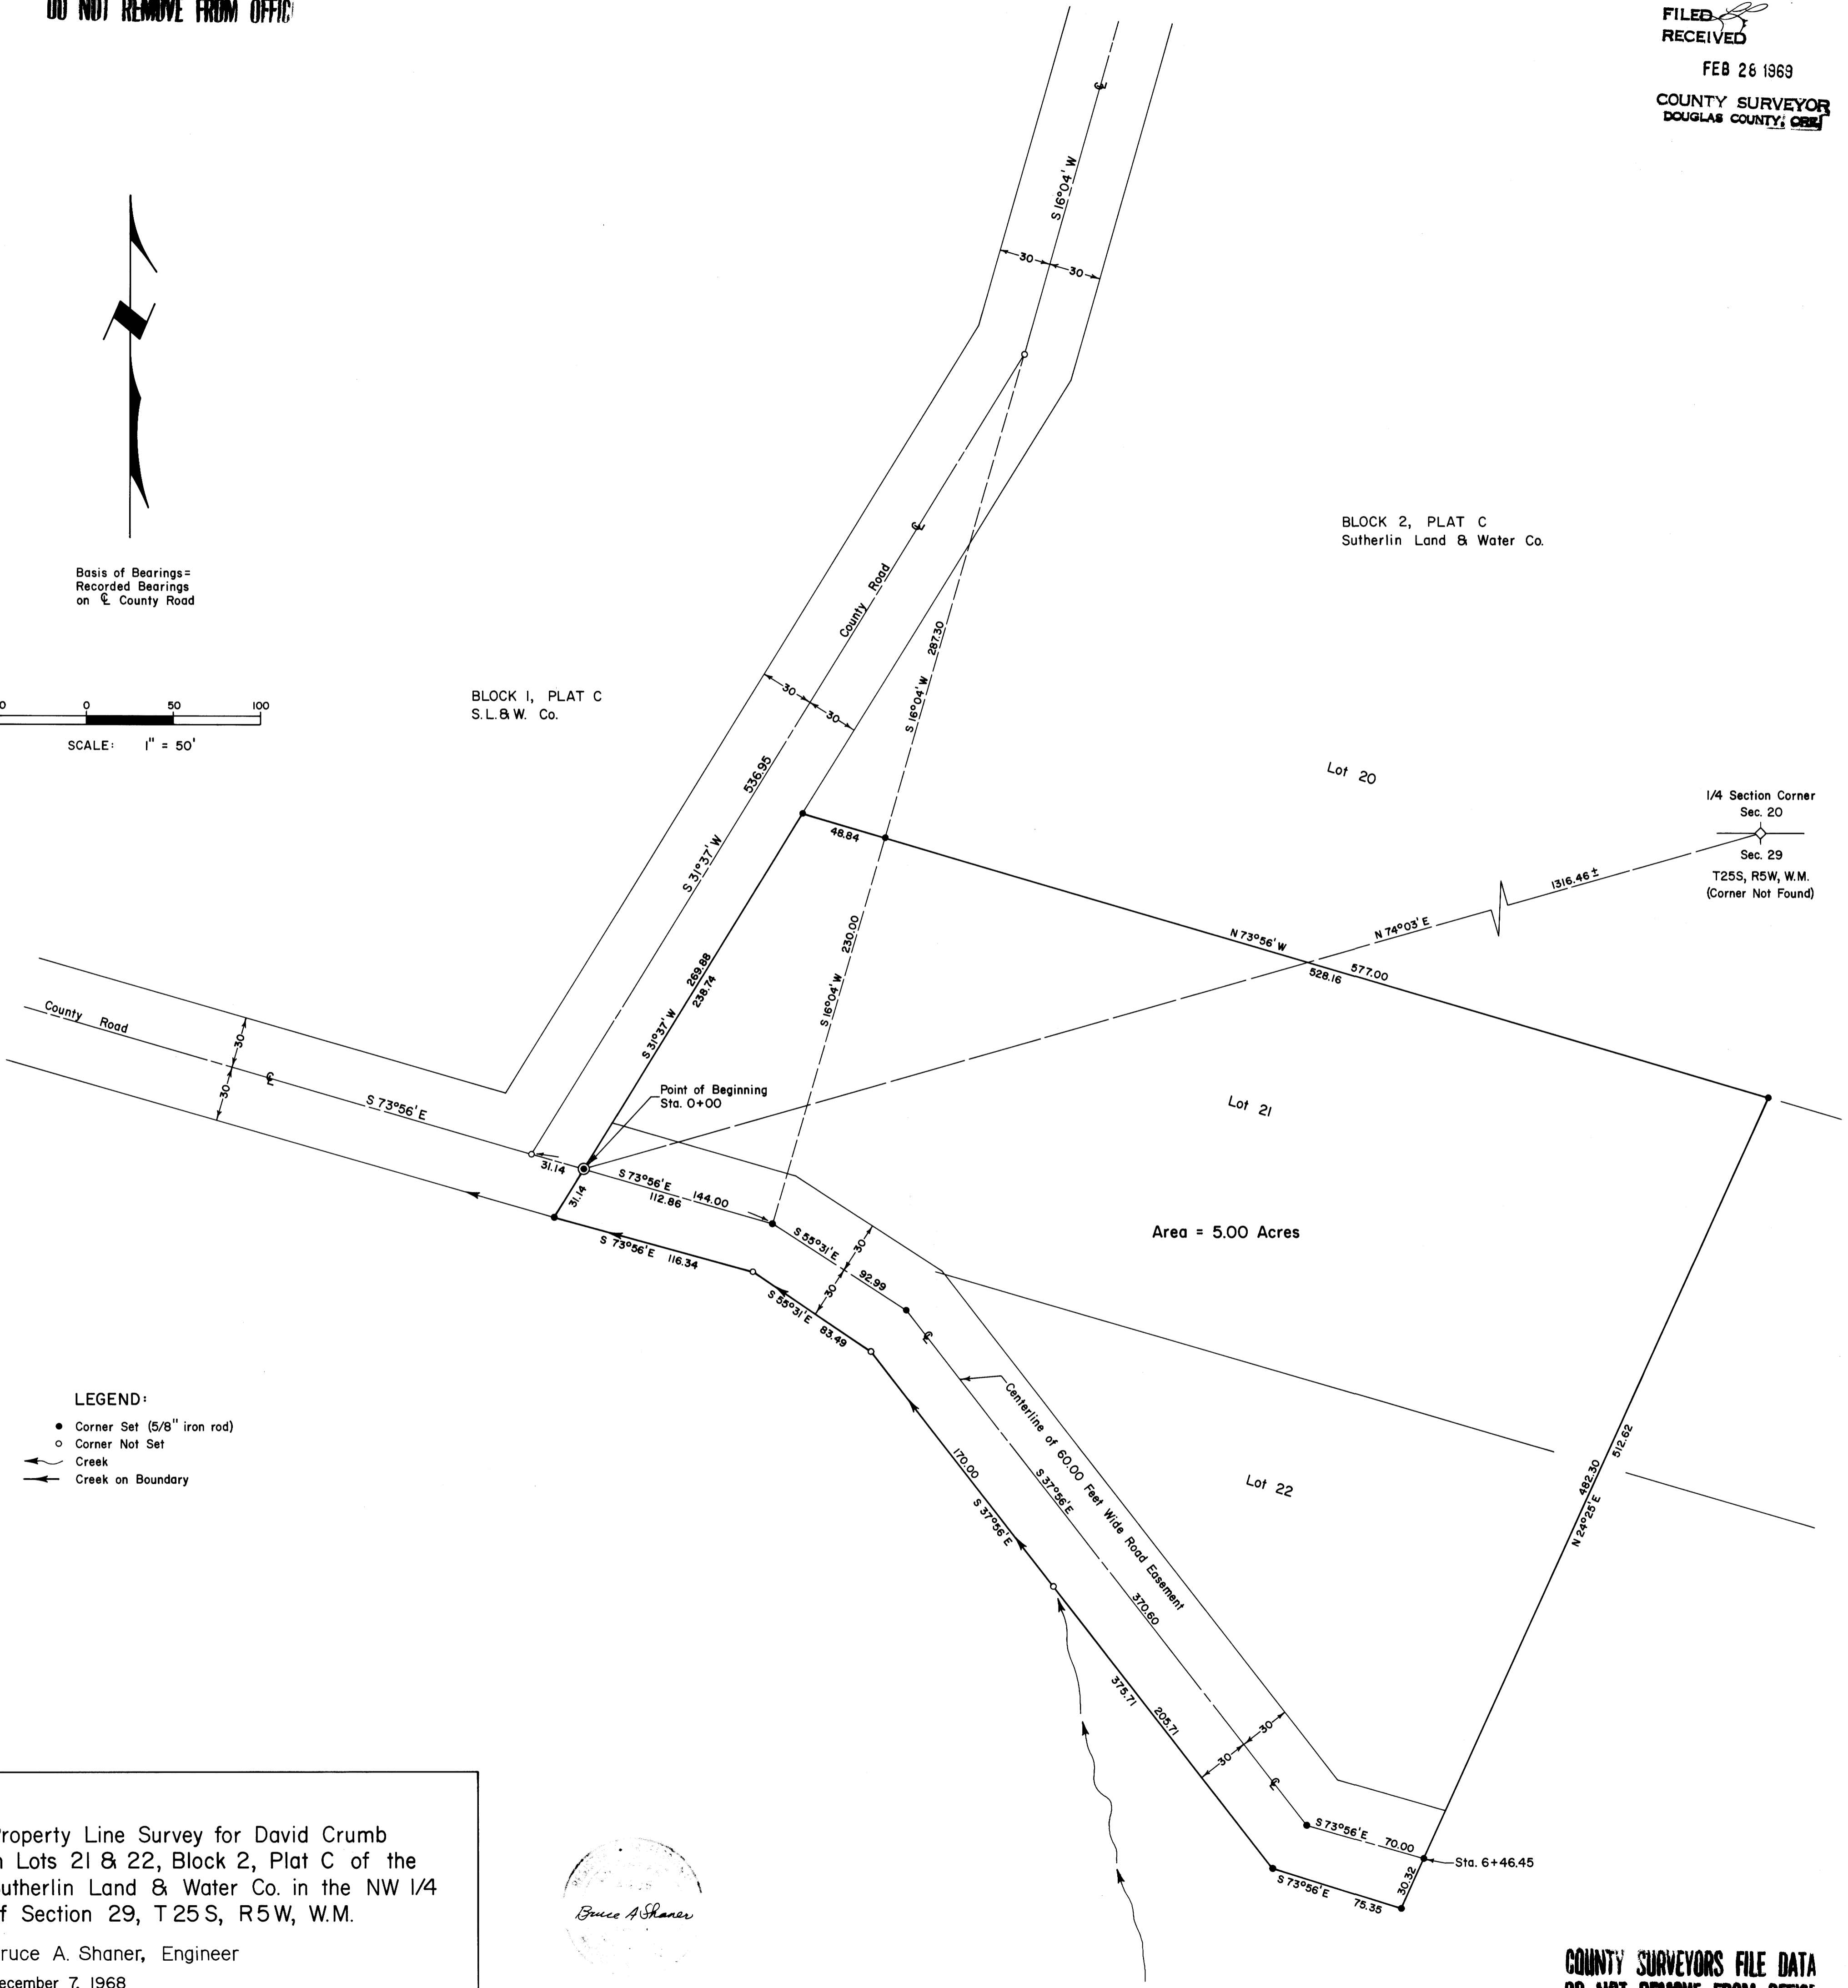

LEGEND:

- Corner Set (5/8" iron rod)
- Corner Not Set
- ↔ Creek
- ↔ Creek on Boundary

Property Line Survey for David Crumb  
In Lots 21 & 22, Block 2, Plat C of the  
Sutherlin Land & Water Co. in the NW 1/4  
of Section 29, T25 S, R5W, W.M.

Bruce A. Shaner, Engineer  
December 7, 1968



COUNTY SURVEYORS FILE DATA  
DO NOT REMOVE FROM OFFICE

MAP FILE M-337-53