


S. E. Corner D.L.C. No. 39
Found P.K. Nail in pavement;
22" W Oak, N 8°W, 29.4 ft.,
scribed S.E. D.L.C. 39 CS BT;
18" Cedar, S 30°E, 55.5 ft.,
marked with P.K. Nail


W 1/16 19
30
Found Brass Cap, marked
County Surveyor's Office 1957
T27S, R5W, W 1/16 S 19/30:
6" W Oak, N 62°30'E, 39.3 ft.,
scribed W 1/16 S 19 CS BT;
16" W Oak, S 21°30'W, 27.5 ft.,
scribed W 1/16 S 30 CS BT

Basis of Bearings: the northerly boundary
of the Rex & Mary Roberts property, as
recorded.

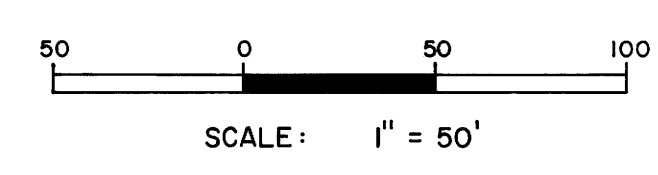

- LEGEND:
- Corner Found (3/4" Iron Rod)
 - Corner Set (5/8" Iron Rod)
 - Corner Not Monumented

COUNTY SURVEYORS FILE DATA
DO NOT REMOVE FROM OFFICE

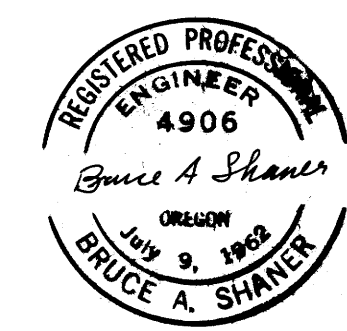

PROPERTY LINE SURVEY
FOR REX AND MARY ROBERTS
In the SW 1/4 Sec. 19 and the NW 1/4 Sec. 30
T27S, R5W, W.M., Douglas County, Oregon
Bruce A. Shaner, Engineer
March 5, 1969