

COUNTY SURVEYORS FILE DATA
DO NOT REMOVE FROM OFFICE

SURVEY IN S 1/2 N 1/2 WM. J. MARTIN D.L.C.
SEC. 31, T. 26 S., R. 5 W. AND SEC. 36, T. 26 S., R. 6 W., W.M.
SURVEYED FOR G. C. AGEE AND E. D. STONEROD
SURVEYED BY R. H. GEE JULY, 1969
SCALE 1" = 100'



FILED
RECEIVED

JUL 30 1969

COUNTY SURVEYOR
DOUGLAS COUNTY, ORE.

N.E. COR. WM. J. MARTIN
D.L.C. N° 50
SEC. 31, T. 26 S., R. 5 W., W.M.

BRASS CAP
2 B.T.'S

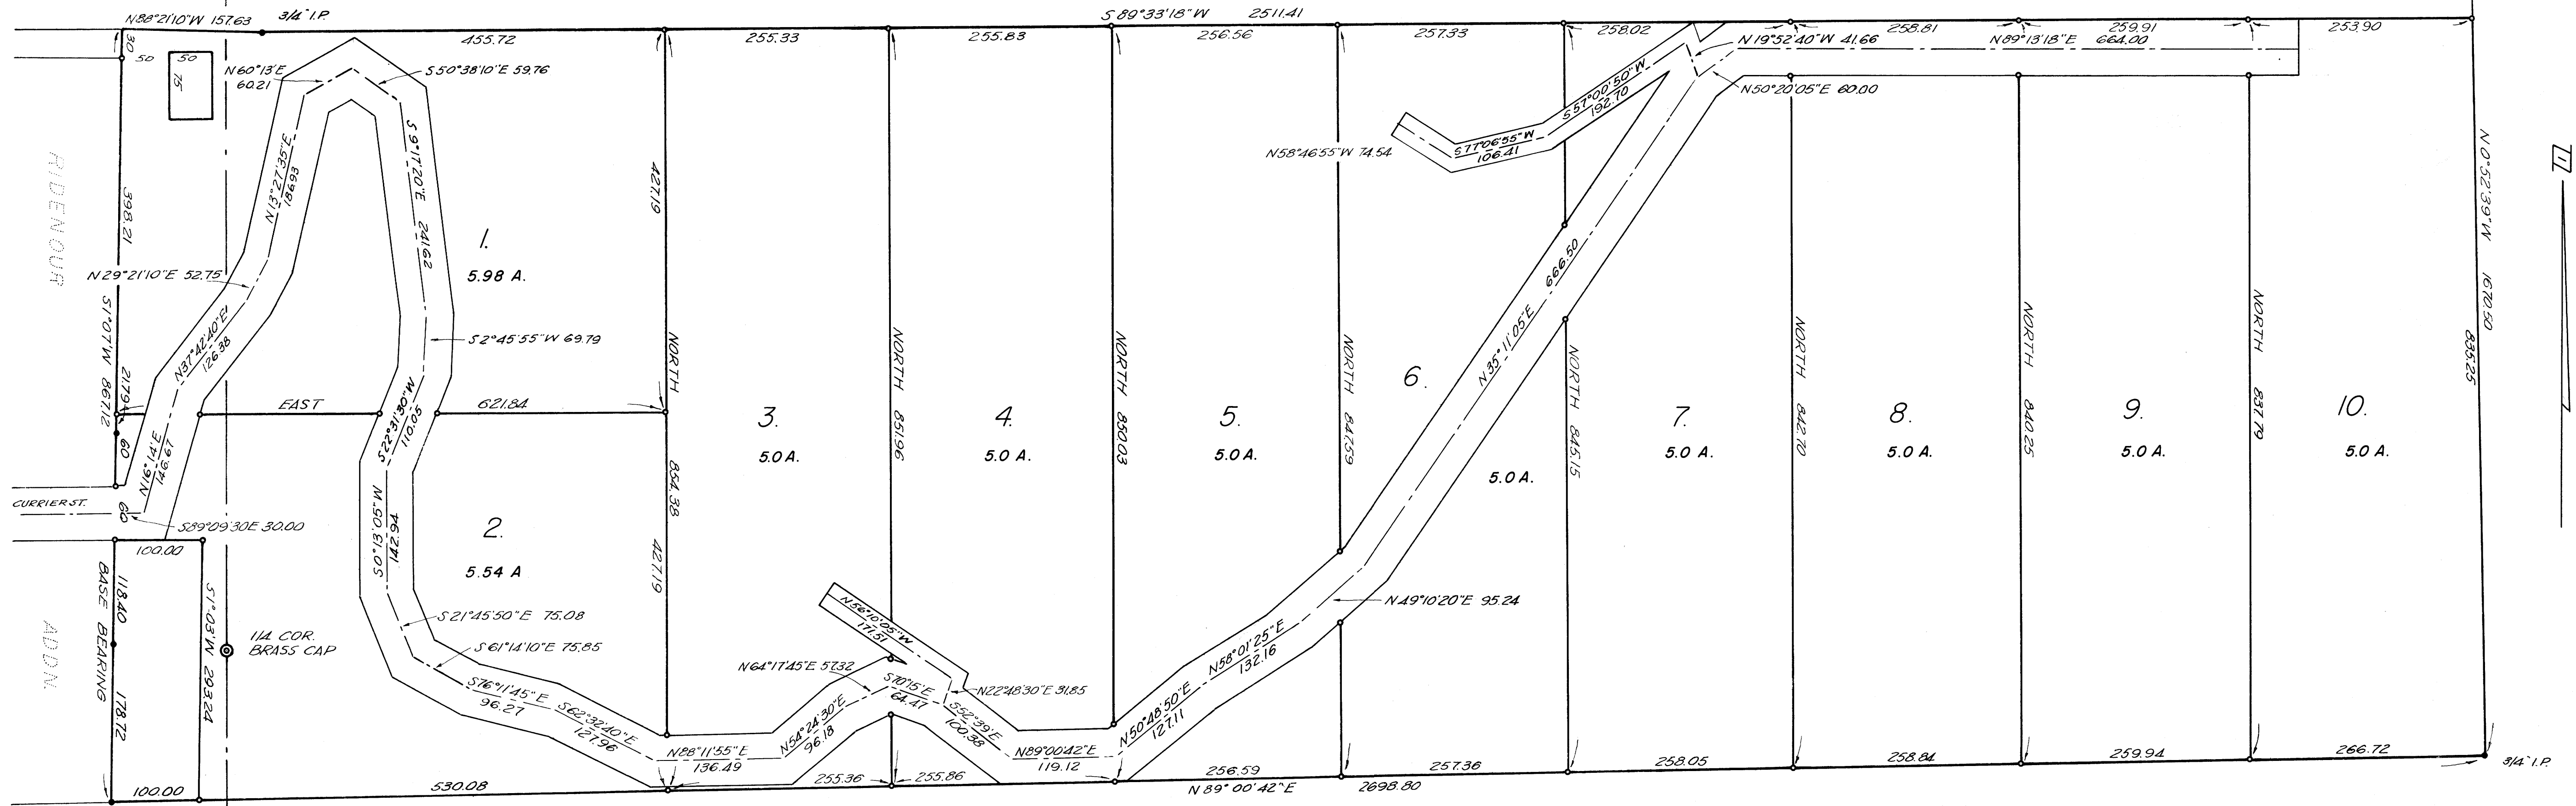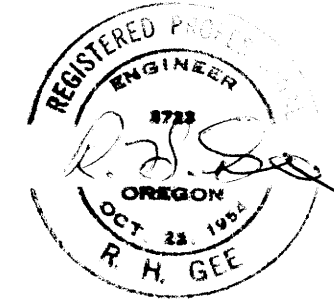

- Denotes monument found
- Denotes I. R. set

COUNTY SURVEYORS FILE DATA
DO NOT REMOVE FROM OFFICE