

COUNTY SURVEYORS FILE DATA  
DO NOT REMOVE FROM OFFICE

# SURVEY TO ESTABLISH PROPERTY CORNERS IN LOT 2 OF FRUITDALE, SEC 12, T 27 S, R 6 W.W.M.

SURVEYED FOR - GEO. LUOMA  
SURVEYED BY - W. S. BARNES




APRIL 1967  
SCALE 1" = 40'

FILED  
RECEIVED

MAY 3 1967

COUNTY SURVEYOR  
DOUGLAS COUNTY, ORE.

M.P. FILE M34-14

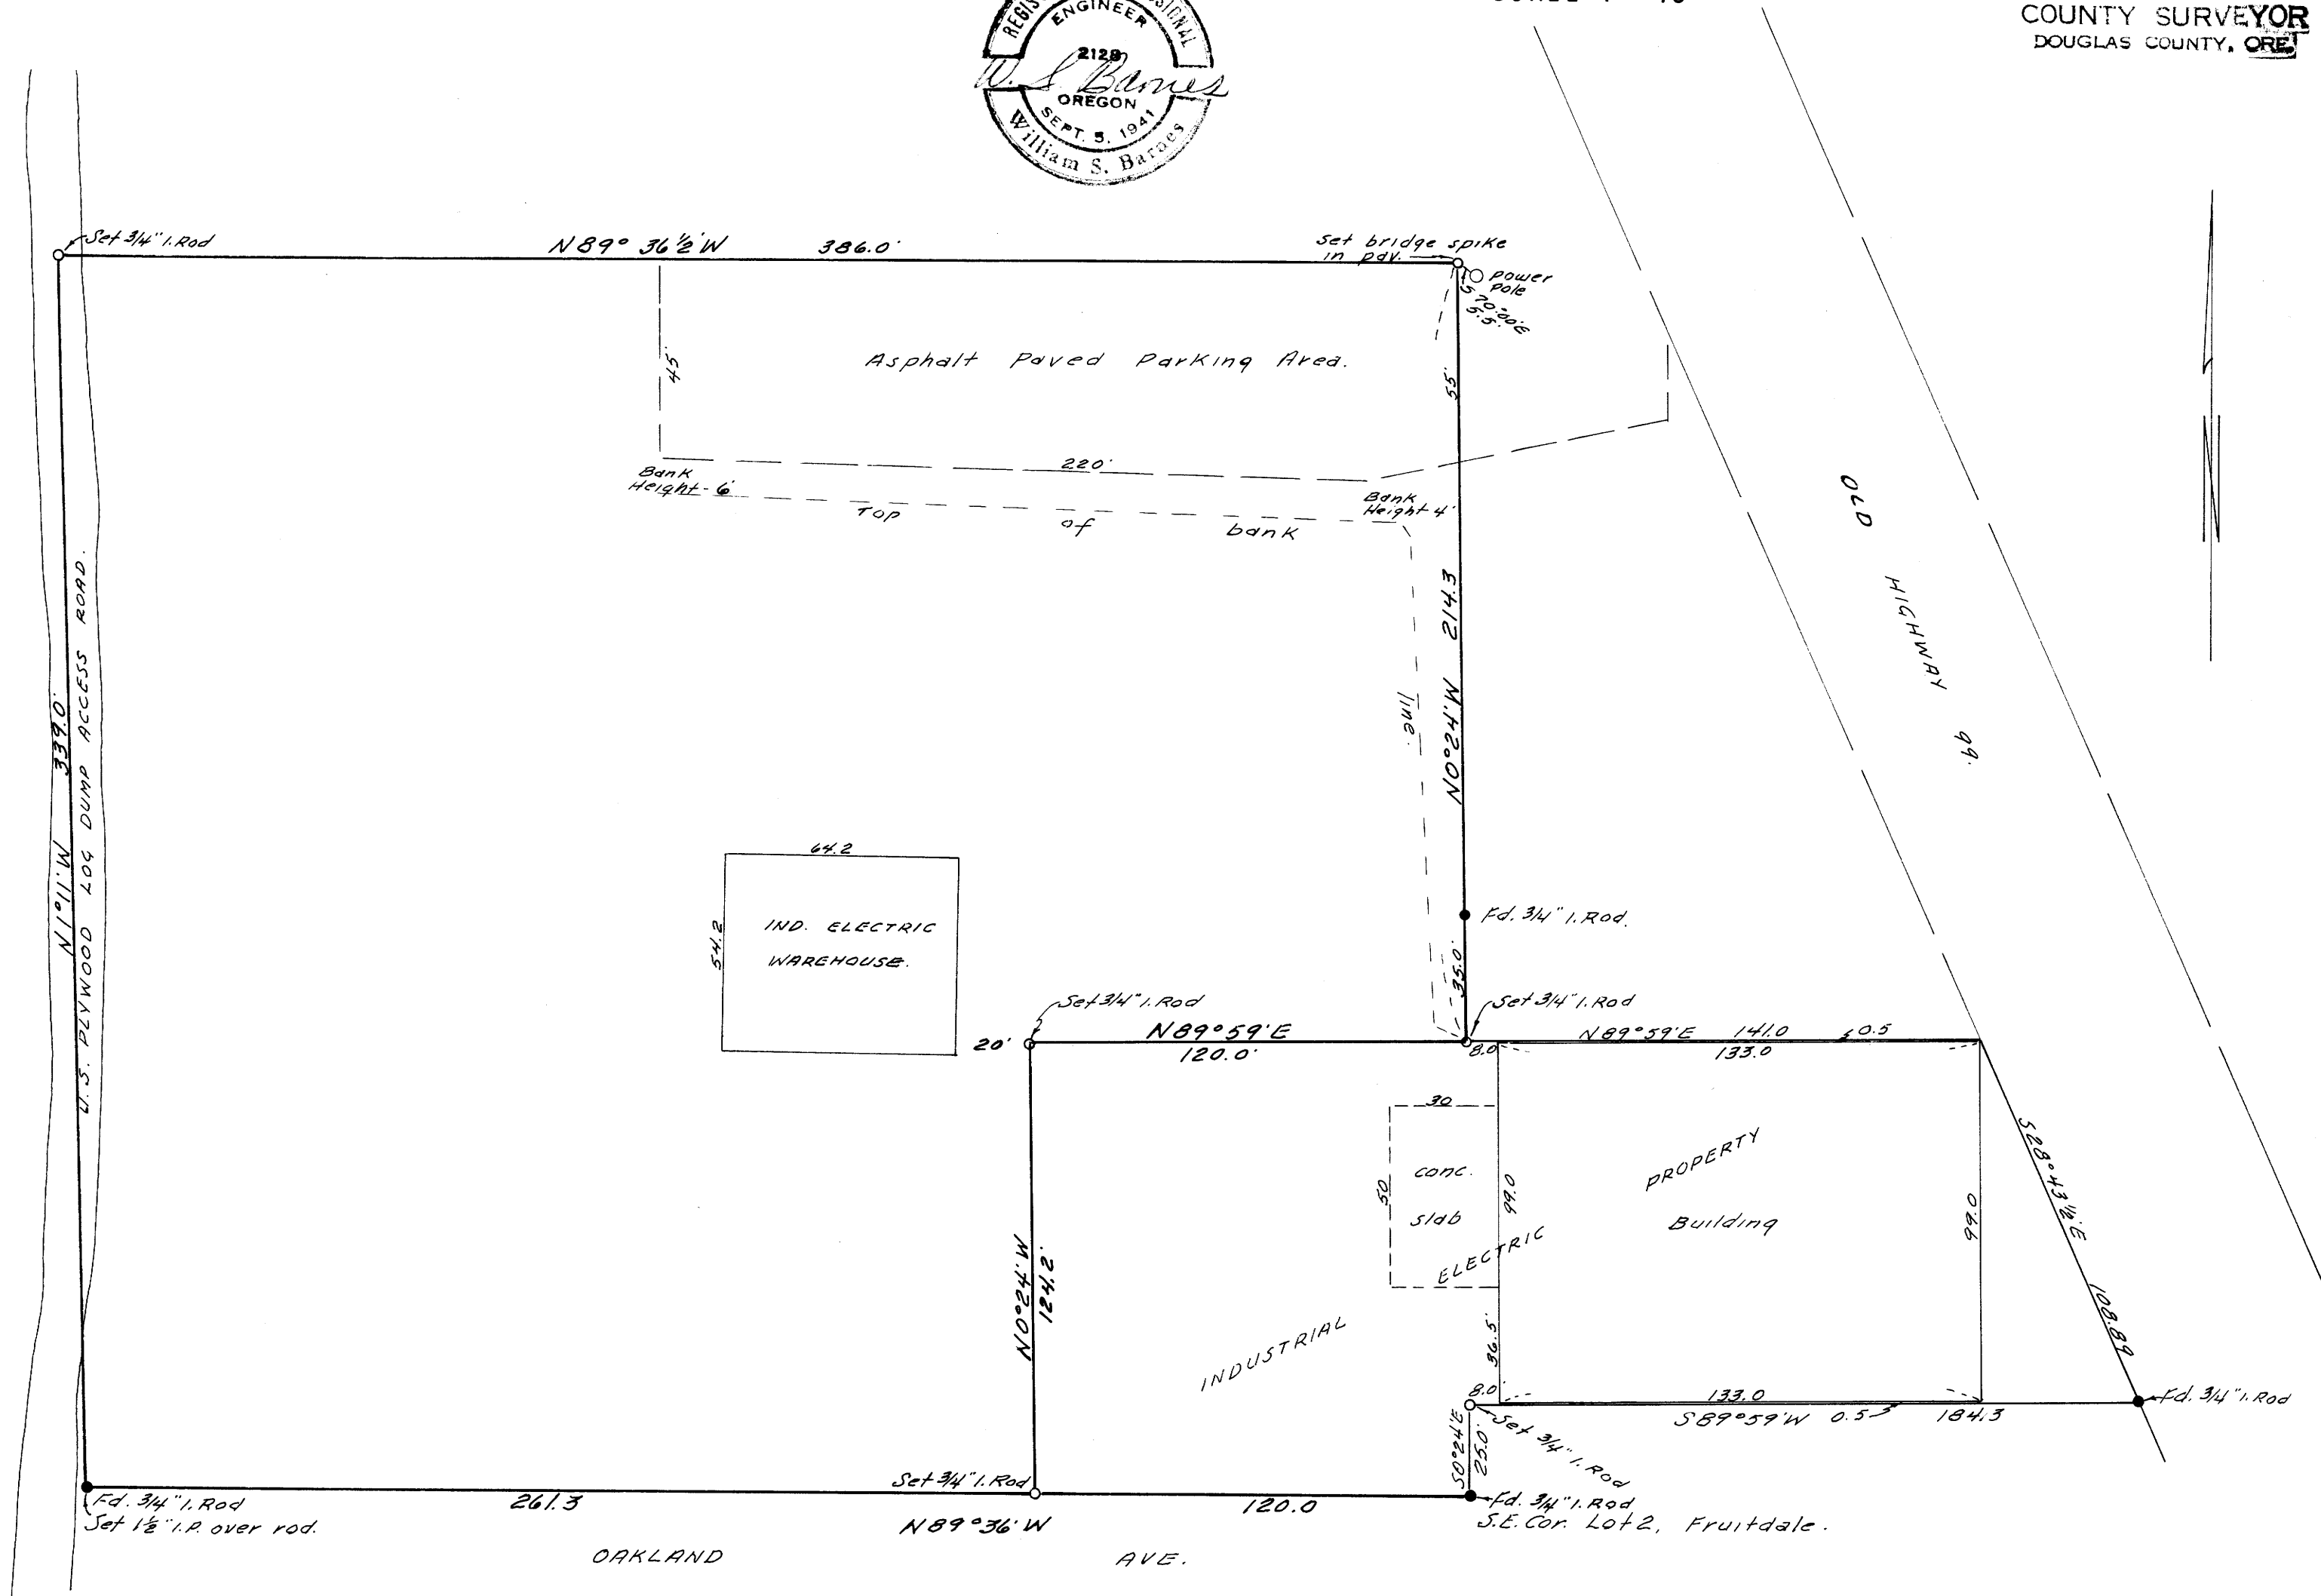

Base Bearing taken from north line Oakland Ave.  
Ref. - C.S. File - 46-160.

U.S. PLYWOOD LOG POND

U.S. PLYWOOD LOG DUMP ACCESS ROAD

OLD HIGHWAY 99

OAKLAND AVE.

M34-14