


COUNTY SURVEYORS FILE DATA SURVEY FOR DEED DESCRIPTION IN DO NOT REMOVE FROM OFFICE SEC. 18, T22S, R9W, DOUGLAS CO., ORE.

SURVEYED FOR - HOWARD RUBEN
SURVEYED BY - W.S. BARNES

MAY 1967
SCALE 1" = 60'

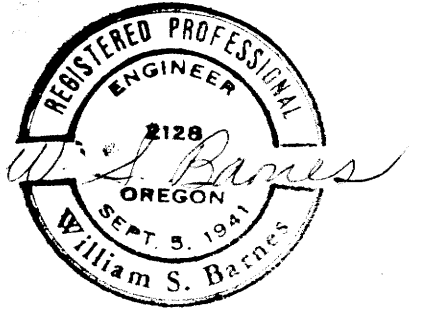

1/4 cor.
Sec. 5 T22S,
R9W.

N14°18'W
3345.7'

pond

S61°17'E
182.3' 60'

S39°28'W 400.0'

38.

NO.

HWY.

LINE

777.3'

3.0 Acres

LINE

BLK.

HIGH

LINE

462.4'

S42°12'W

108.5'

LINE

Water

LOW

RIVER

UMPUQUA



o Denotes 1/4" I.P.s set.
Base bearing taken from north
line of Wessela property - See C.S. File M27-33

FILED
RECEIVED

MAY 3 1967

COUNTY SURVEYOR
DOUGLAS COUNTY, ORE.