

Sec. 6

Sec. 5

Sec. 4

Initial point of survey

N 87°43' 23" E
2618.18'

5236.36'
2618.18'

Set 1" x 30" galv. iron pipe

Found 2 1/2" brass cap

T 30 S
S5 | S4
S8 | S9
R 8 W
1964

Found 2 1/2" brass cap

T 30 S
S5 | S6
S6 | S7
R 8 W
1965

5195.13'
2597.57'

2604.77'
5209.53'

Sec. 7

Sec. 8

Sec. 9

Set 1" x 30" galv. iron pipe

Set 1" x 30" galv. iron pipe

S 0° 25' 29" W
2597.57'

2604.77'
S 0° 15' 48" W

Found 2 1/2" brass cap

T 30 S
S7 | S8
S18 | S17
R 8 W
1965

Found 2 1/2" brass cap

T 30 S
S8 | S9
S17 | S16
R 8 W
1965

Sec. 18

Sec. 17

Sec. 16

R 8 W		
Moore Mill & Lumber Co. 6	U.S. 5	Moore Mill & Lumber Co. 4
U.S. 7	Moore Mill & Lumber Co. 8	U.S. 9
Roseburg Lumber Co. 18	U.S. 17	Weyerhaeuser Lumber Co. 16

VICINITY MAP

1" = 1 mile


FILED
RECEIVED

JUN 23 1967

COUNTY SURVEYOR
DOUGLAS COUNTY, ORE.

LEGEND

- Denotes corners found
- corners set
- Bearings based on solar observations.
- Blazed line

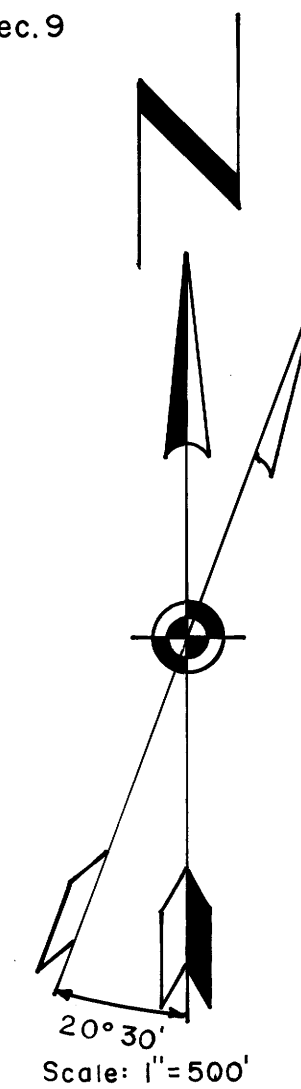

COUNTY SURVEYORS FILE DATA
(1) (1) RECORDS FROM OFFICE

SECTION 8, T30S, R8W, W.M.

PROPERTY LINE SURVEY FOR

MOORE MILL
and
LUMBER COMPANY
Bandon, Oregon

Surveyed June 21, 1967 by

SEEK, INC.

P.O. Box 375 Roseburg, Oregon 97470

REGISTERED
OREGON
LAND SURVEYOR

William C. Stiles

OCT. 4, 1957
WILLIAM C. STILES
432

SURVEY BY SEEK, INC.
FOR MOORE MILL AND LUMBER COMPANY
To Establish a Portion of the Exterior Boundaries
Of Section 8, T30S, R8W, W.M., Douglas County, Oregon

The survey was initiated at the corner to Sections 5, 6, 7, and 8, T30S, R8W, which is a brass cap with accessories as noted in the County Surveyor's records. Thence the traverse was begun on a due south bearing. At 2640 feet the 1/4 corner between Sections 7 and 8 was searched for but not found. The traverse was continued south to the corner to Sections 7, 8, 17, and 18, which is a brass cap with accessories as noted in the records of the County Surveyor. The true bearing and length of this line was determined to be $S0^{\circ} 25' 28''W$, 5195.13 feet. At proportionate distance of 2597.57 feet, $S0^{\circ} 25' 29''W$ of the corner to Sections 5, 6, 7, and 8, the 1/4 corner between Sections 7 and 8 was established. A 1" in diameter by 30" galvanized iron pipe was set at the point for the corner from which an 8" in diameter White Fir bears $N36^{\circ} 08' 12''W$, 8.4 feet, marked 1/4 S 7 BT; and an 8" diameter White Fir bears $N87^{\circ} 33' 43''E$, 7.5 feet.

Beginning at the corner to Sections 5, 6, 7, and 8 the traverse was continued east. At 2640 feet the 1/4 corner between Sections 5 and 8 was searched for but not found. The traverse was continued east to the corner of Sections 4, 5, 8, and 9, which is a brass cap with accessories as noted in the records of the County Surveyor. The true bearing and length of this line was determined to be $N87^{\circ} 43' 23''E$, 5236.36 feet. At proportionate distance of 2618.18 feet, $N87^{\circ} 43' 23'' E$ of the corner to Sections 4, 5, 8, and 9, the 1/4 corner between Sections 5 and 8 was established. A 1" in diameter by 30" galvanized iron pipe was set at the point for the corner from which a 7" White Fir bears $N38^{\circ} 48' 56'' W$, 21.09 Feet, marked 1/4 S 5 BT; and an 18" Cedar bears $S48^{\circ} 41' 14'' E$, 25.5 feet.


From the corner to Sections 4, 5, 8 and 9 the traverse was continued south. At 2640 feet the 1/4 corner between Sections 8 and 9 was searched for but not found. The traverse was continued south to the corner to Sections 8, 9, 16, and 17 which is marked with a brass cap and accessories as recorded at the County Surveyor's office. The bearing and length of this line was determined to be $S0^{\circ} 15' 48''W$, 5209.53 feet. The 1/4 corner between Sections 8 and 9 was set at proportionate distance of 2604.77 feet, $S0^{\circ} 15' 48''W$ of the corner to Sections 4, 5, 8, and 9. At the point for the corner a 1" in diameter by 30" galvanized iron pipe was set from which a 9" White Fir bears $N55^{\circ} 54' 11''W$, 22.3 feet, marked 1/4 S 8 BT; and a 7" White Fir bears $N42^{\circ} 36' 39''E$, 29.0 feet, marked 1/4 S 9 BT.

All true lines were blazed. Bearings were determined by Solar observation.

FILED
RECEIVED 21, 1967

JUL 21 1967

COUNTY SURVEYOR
DOUGLAS COUNTY, ORE.

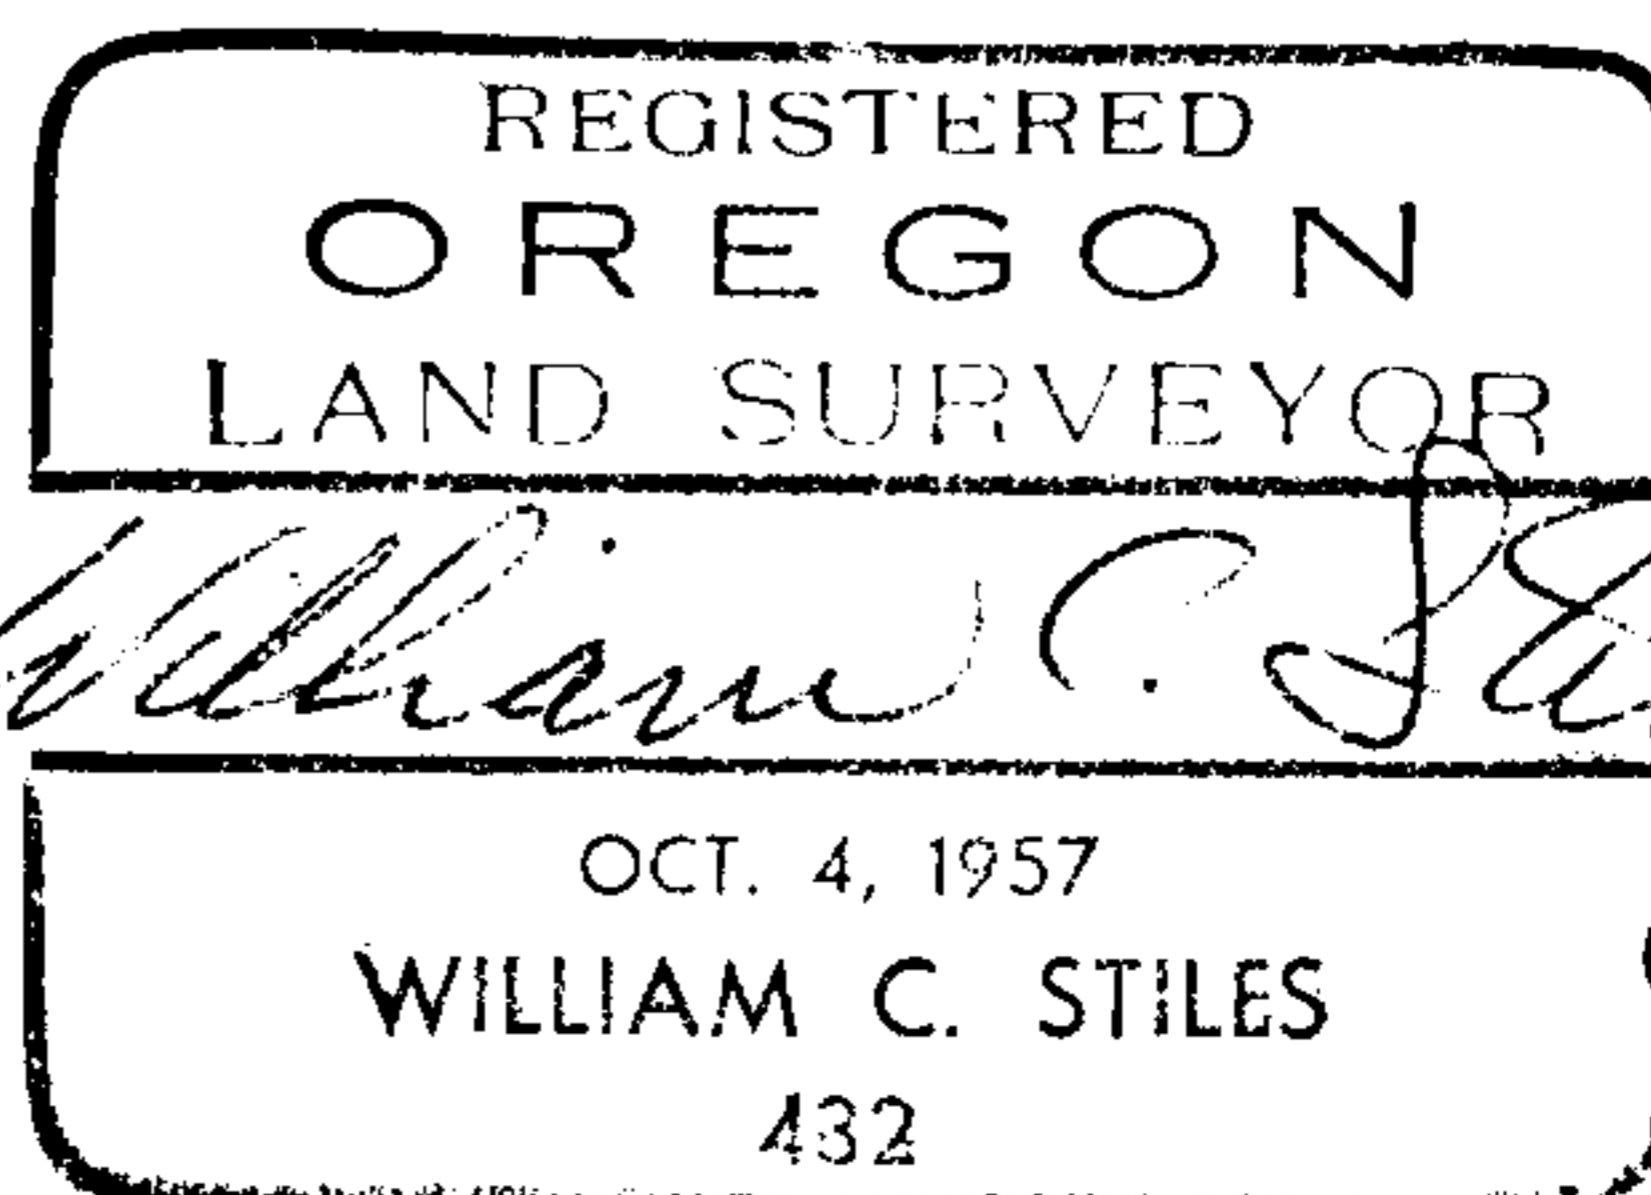

C.S. File 55/44

Map File M34 * 19