


SECTION COR. RESTORATION & SUB. OF SEC. 6 IN SECS. 6 & 7 T30S & T31S R1W W.M.

SURVEYED FOR UMPQUA NATIONAL FOREST
TILLER RANGER DISTRICT, CONTRACT # 00745
SURVEYED BY BAUGHMAN SURVEY SERVICE JUNE 20, 1967
SCALE 1"=400'

⊙ Denotes Brass Cap

⊙* Denotes Brass Cap Set by Single Propor. Method

Bearings based on Solar Observation

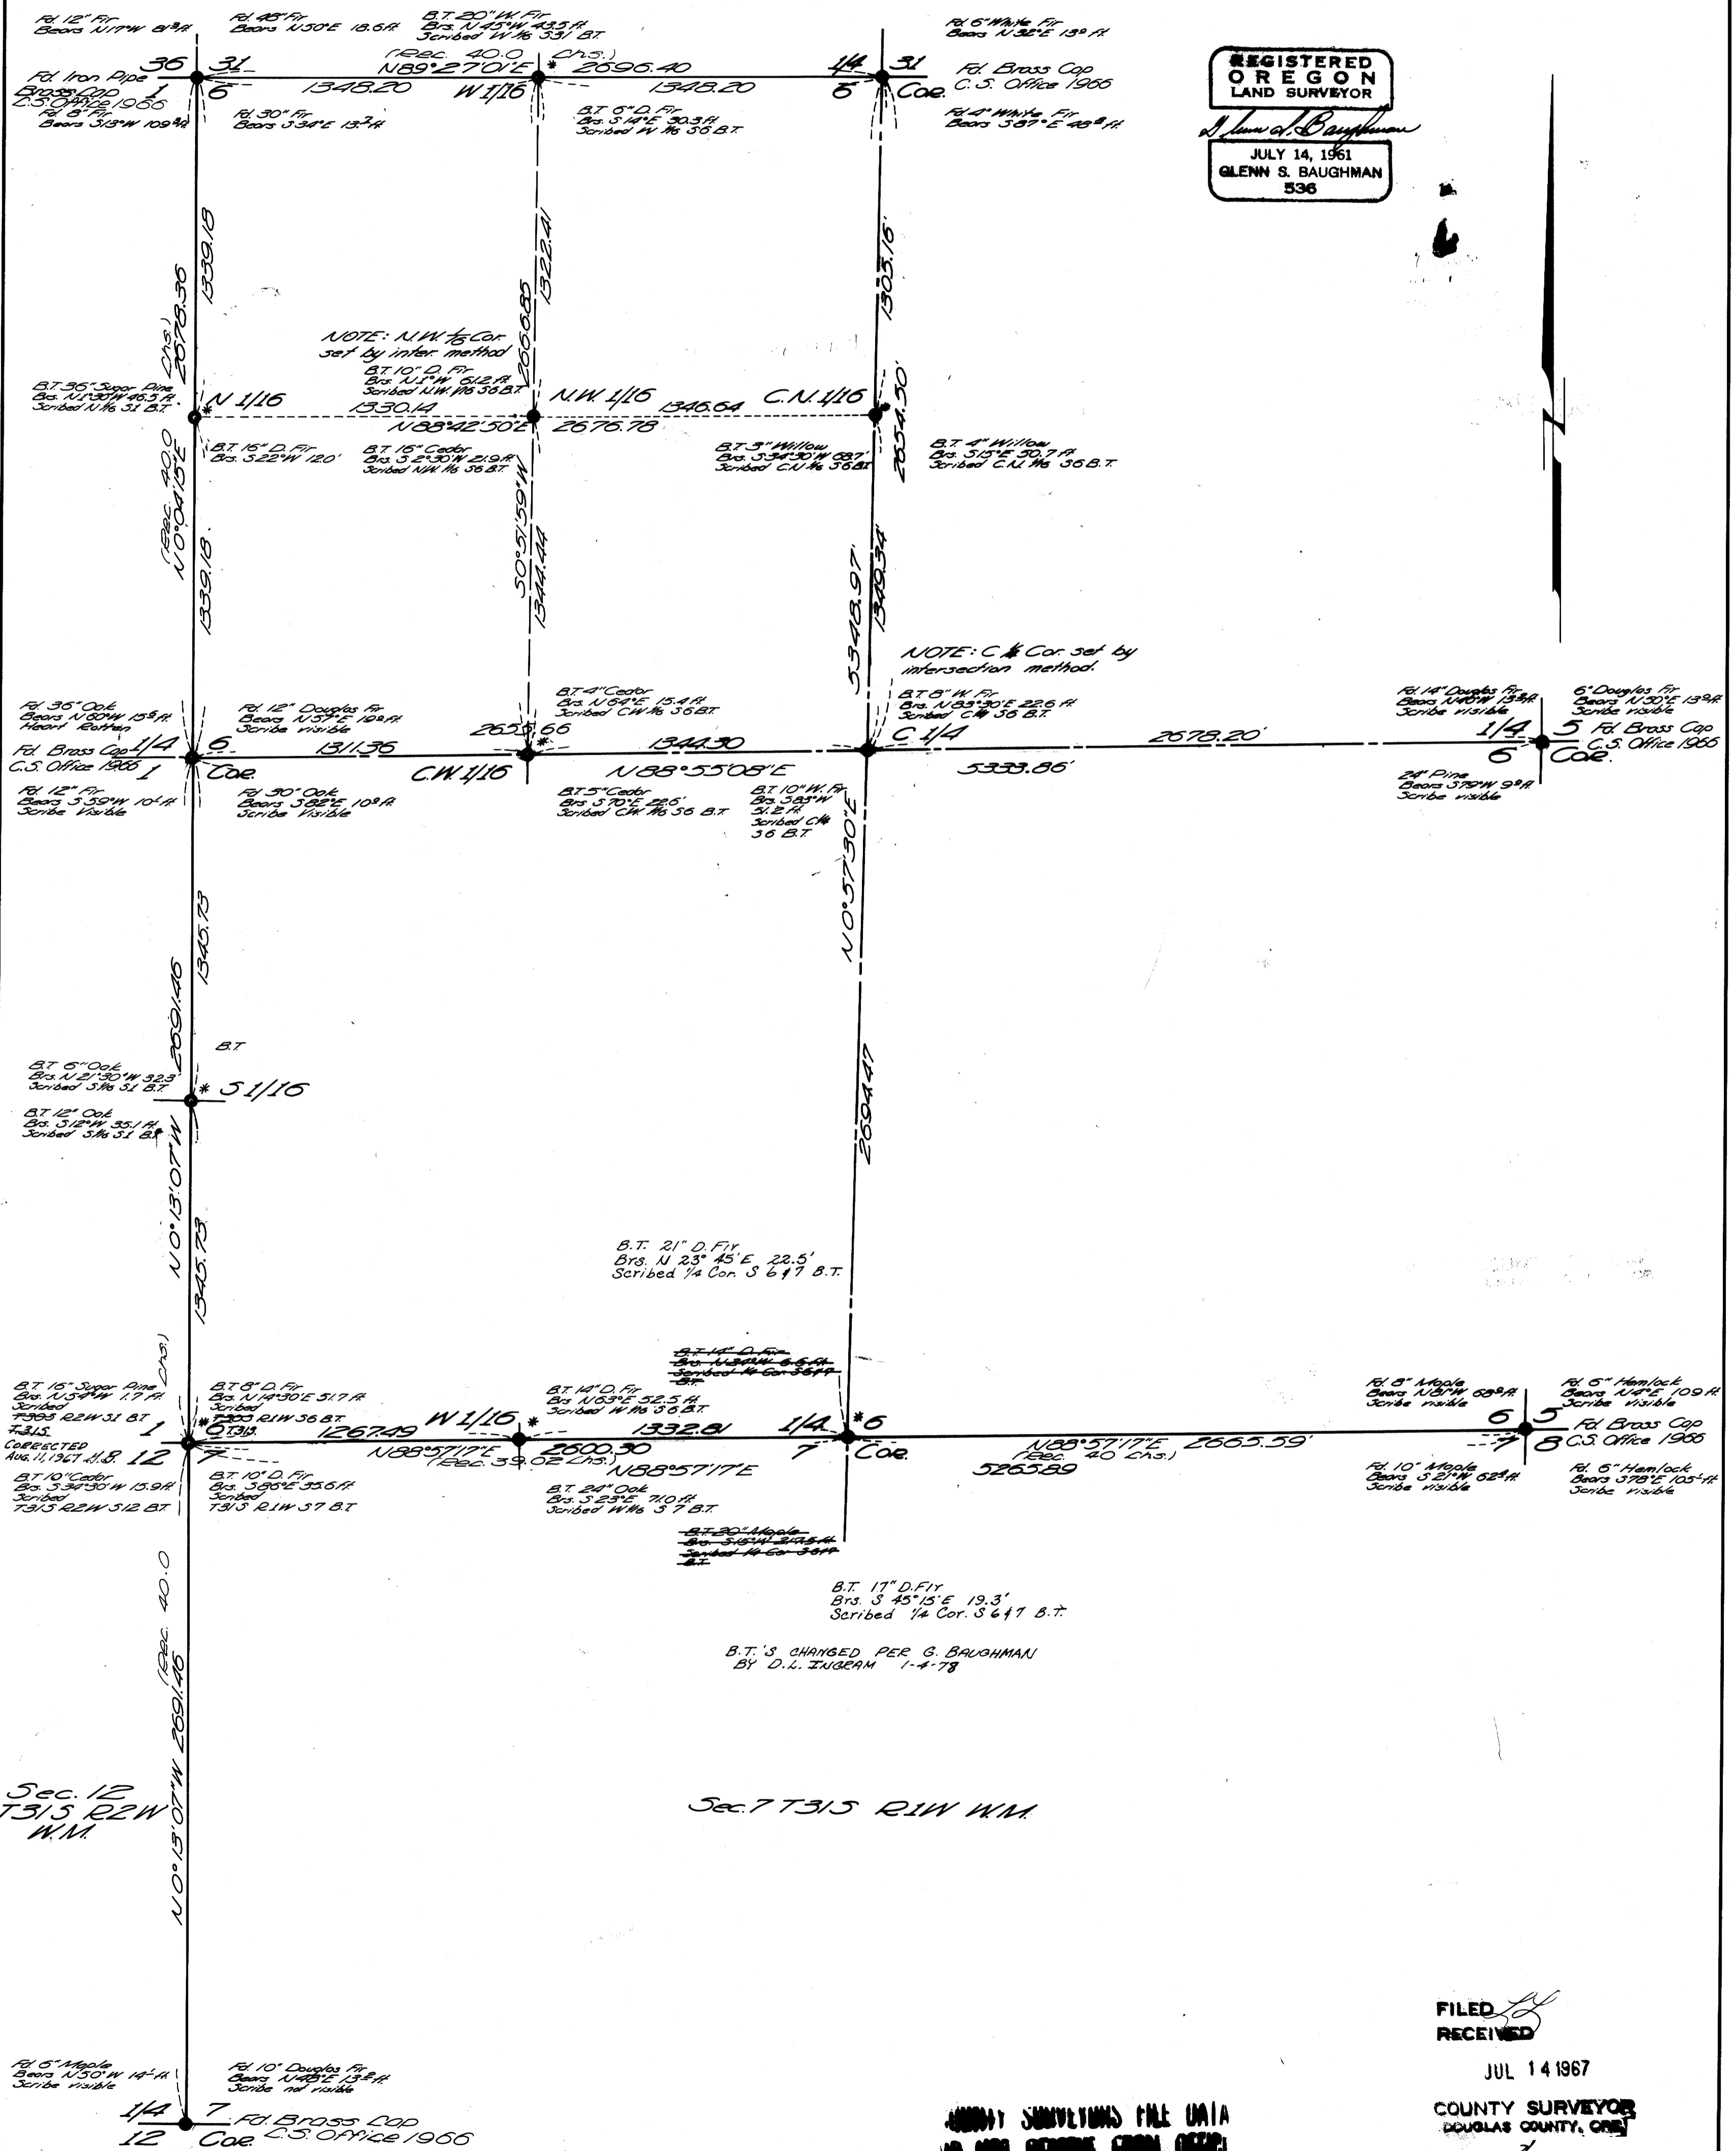

REGISTERED
OREGON
LAND SURVEYOR
Glenn S. Baughman
JULY 14, 1961
GLENN S. BAUGHMAN
536


FILED
RECEIVED
JUL 14 1967
COUNTY SURVEYOR
DOUGLAS COUNTY, ORE

ADDITIONAL SURVEY DATA
AND COR. RECORDS FROM OFFICE

CERTIFIED RECORD OF LAND CORNER MONUMENTATION

History of original corner establishment:

No corner had been previously set.

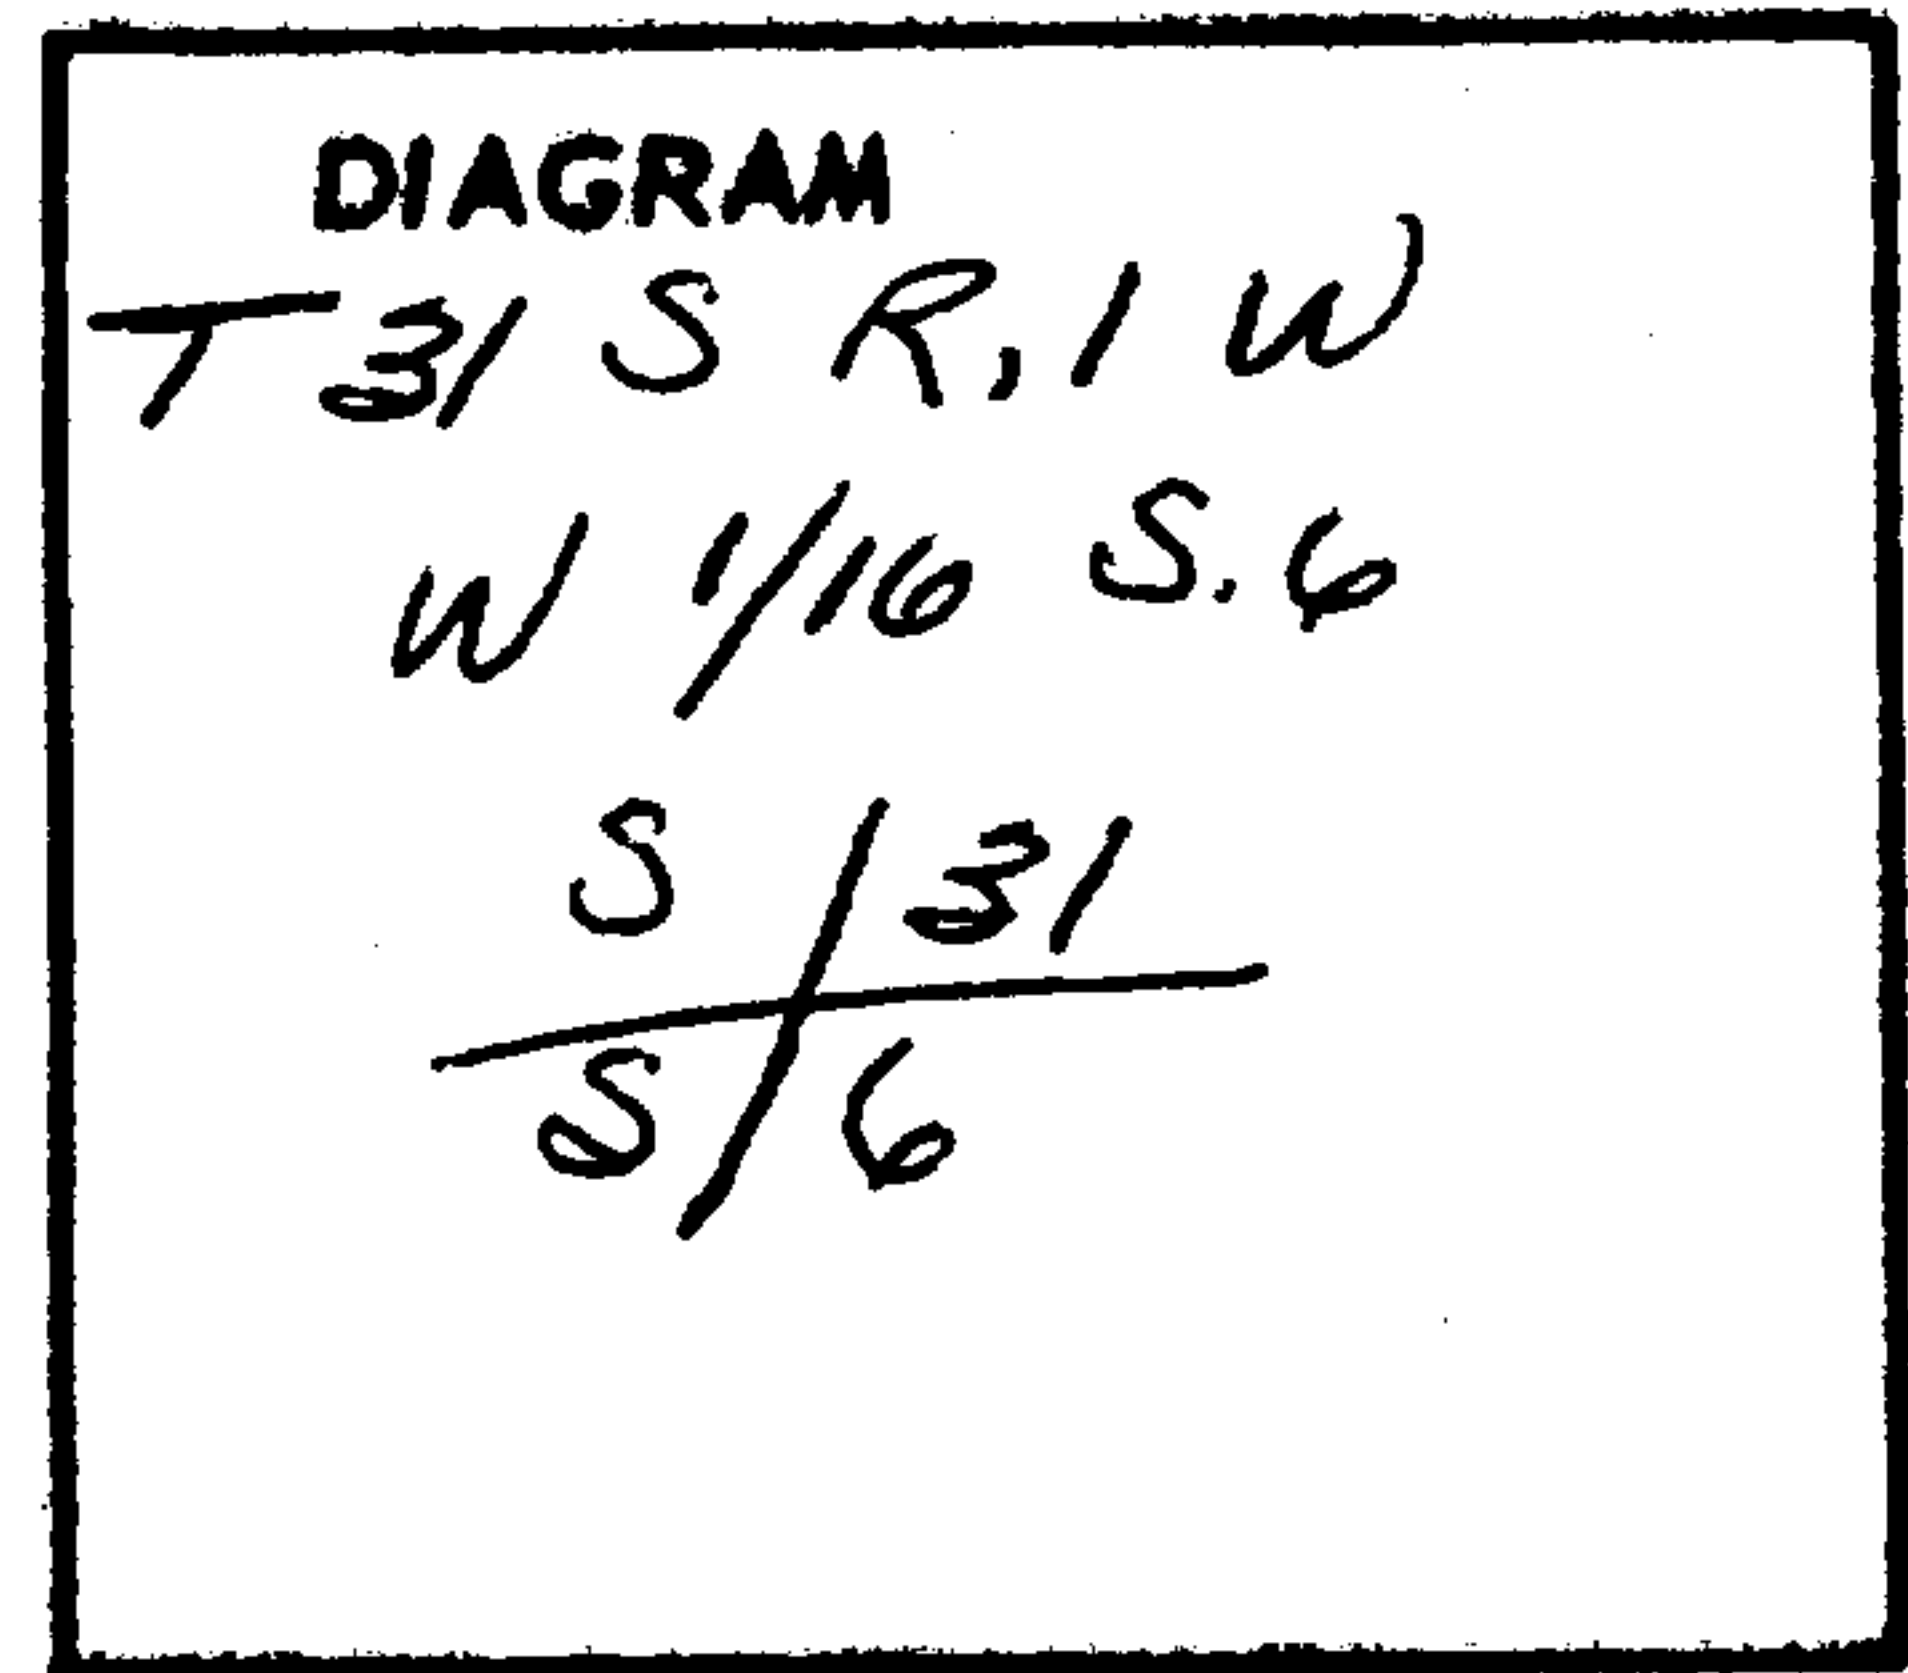


Description of corner evidence found:

None.

Description of monument and accessories I established to perpetuate the original location of this corner

I placed an iron pipe 30" long and 2" in diameter flaired at the bottom and capped with a bronze disk. The monument projects 6" inches above the ground. I filled in about the pipe monument with stone and packed earth.

I stamped the disk:

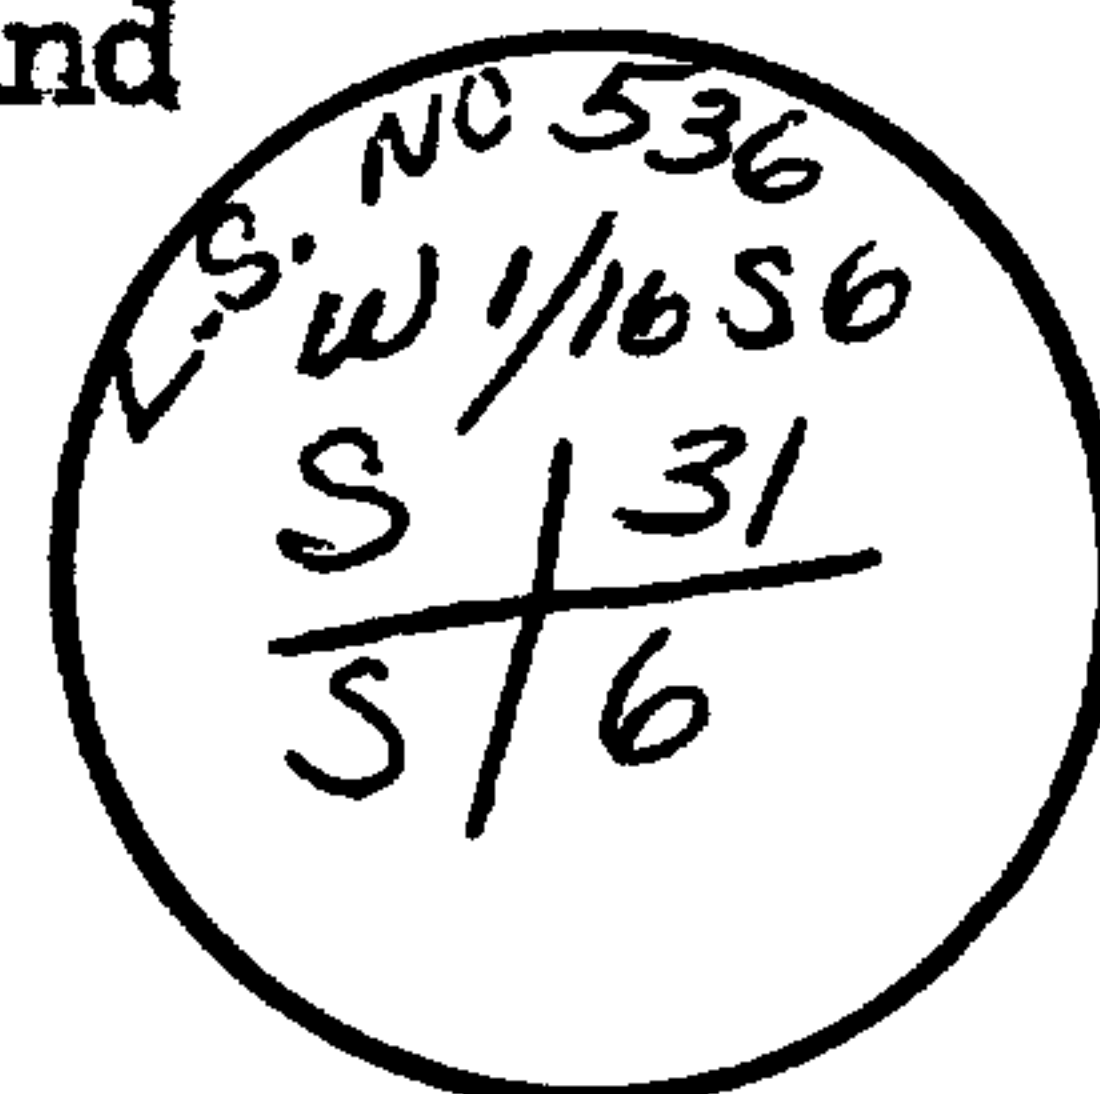


I established two new witness trees; a 6" Douglas fir which bears S 14° E. and a distance of 30.3 ft. ; blazed and scribed W 1/16 S.6, B.T. also a 20" White fir which bears N 45° W. and a distance of 43.5 ft.; blazed and scribed W 1/16 S. 31, B.T.

Office of..... County of.....
 State of....., I hereby certify that the within instrument was filed in this office
 for record on the day of; 19....., at..... o'clockm., (signed)
 by
 (COUNTY OFFICIAL) (DEPUTY)

CERTIFIED RECORD OF LAND CORNER MONUMENTATION

History of original corner establishment:

No previous corner had been set.

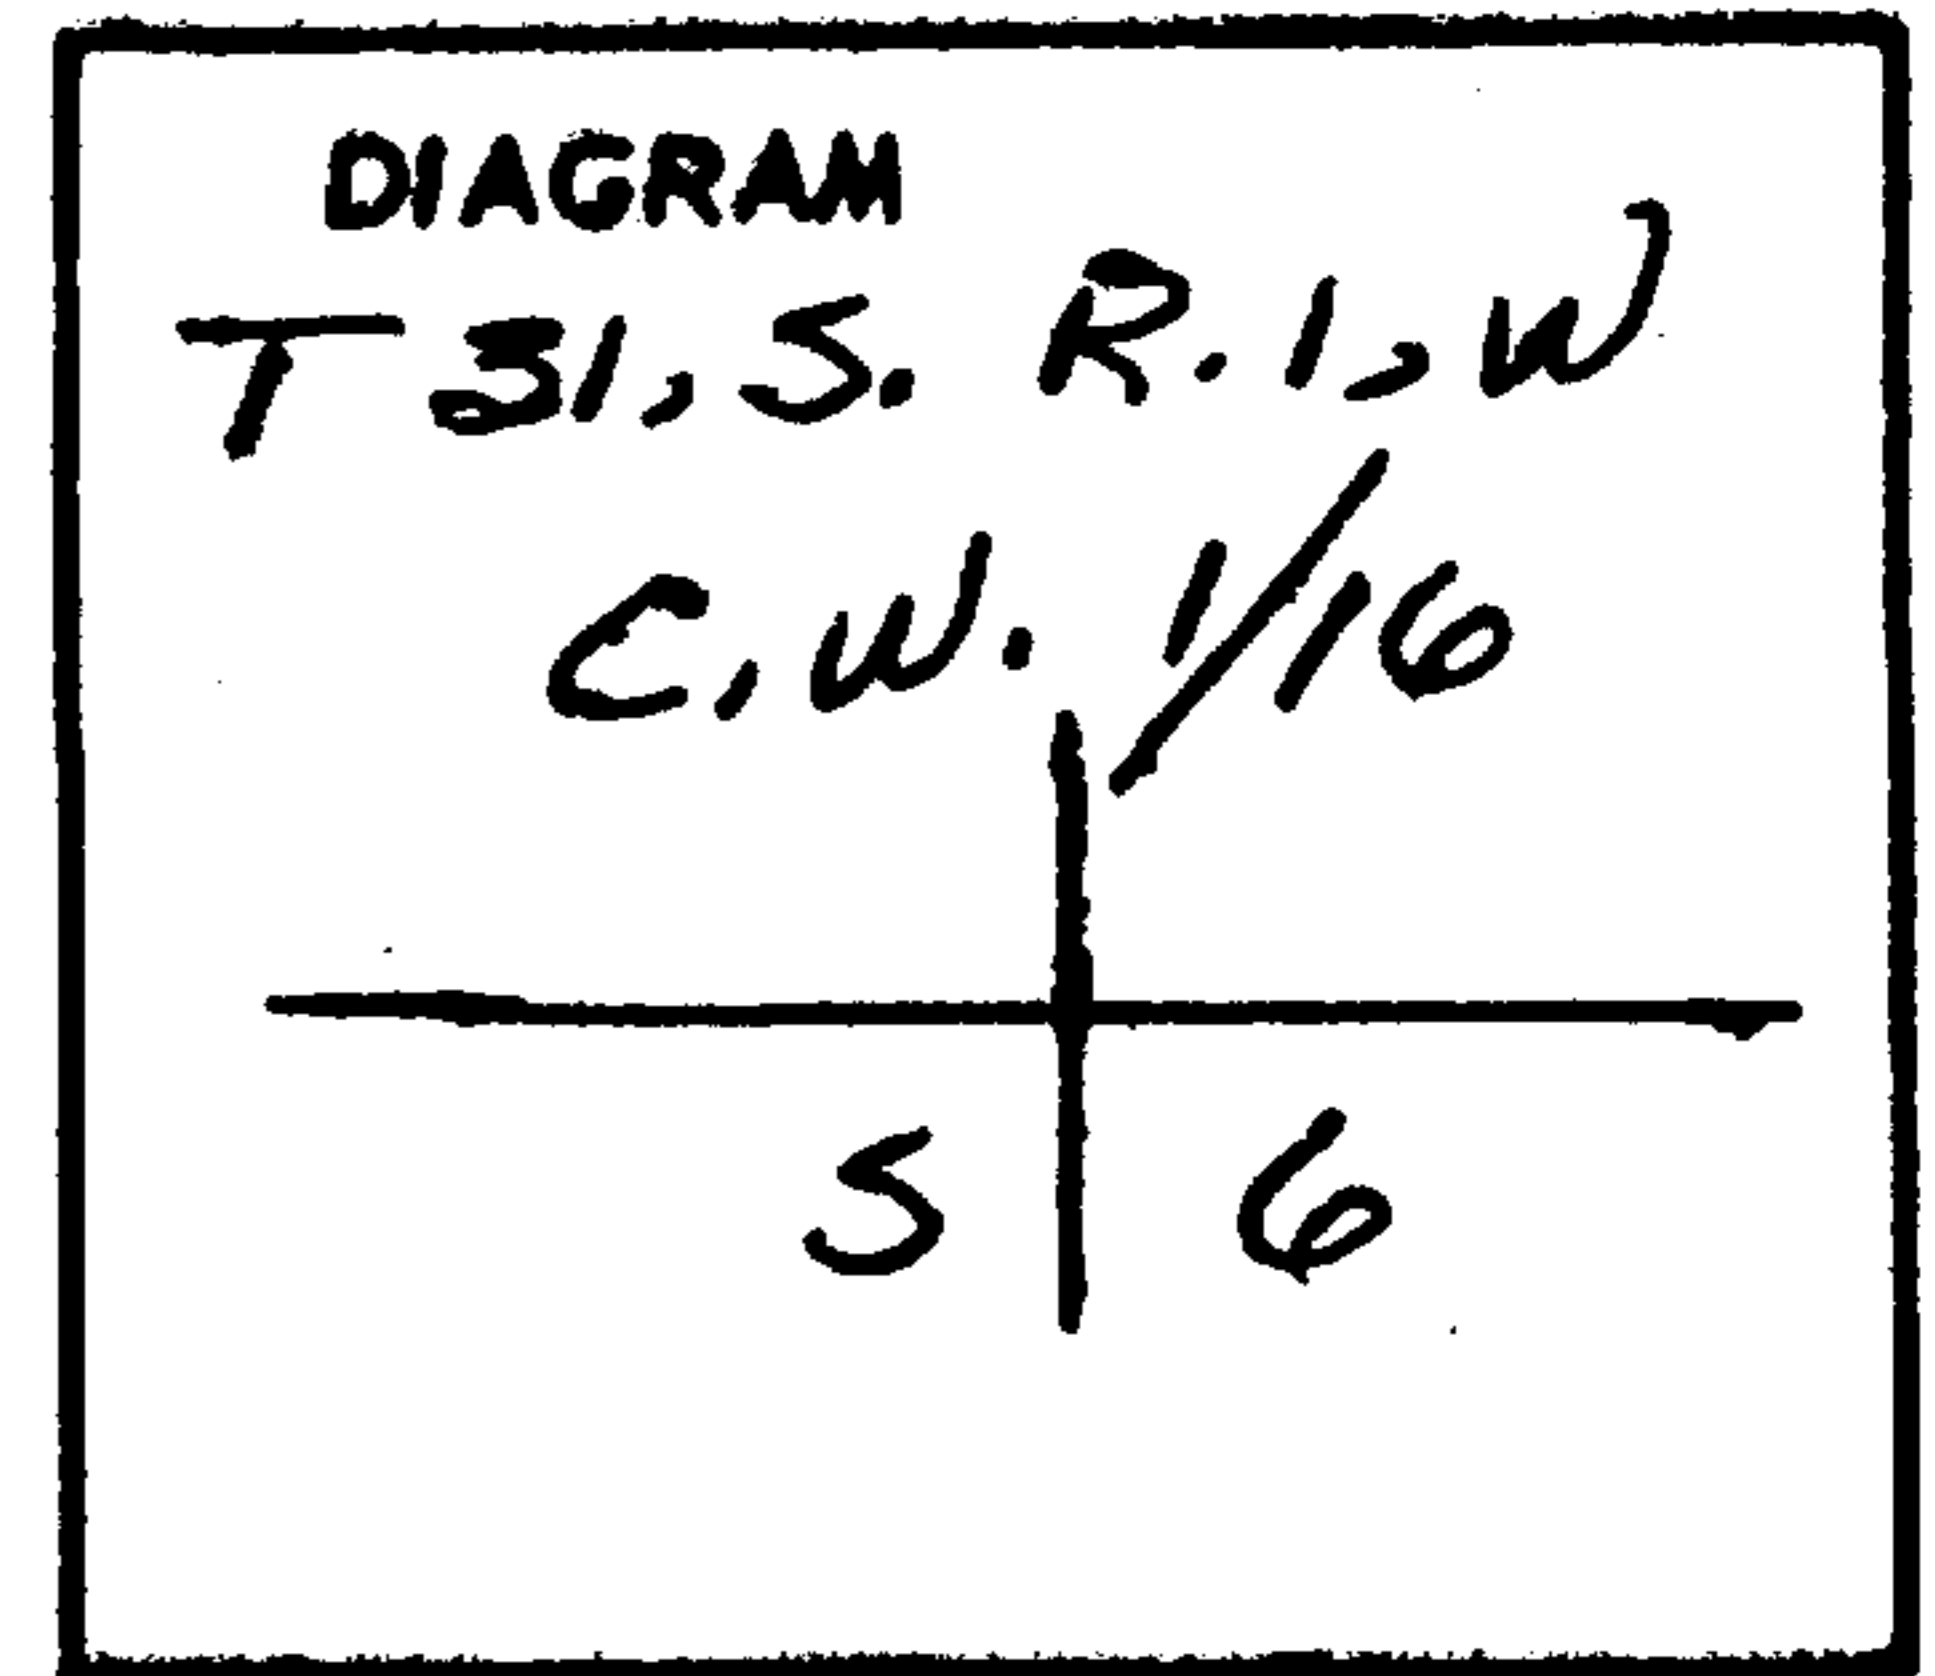


Description of corner evidence found:

None.

Description of monument and accessories I established to perpetuate the original location of this corner

I placed an iron pipe 30" long and 2" in diameter, flared at the bottom and capped with a bronze disk. Monument projects 6 inches above ground. I filled in around the pipe with stone and packed earth.

I stamped the disk:

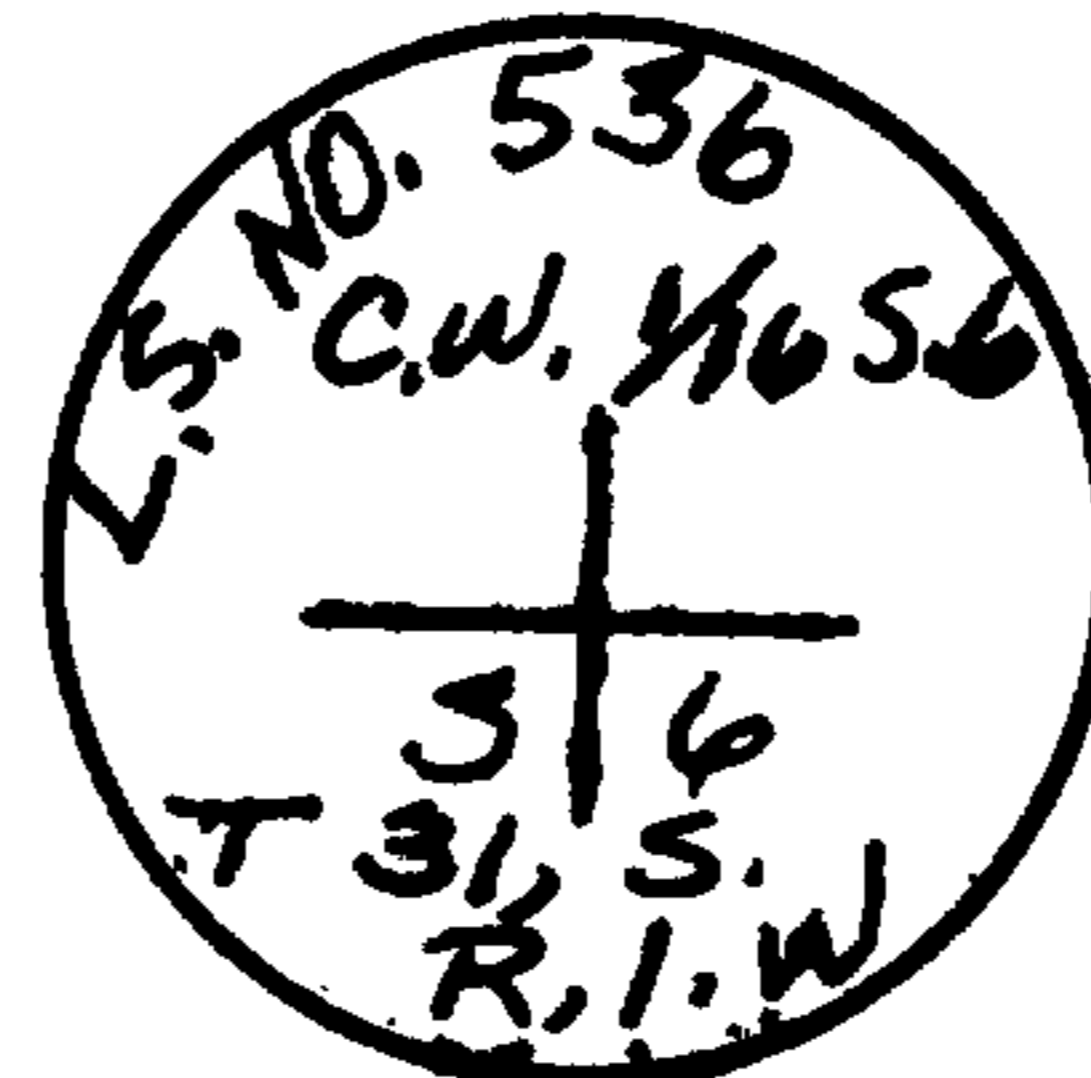


I established two new witness trees, a 5" cedar which bears S. 70° E. and a distance of 22.6 ft.; blazed and scribed C.W. 1/16 S.6., B.T., also a 4" Cedar which bears N.64° E. and a distance of 15.4 ft., blazed and scribed C.W. 1/16 S.6. B.T.

Office of..... County of.....
 State of....., I hereby certify that the within instrument was filed in this office
 for record on the day of; 19....., at..... o'clockm., (signed)
 by
 (COUNTY OFFICIAL) (DEPUTY)

CERTIFIED RECORD OF LAND CORNER MONUMENTATION

History of original corner establishment:

No corner had previously been set.

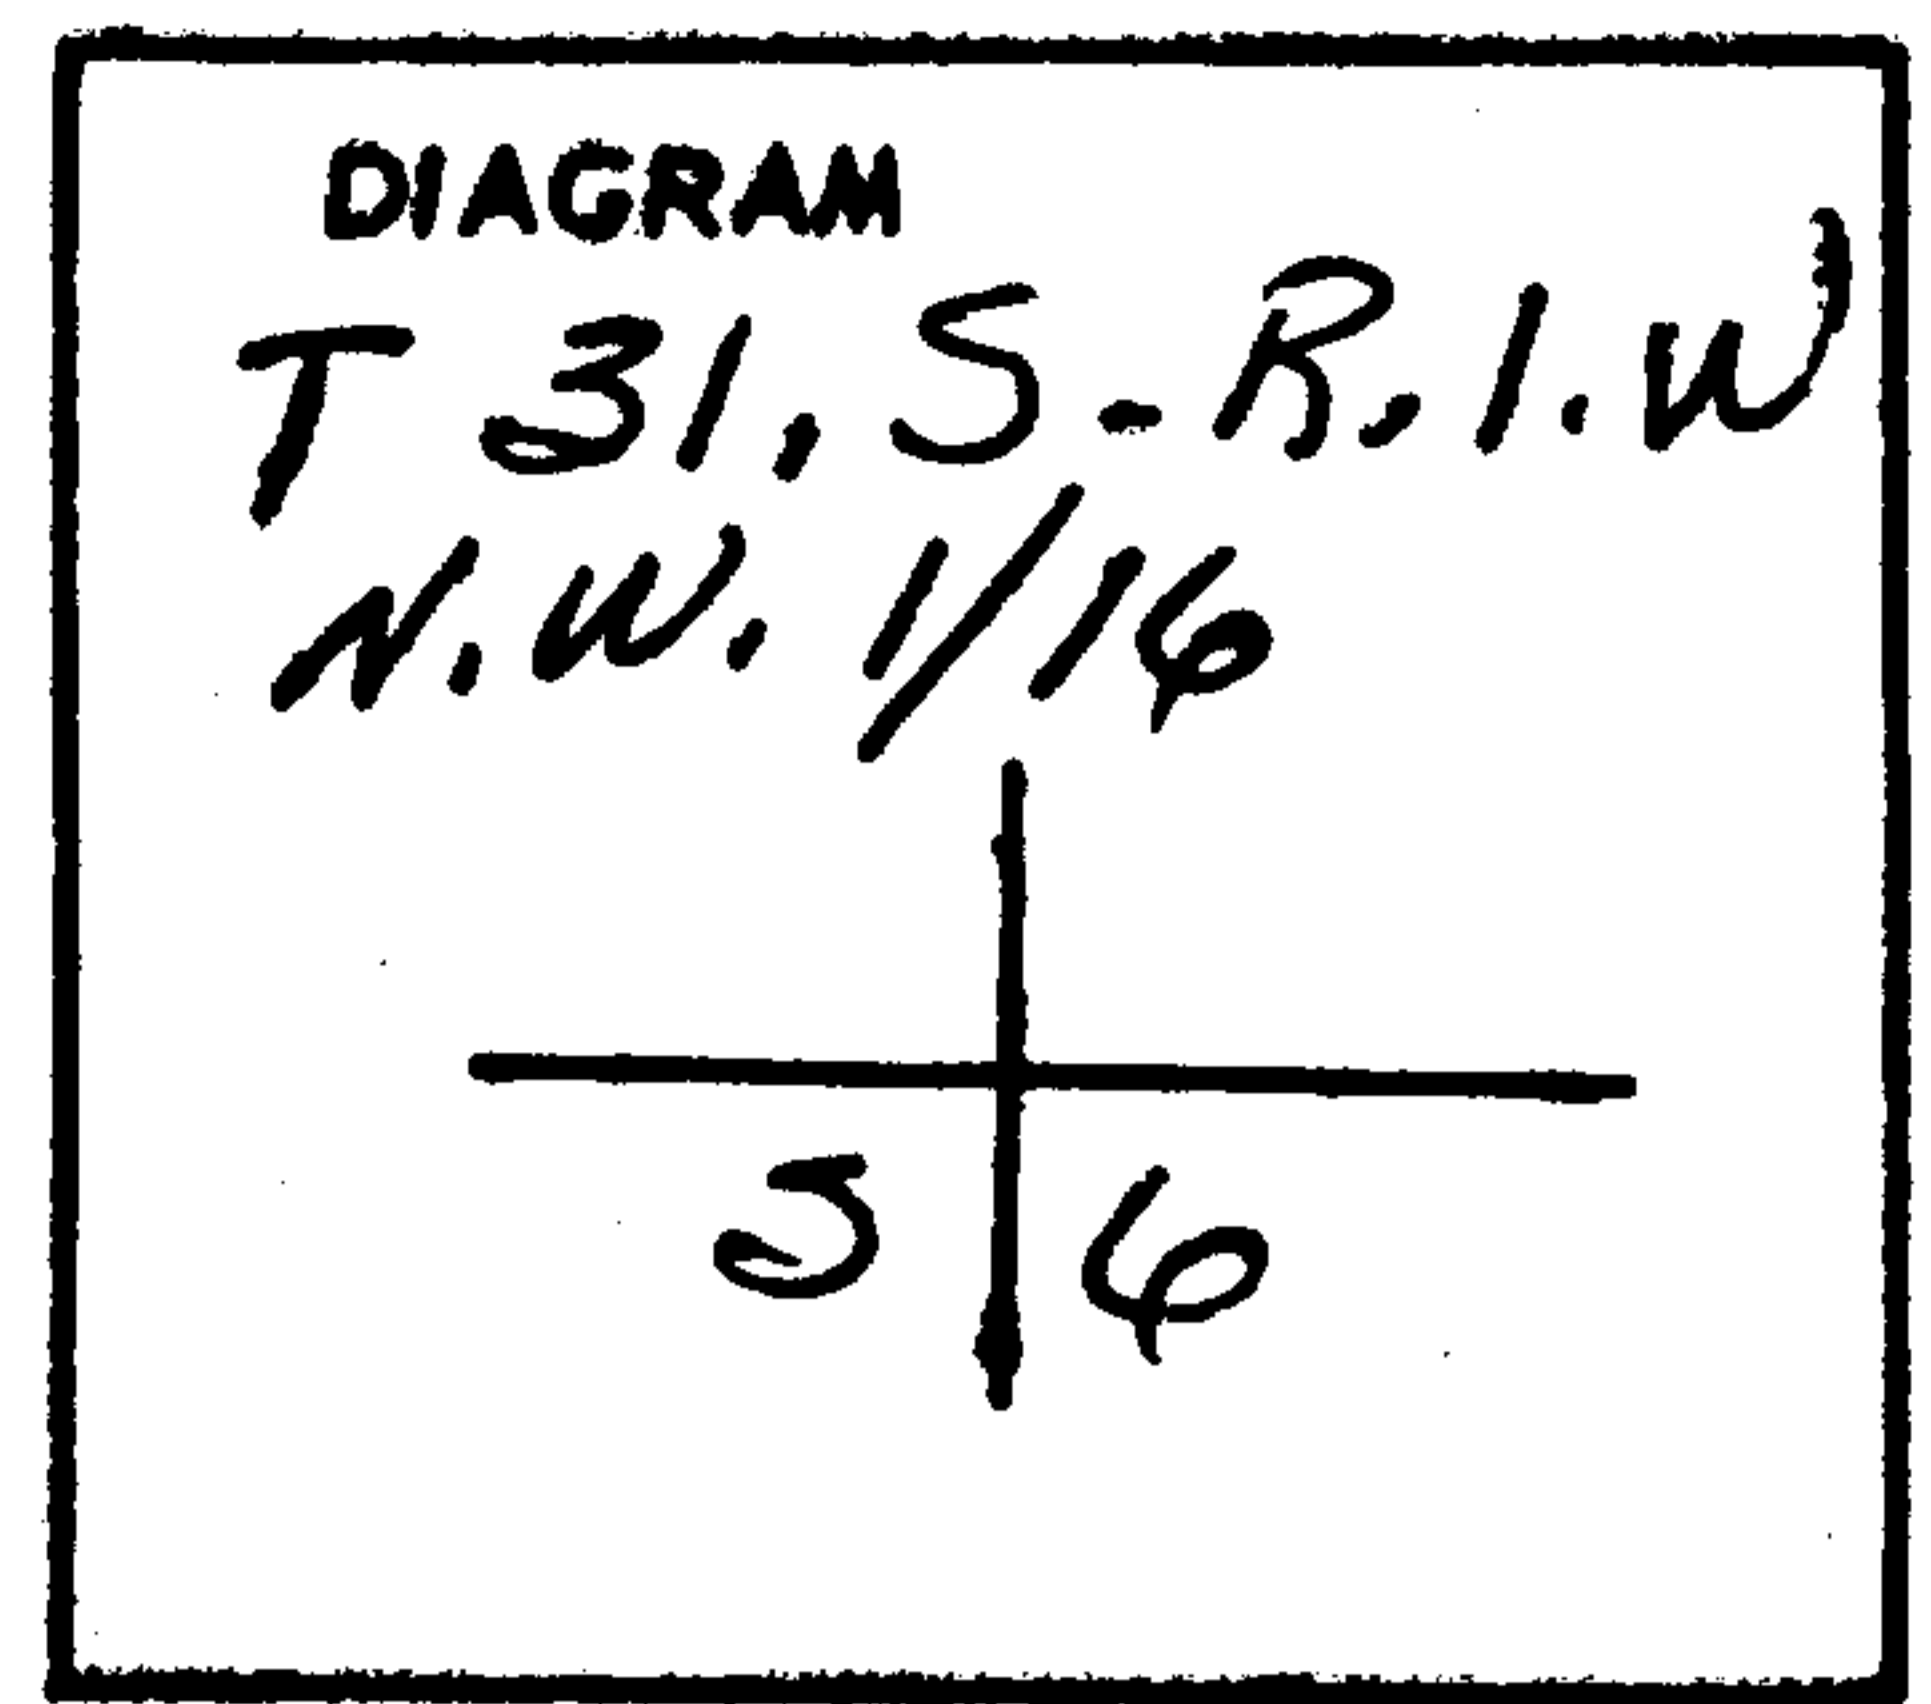


Description of corner evidence found:

None.

Description of monument and accessories I established to perpetuate the original location of this corner

I placed an iron pipe 30" long and 2" in diameter, flared at the bottom and capped with a bronze disk. Monument projects 6 inches above ground. I filled in around the pipe monument with stone and packed earth.

I stamped the disk:

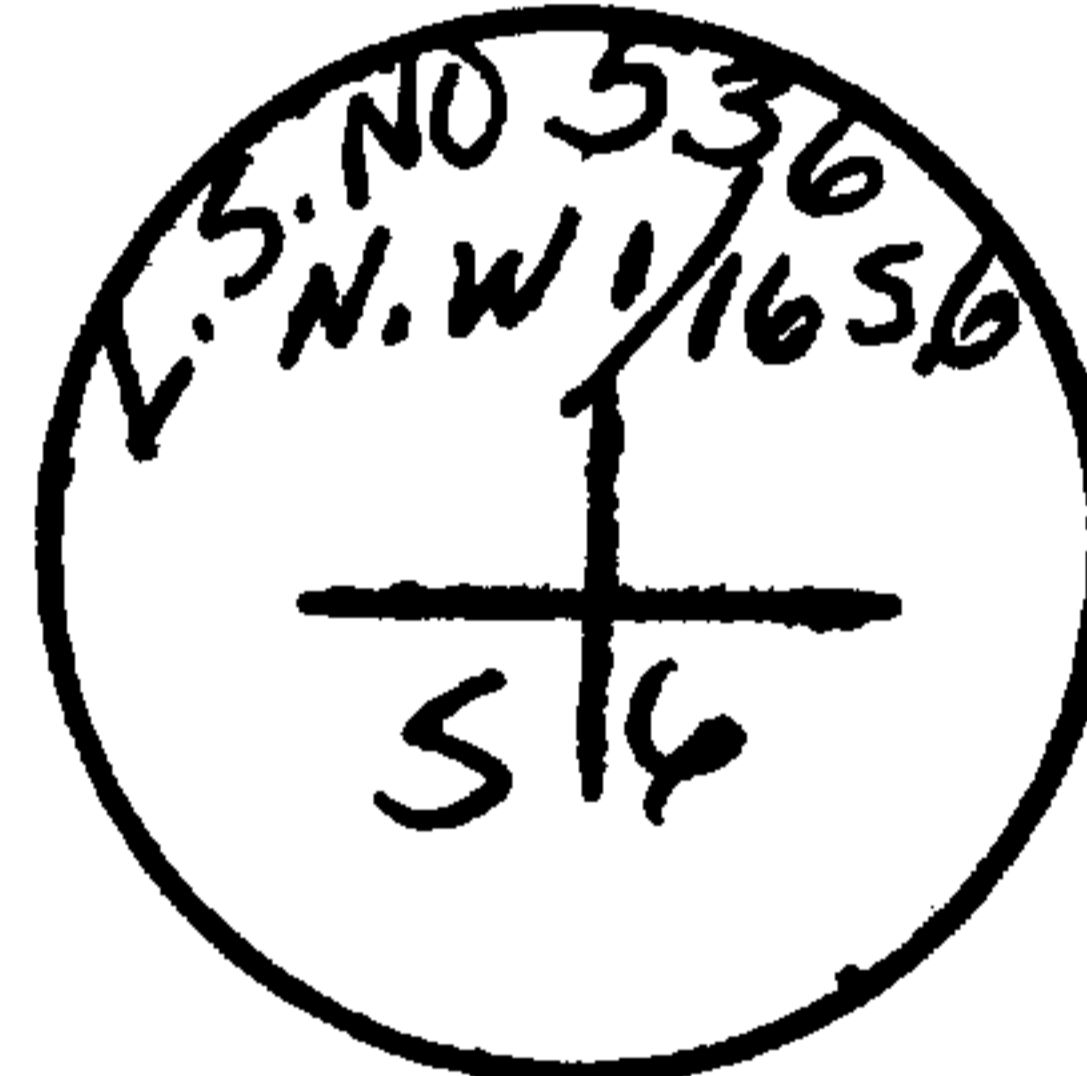


I also established two new witness trees a 16" Cedar which bears S $2\frac{1}{2}^{\circ}$ W. and a distance of 21.9 ft. blazed and scribed N.W. 1/16 S. 6., B.T. also a 10" Douglas Fir which bears N. 1° W. and a distance of 61.2 ft., blazed and scribed N.W. 1/16 S. 6, B.T.

Office of..... County of.....
State of....., I hereby certify that the within instrument was filed in this office
for record on the day of....., 19....., at..... o'clockm., (signed)
..... by.....
(COUNTY OFFICIAL) (DEPUTY)

CERTIFIED RECORD OF LAND CORNER MONUMENTATION

History of original corner establishment:

No previous corner had been set.

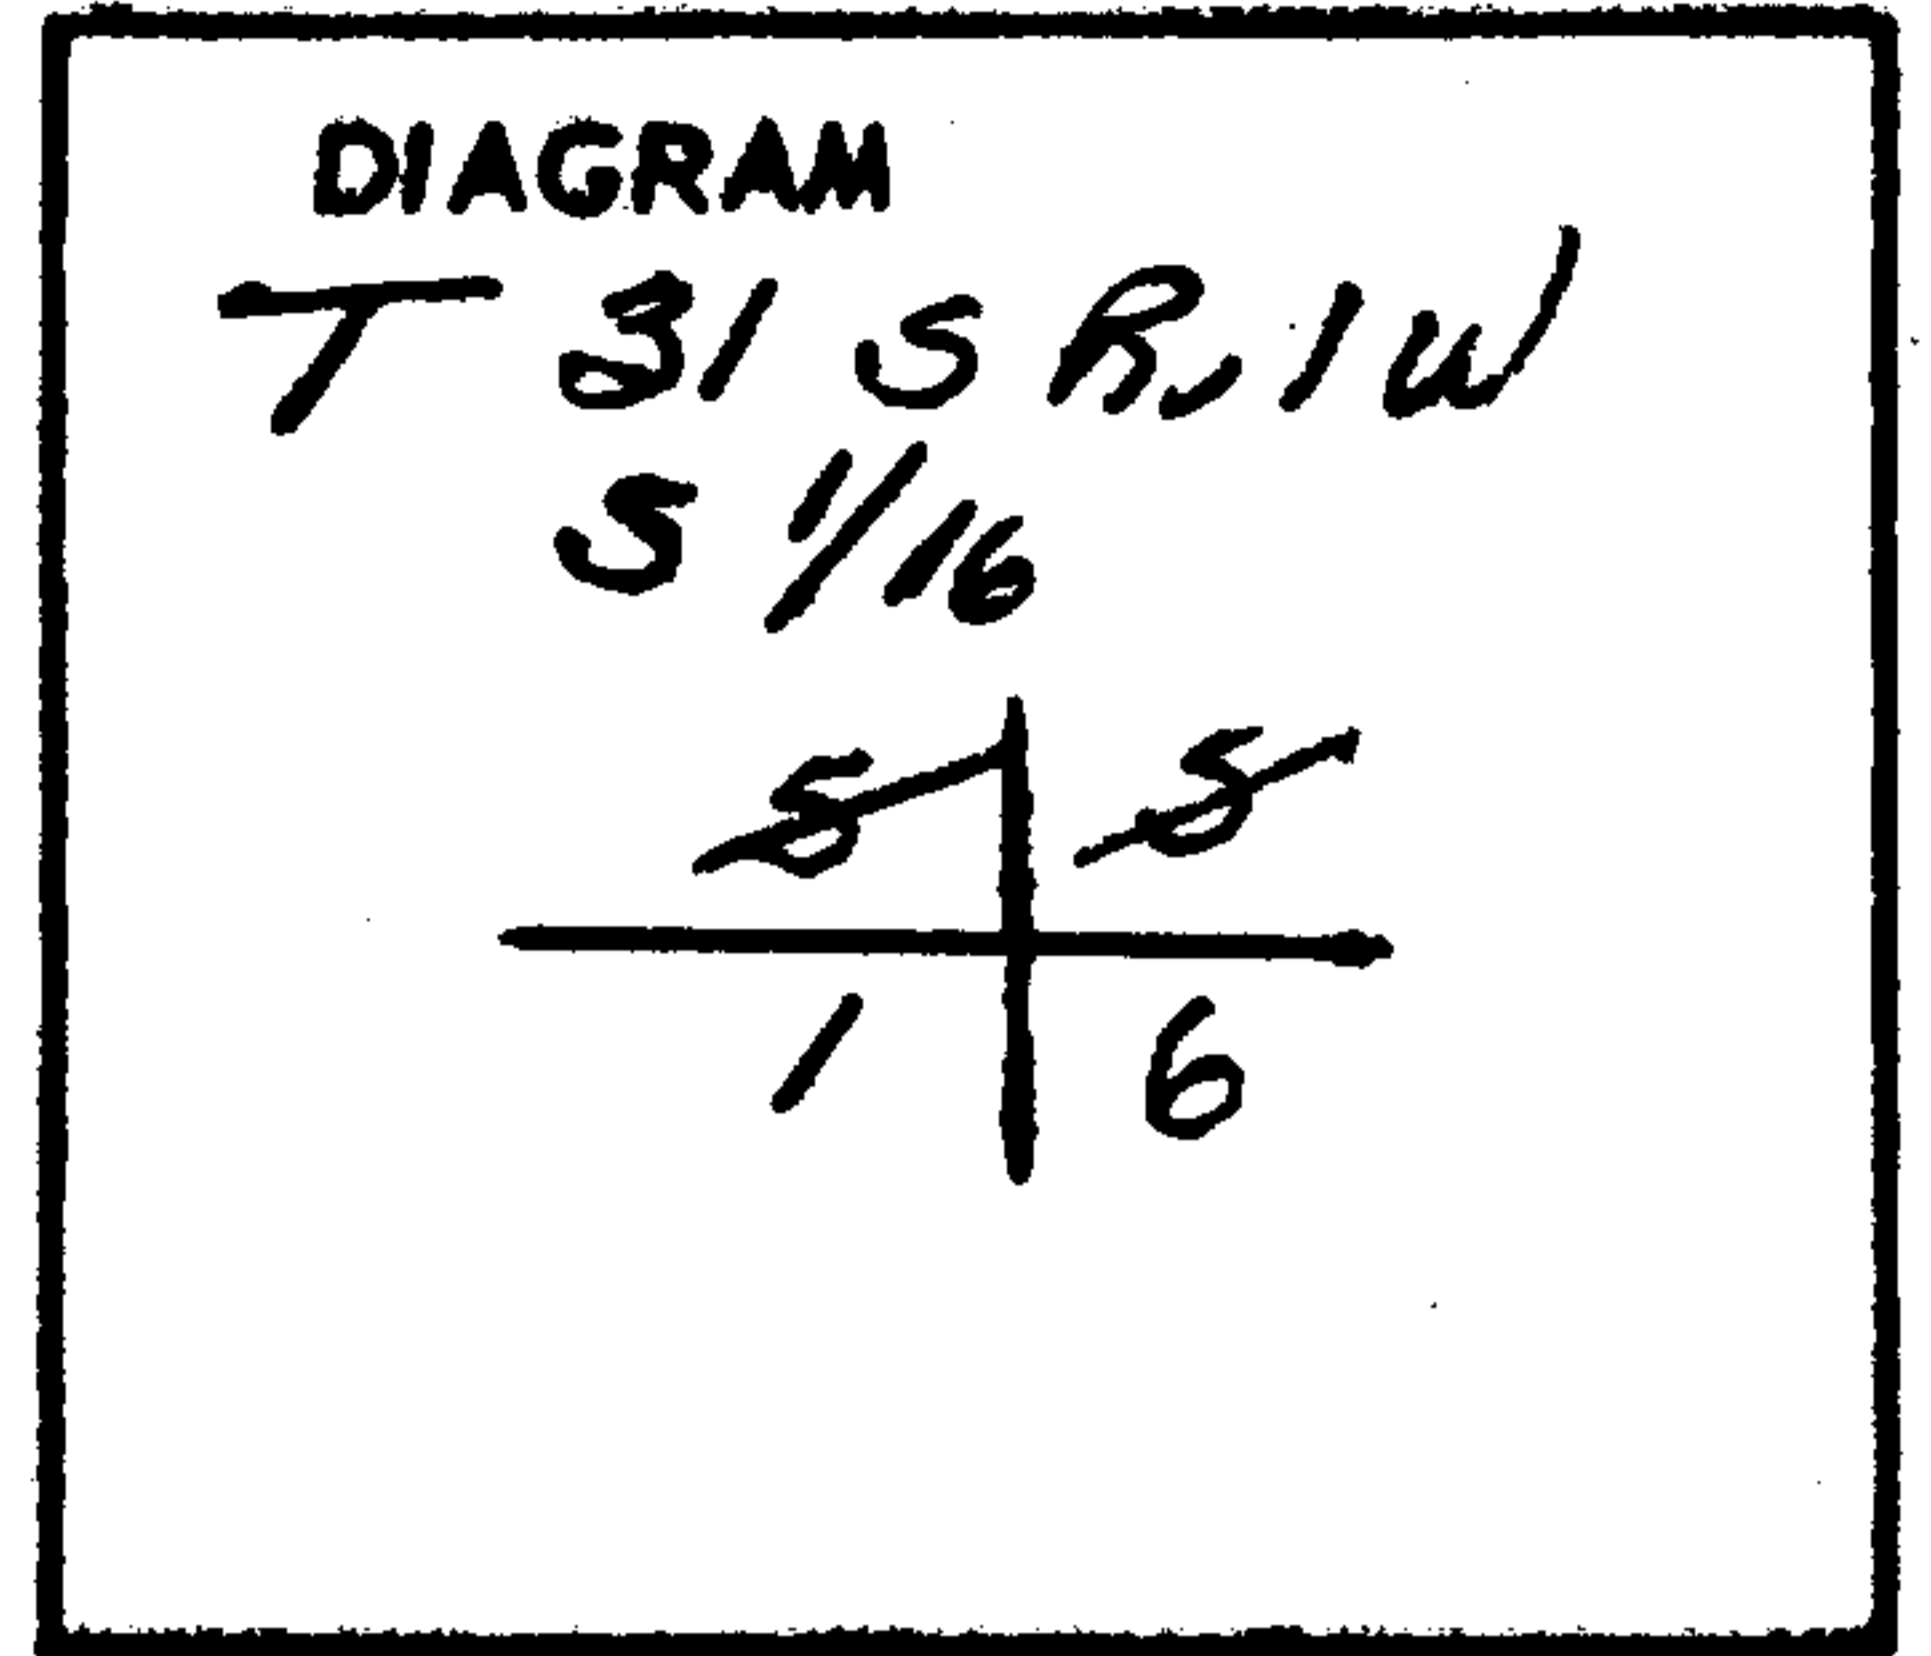


Description of corner evidence found:

none.

Description of monument and accessories I established to perpetuate the original location of this corner

I placed an iron pipe 30" long and 2" in diameter, flared at the bottom and capped with a bronze disk. Monument projects 6 inches above ground. I filled in about the pipe monument with stone and packed earth.

I stamped the disk:

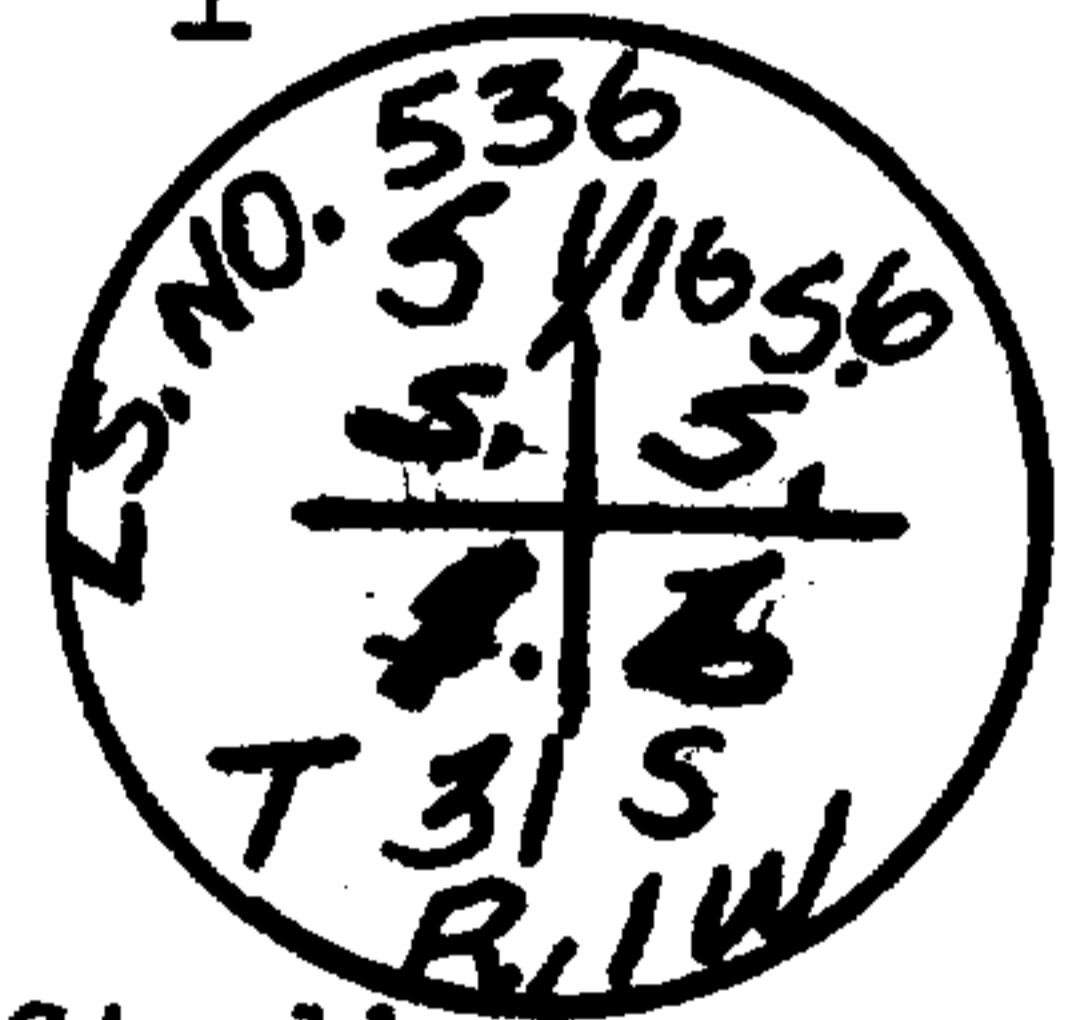

I established two new witness trees a 6" oak bears N. 21 $\frac{1}{2}$ ^o W. 32.3 ft. dist. blazed and scribed S 1/16 S.l., B.T. also a 12" oak which bears S. 12^o W. 35.1 ft. dist. blazed and scribed S 1/16 S.6., B.T.


Sl

Office of County of.....
 State of....., I hereby certify that the within instrument was filed in this office
 for record on the day of; 19....., at..... o'clockm., (signed)
 by
 (COUNTY OFFICIAL) (DEPUTY)

CERTIFIED RECORD OF LAND CORNER MONUMENTATION

History of original corner establishment:

No corner had been previously set.

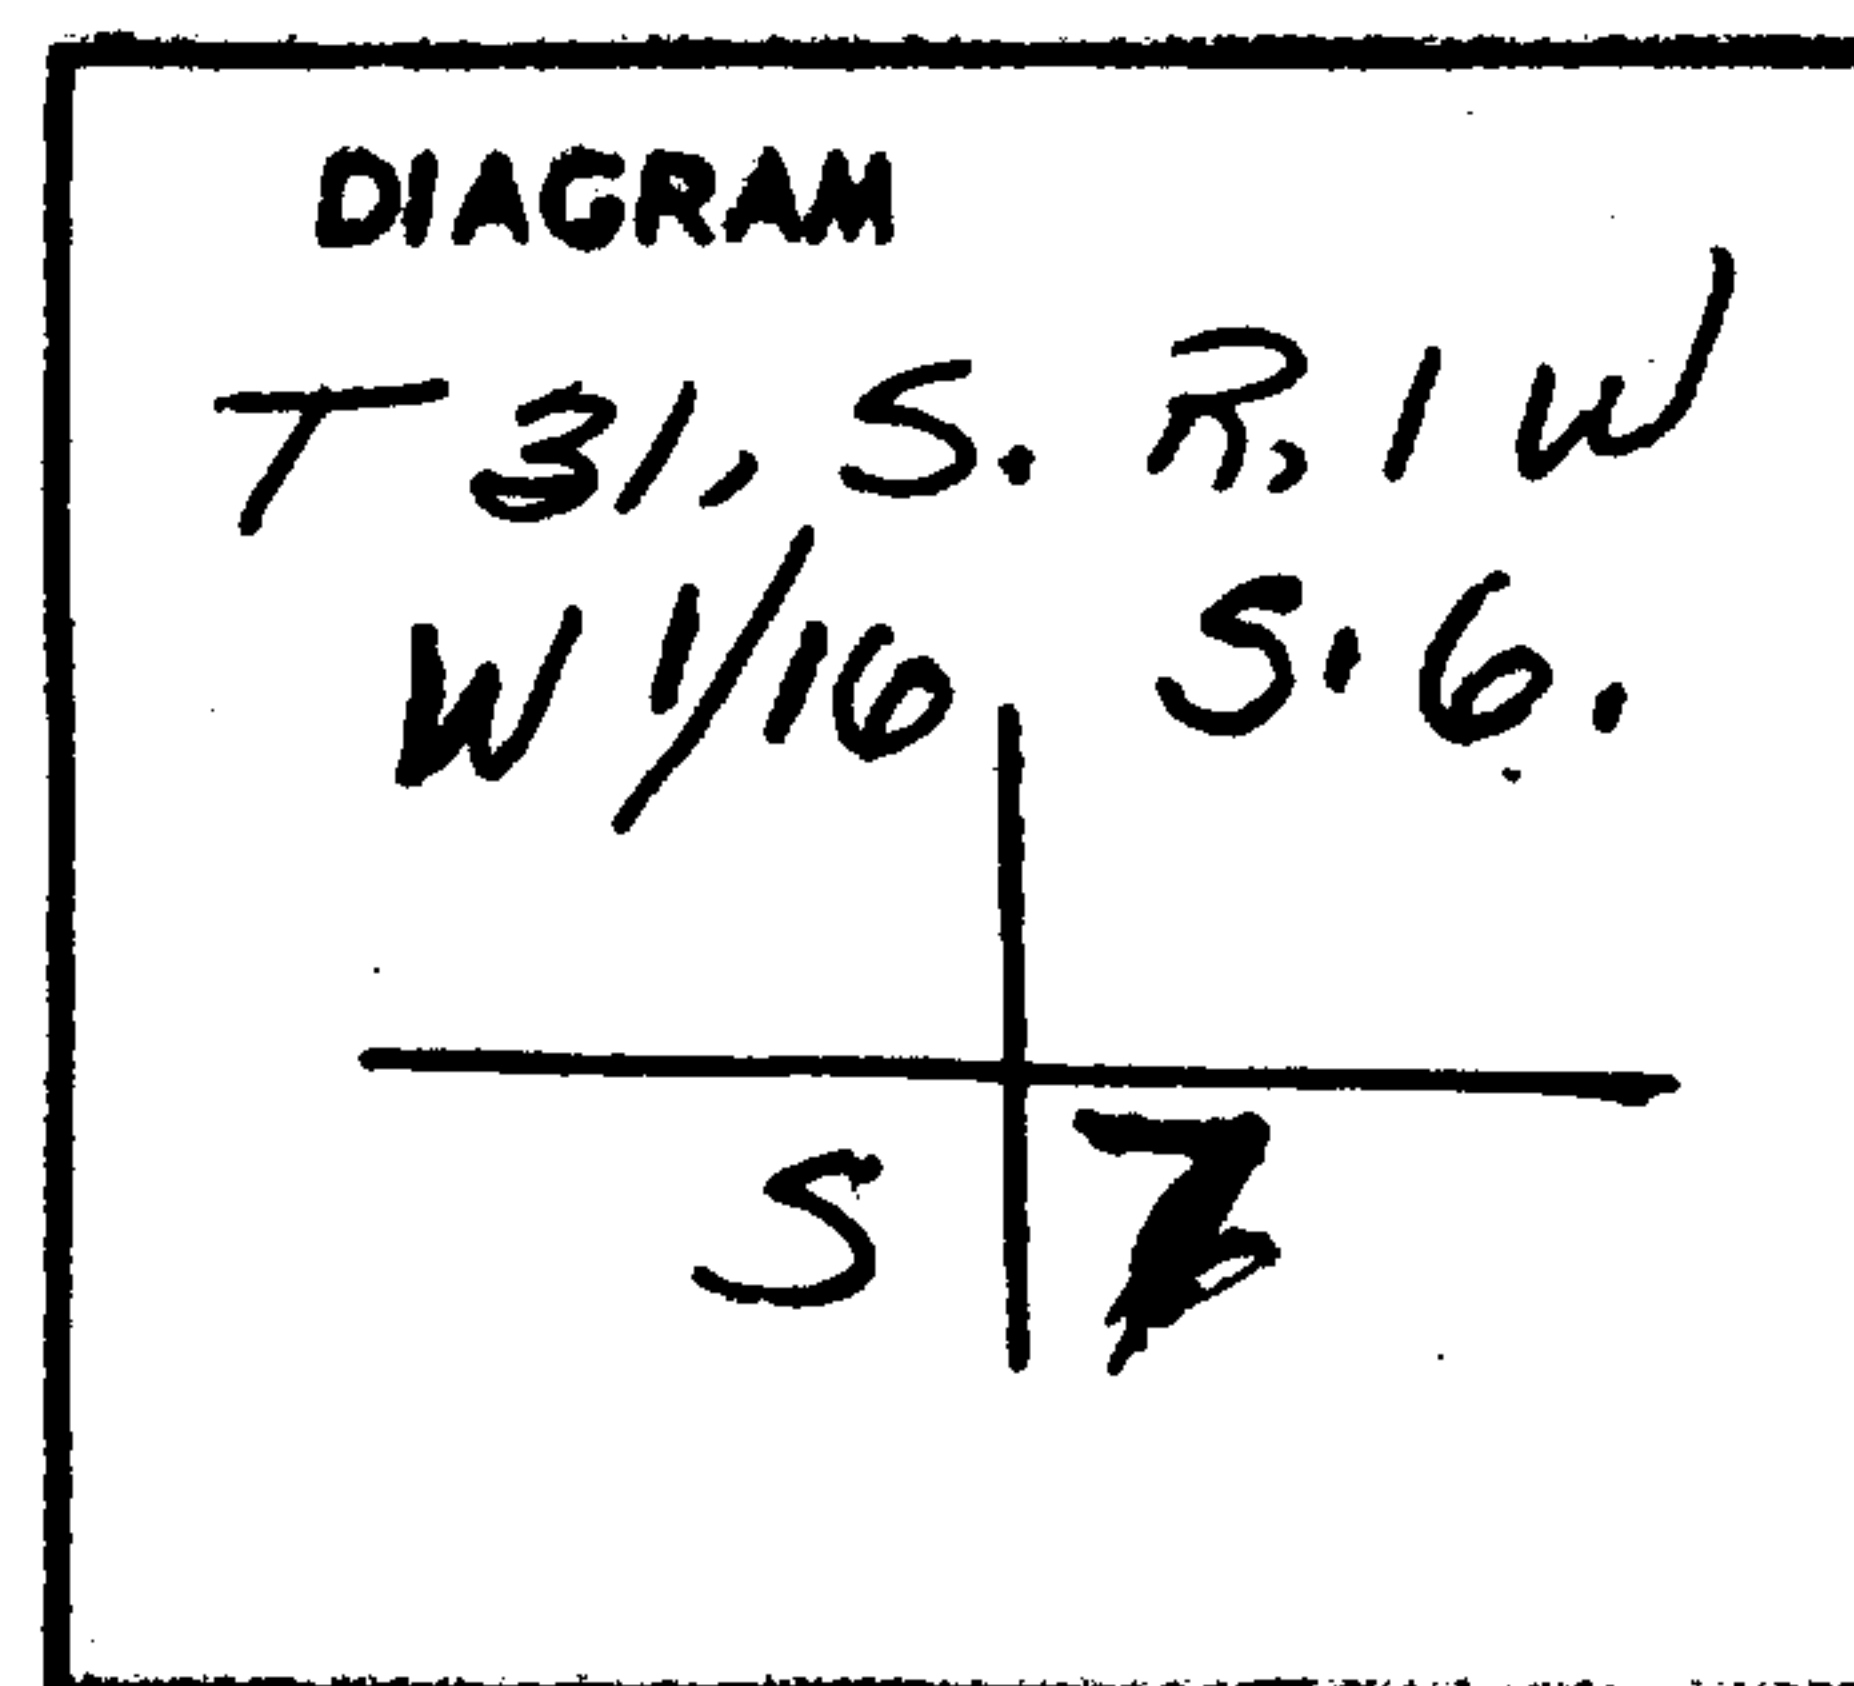


Description of corner evidence found:

None.

Description of monument and accessories I established to perpetuate the original location of this corner

I placed an iron pipe 30" long and 2" in diameter, flared at the bottom and capped with a bronze disk. Monument projects 6 inches above ground. I filled in around the pipe monument with stone and packed earth.

I stamped the disk:

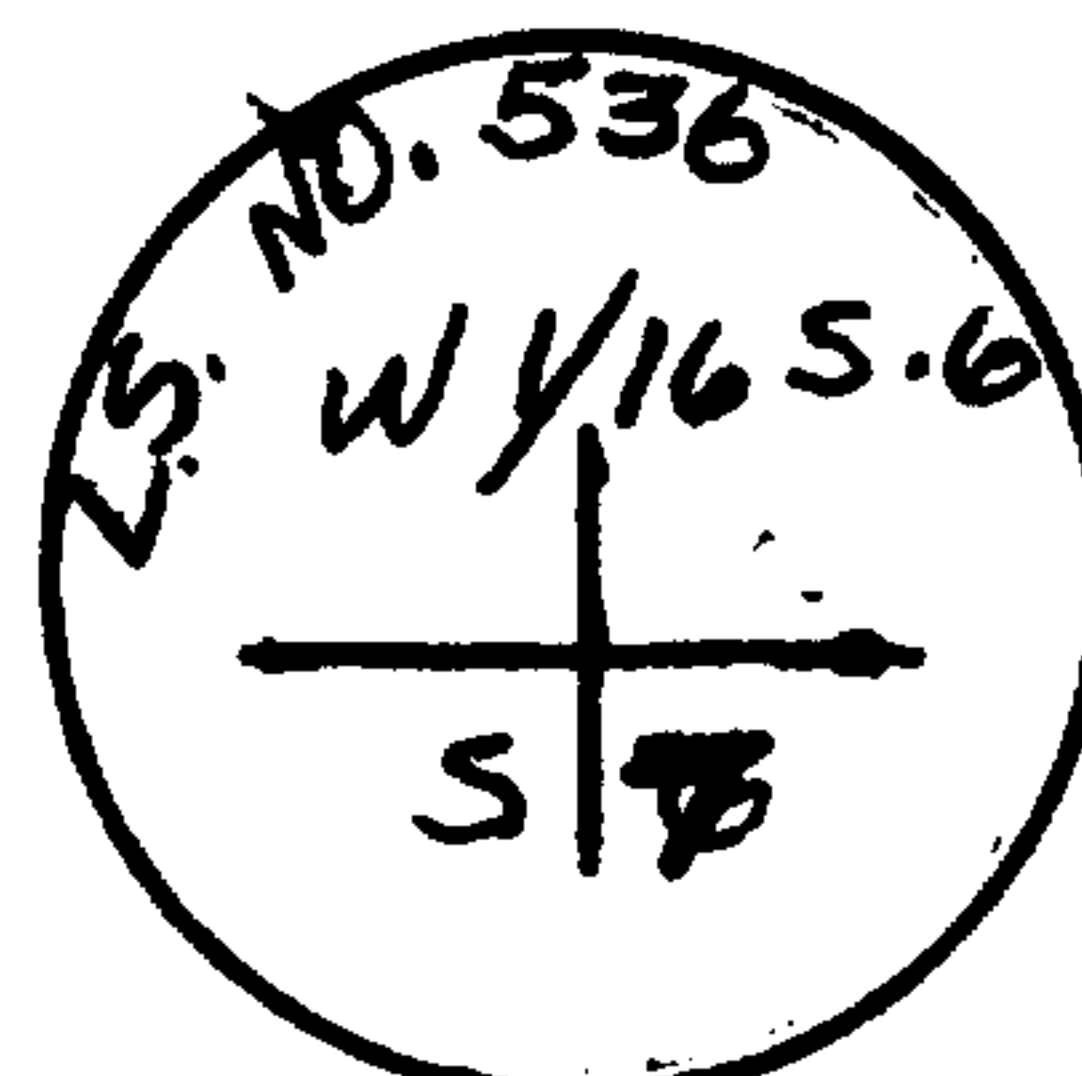


I established two new witness trees a 14" Douglas Fir which bears N.63° E. and a distance of 52.5 ft.; blazed and scribed W 1/16 S.6., B.T. also a 24" Oak which bears S 23° E. and a distance of 71.0 ft.; blazed and scribed W1/16 S.7., B.T.

Office of County of.....
 State of....., I hereby certify that the within instrument was filed in this office
 for record on the day of; 19....., at..... o'clockm., (signed)
 by
 (COUNTY OFFICIAL) (DEPUTY)

CERTIFIED RECORD OF LAND CORNER MONUMENTATION

History of original corner establishment:

Original survey by Dennis Hathorn, Deputy Surveyor.
 Under his contract No. 73, dated June 8th, 1857.
 Set post, cor. Sec's. 6,7,1 and 12, from which an Oak, 10"
 in diam. which bears N. 14° W., 100 lks. dist., an Oak, 12"
 in diam. which bears N. 28° E., 36 lks. in dist., an Oak, 9"
 in diam. which bears S 18° W., 79 lks. in dist., a pine
 24" in diam. which bears S. 68° E., 49 lks. in dist.

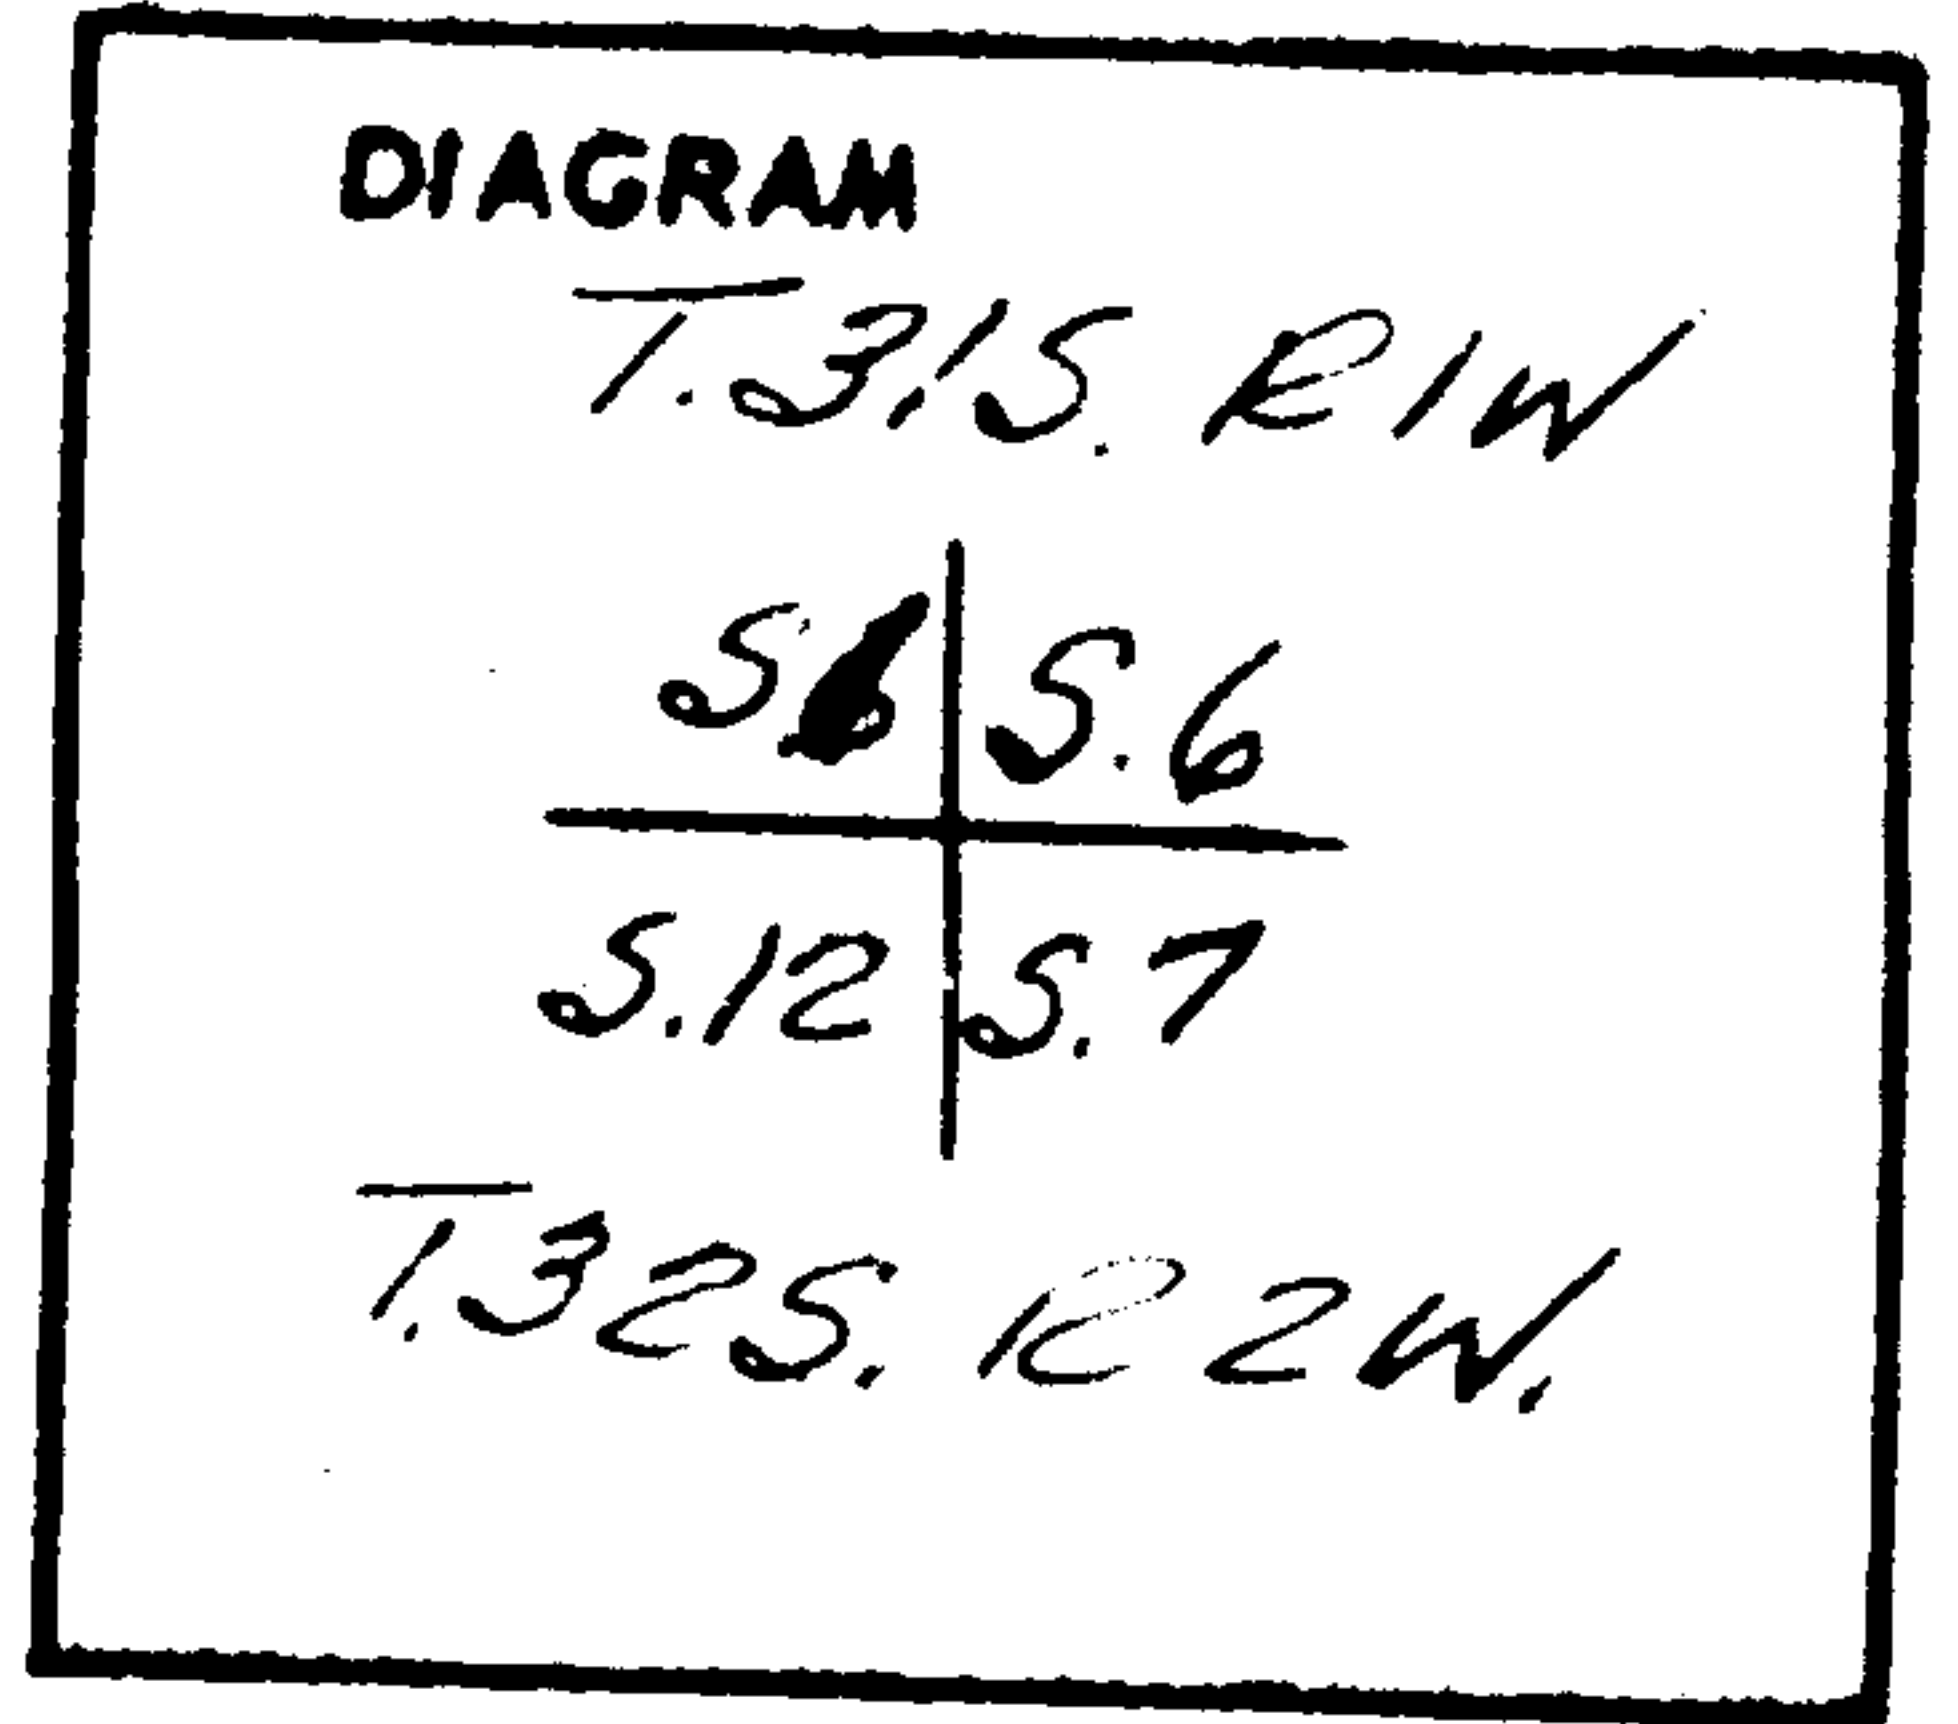


Description of corner evidence found:

I found one tree, a pine 48" in diameter which had been burned and cut out, but found no legible scribe. We also found a 1/2" pipe which has evidently been used as the section corner. This pipe is situated 13' North of a East-West fence which we found by proportion to be nearer the correct distance.

Description of monument and accessories I established to perpetuate the original location of this corner

I placed an iron pipe 30' ft. long and 2" in. in diam., flared at the bottom and capped with a bronze disk. Monument projects 6 inches above ground. I filled in around the pipe monument with stone and packed earth. 3' north of an East-West fence & in line with North fence.

I stamped the disk:

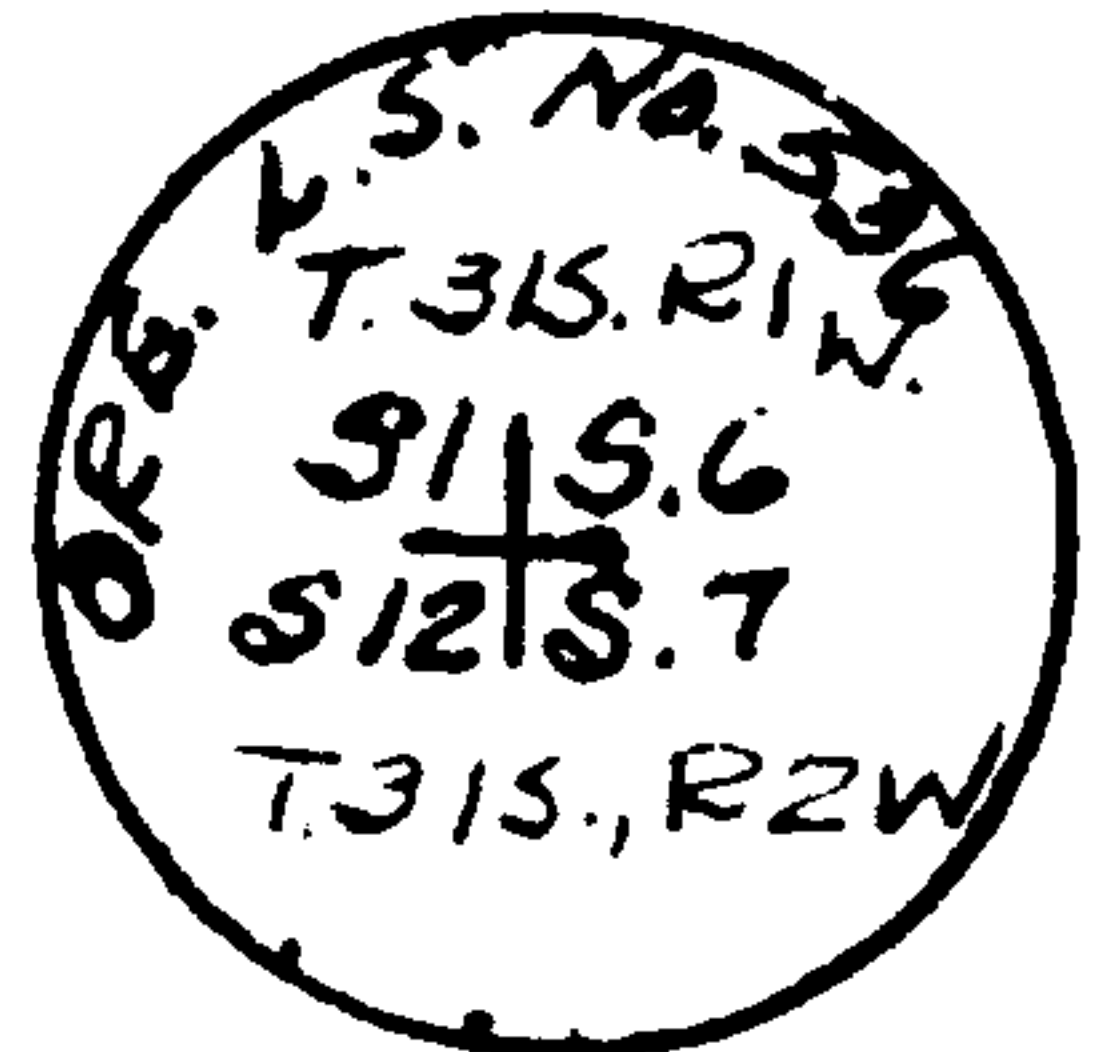


I also established four witness trees. A sugar pine 16" in diam. which bears N. 54° W. and 1.7' ft. in dist. Blazed and scribed T 31 S. R 1 W. S 1., B.T. also a Douglas Fir 8" in diam. which bears N. 14 1/2° E. and 51.7 in dist., blazed and scribed T 31 S., R 2 W. S. 7., B.T. also a 10" Douglas fir which bears S 86° E and 35.6 in dist., blazed and scribed T 31 S, R 2 W. S 12., B.T. also a 10" cedar which bears S 34 1/2° W. and 15.9 in dist., blazed and scribed T 31 S, R 1 W. S 6., B.T.

Office of County of
 State of , I hereby certify that the within instrument was filed in this office
 for record on the day of , 19..... , at o'clock m., (signed)
 by
 (COUNTY OFFICIAL) (DEPUTY)

CERTIFIED RECORD OF LAND CORNER MONUMENTATION

History of original corner establishment:

Original survey by Dennis Hathorn Deputy Surveyor,
Under contract No. 73, dated June 8, 1857
Set 1/4 sec. post from which, a fir, 15" bears N. 45° E.,
80 lks. dist. also an oak, 12" diameter, which bears
S 70° W, 183 lks. dist.

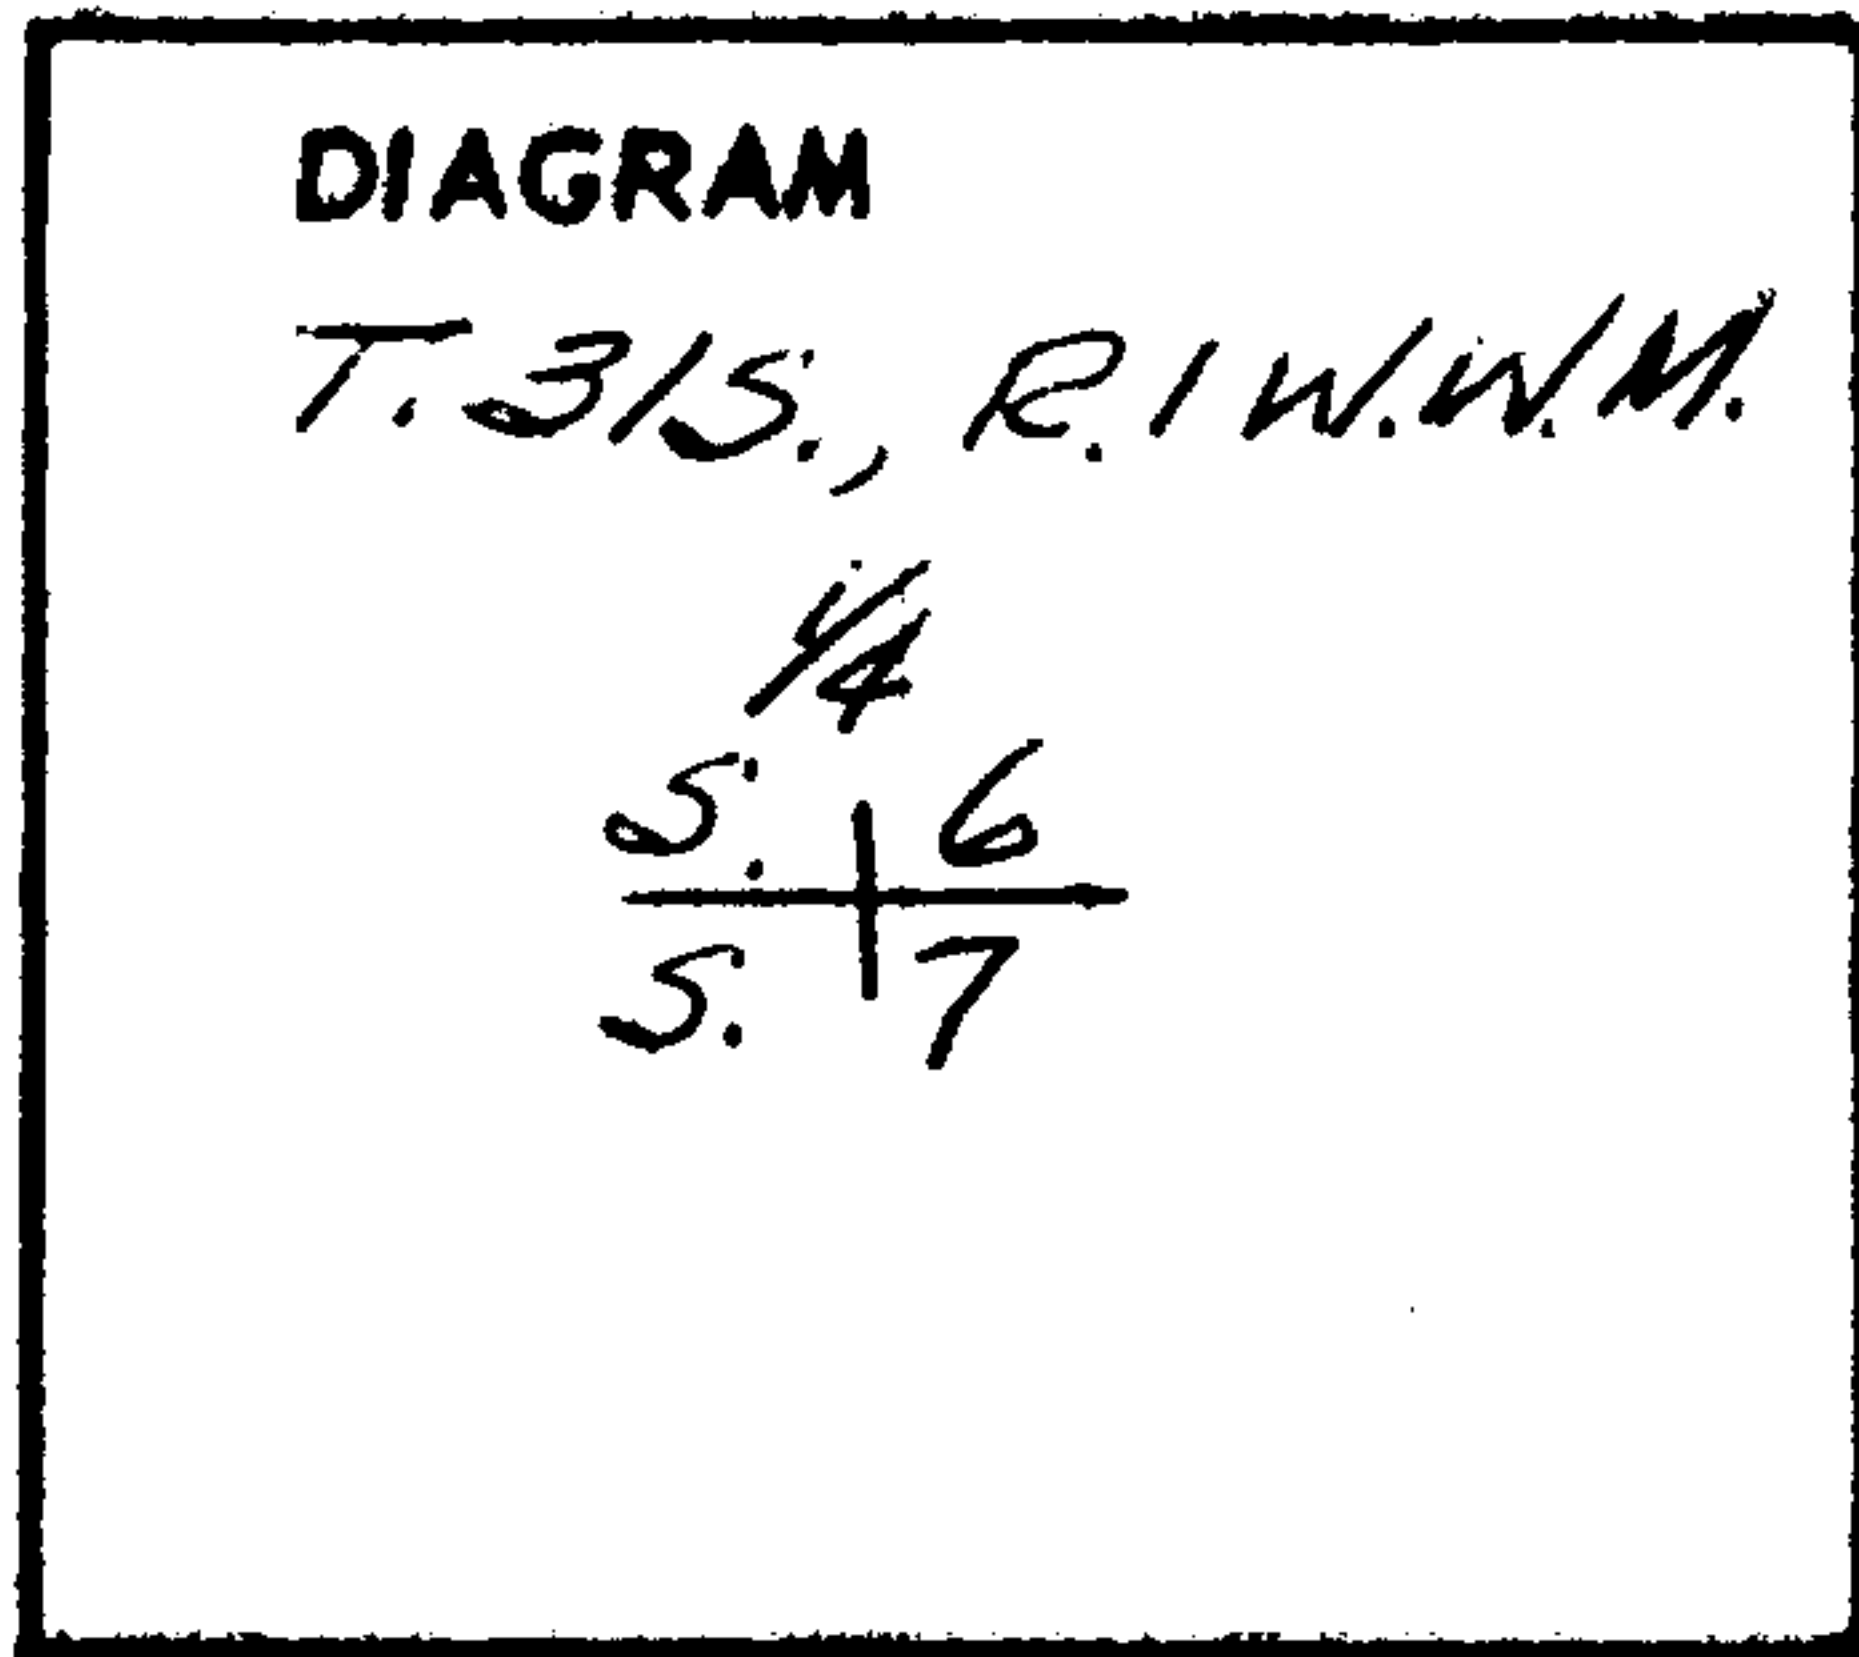


Description of corner evidence found:

None

Description of monument and accessories I established to perpetuate the original location of this corner

I placed an iron pipe 30" long and 2" in diameter, flared at the bottom and capped with a bronze disk. Monument projects 6 inches above ground I filled in about the pipe monument with stone and packed earth.

I stamped the disk.

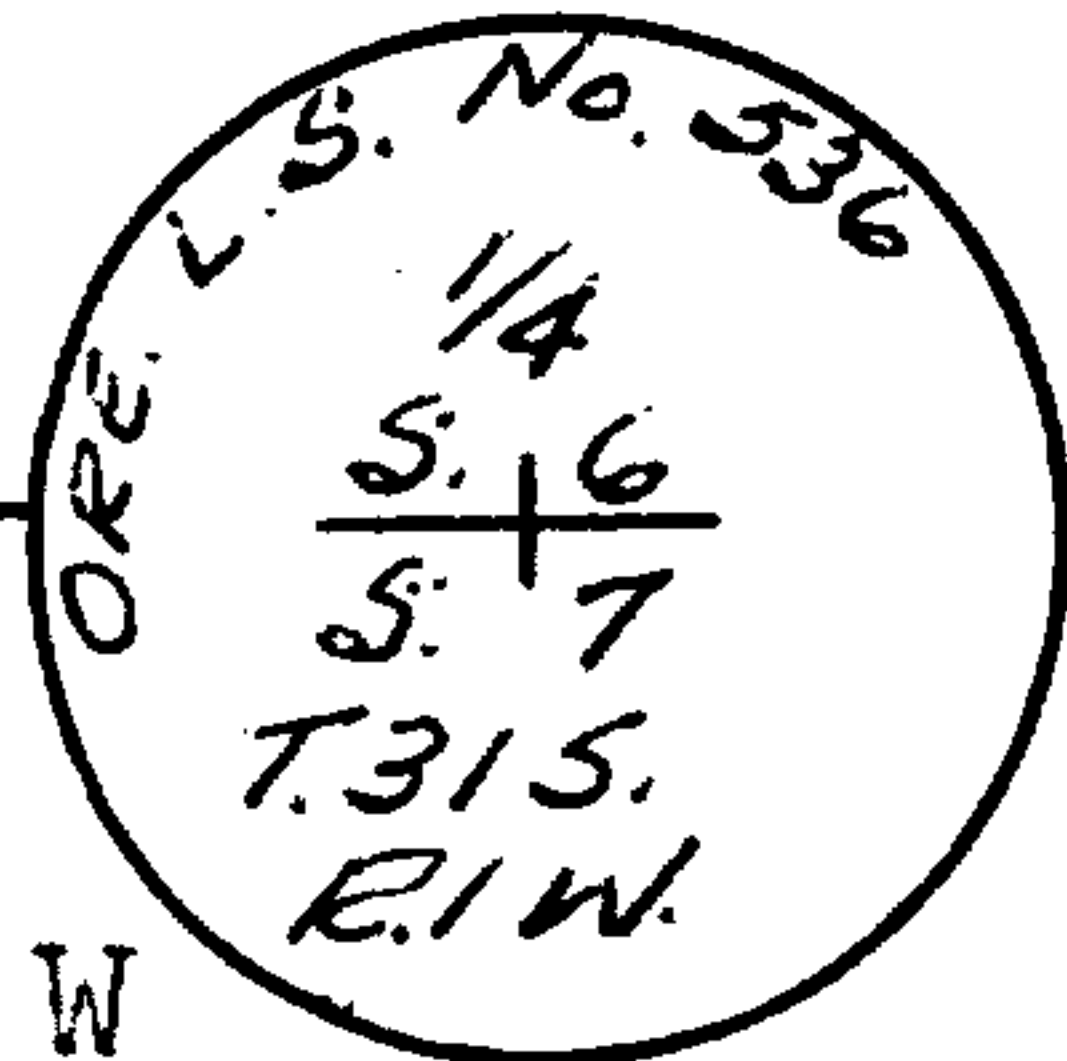


I established two new witness trees; a 14" douglas fir which bears N. 24° W 6.6 ft. dist. blazed and scribed 1/4, S. 6., B.T. Also, a 20" Broad leaf maple which bears S 15° W. 217.5 ft. dist. blazed and scribed 1/4 S. 7., B.T.

Office of..... County of.....
State of....., I hereby certify that the within instrument was filed in this office
for record on the day of; 19....., at..... o'clockm., (signed)
..... by
(COUNTY OFFICIAL) (DEPUTY)

CERTIFIED RECORD OF LAND CORNER MONUMENTATION

History of original corner establishment:

No corner had been previously set.

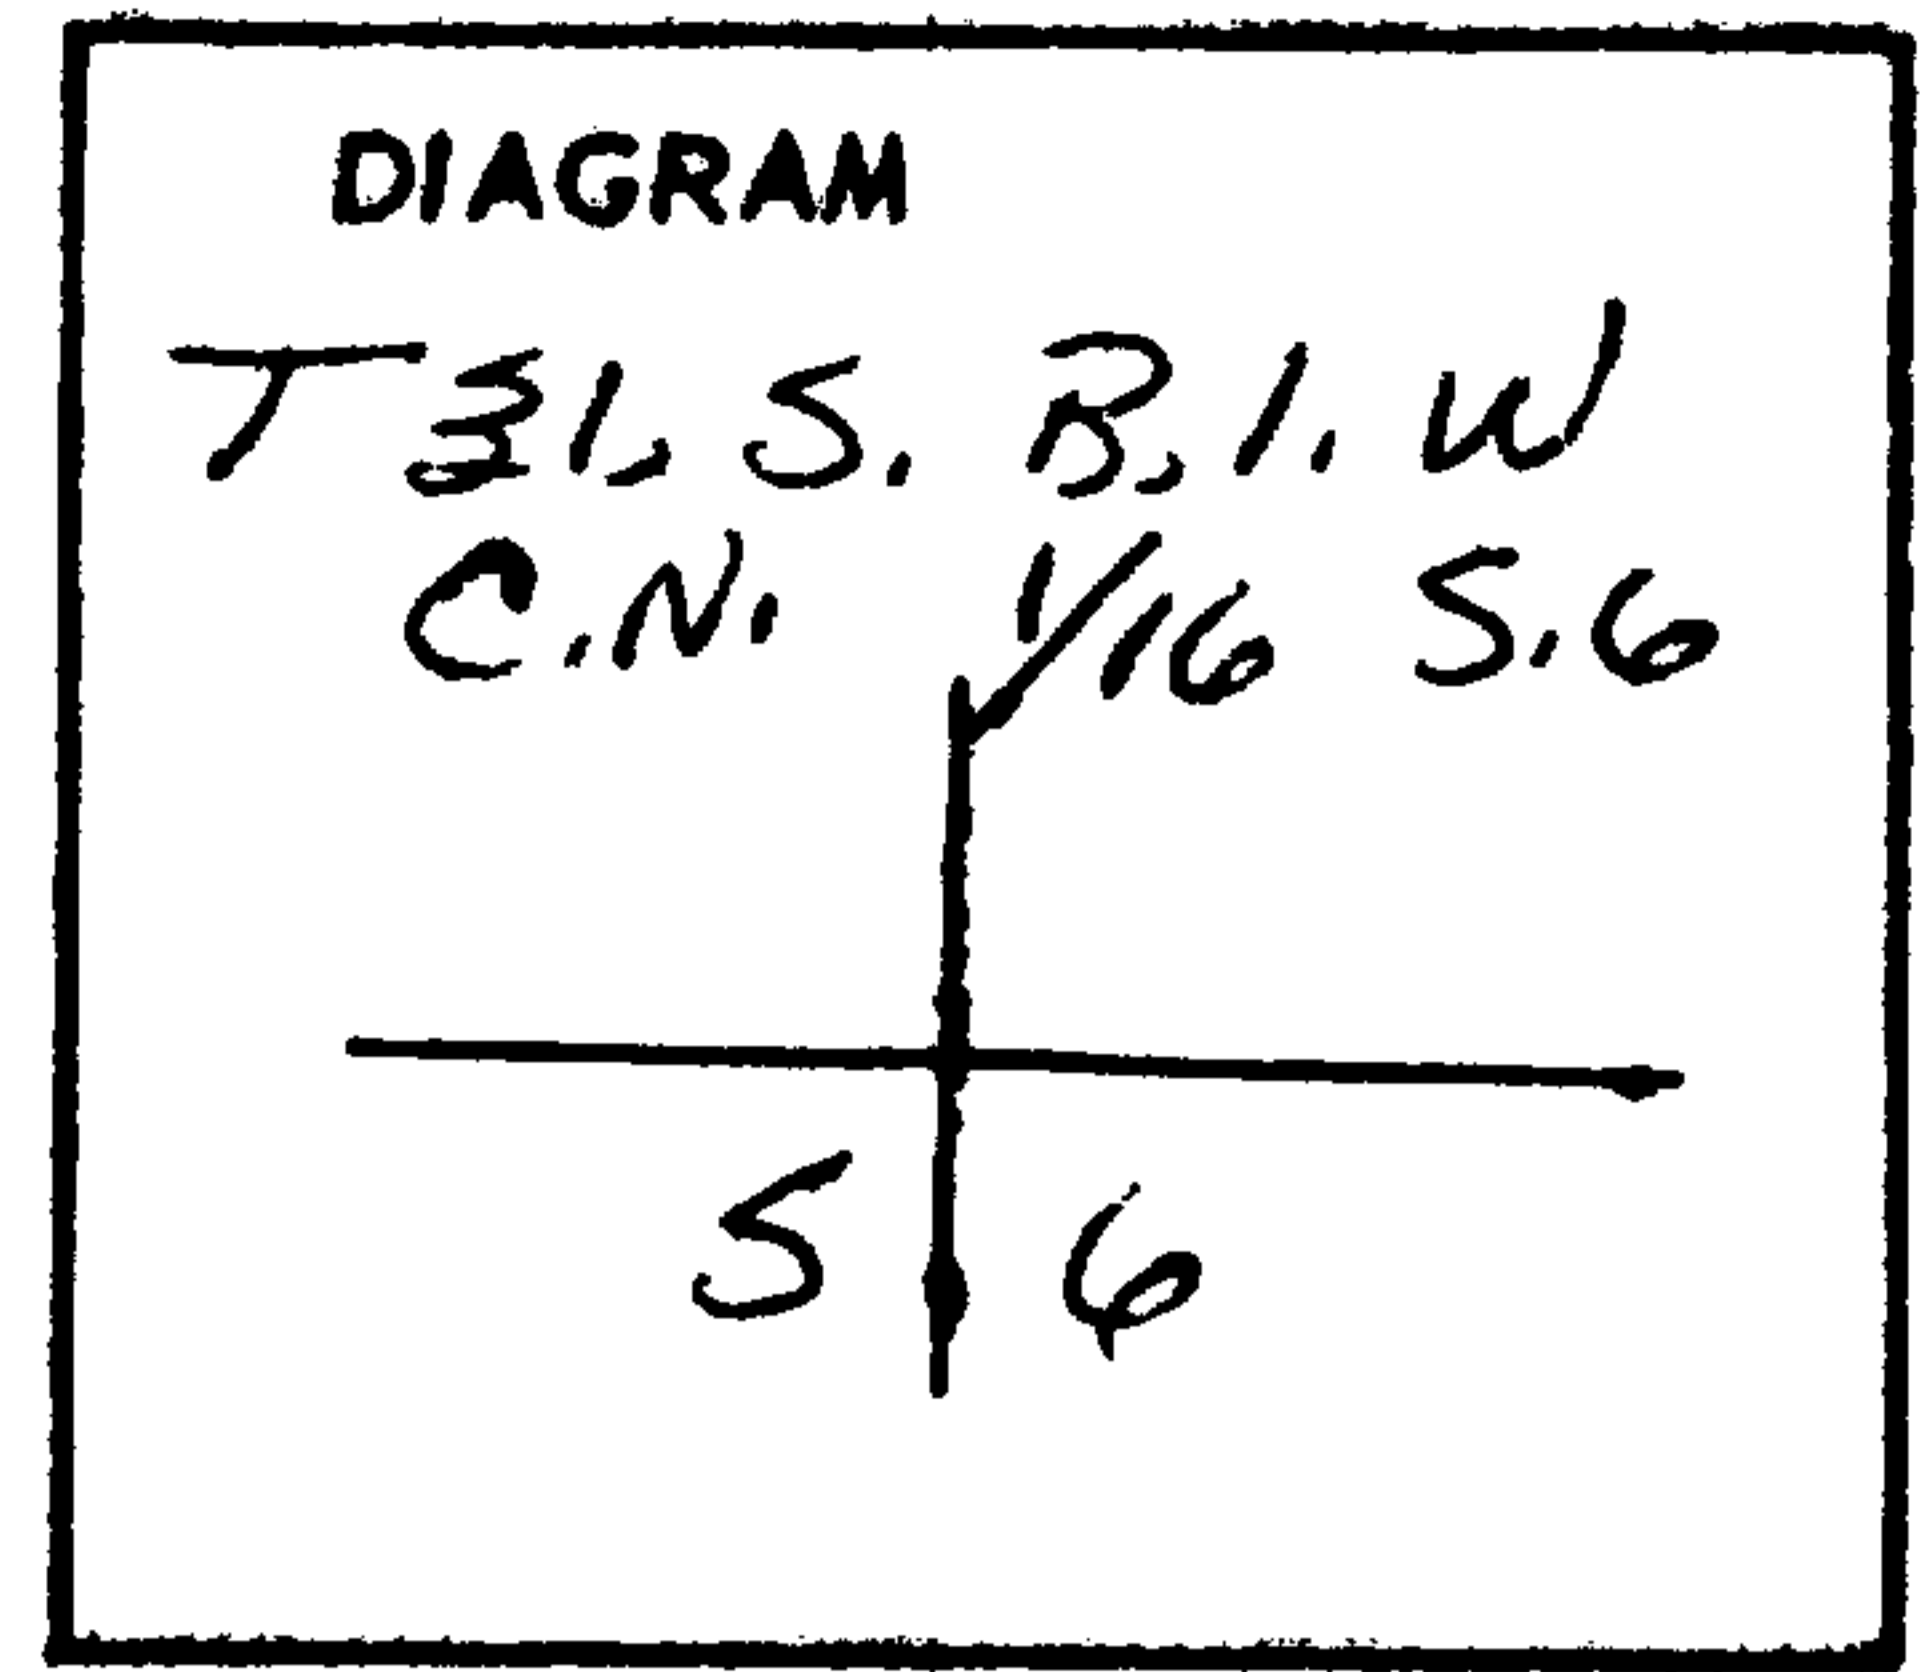


Description of corner evidence found:

None.

Description of monument and accessories I established to perpetuate the original location of this corner

I placed an iron pipe 30" long and 2" in diameter, flared at the bottom and capped with a bronze disk. Monument projects 6 inches above ground. I filled in around the pipe with stone and packed earth.

I stamped the disk:

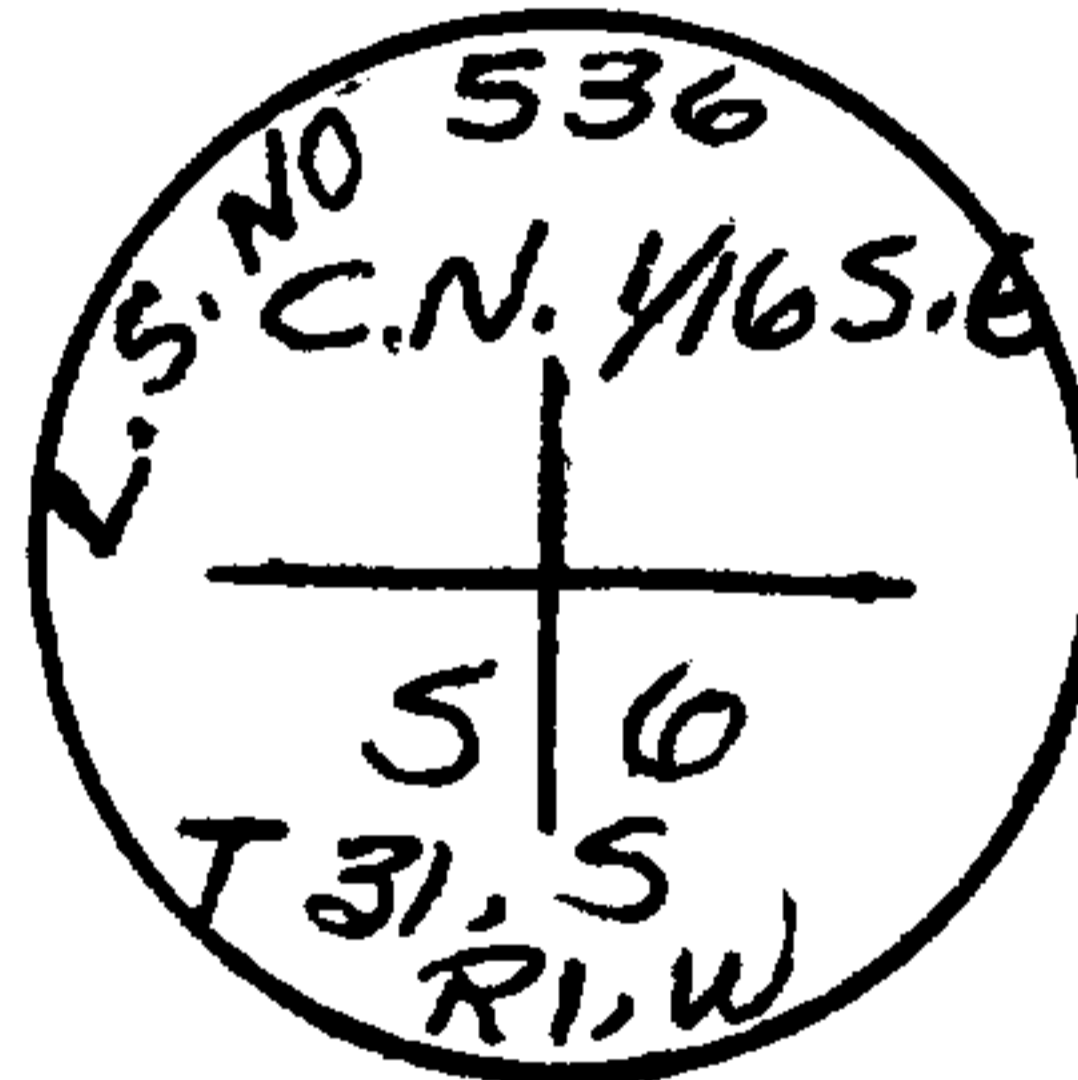


I established two new witness trees a 4" Willow which bears S.15° E. and a distance of 50.7 ft. ; blazed and scribed C.N. 1/16 S.6., B.T., also a 3" Willow which bears S. 34 1/2° W. and a distance of 68.7 ft.; blazed and scribed C.N. 1/16 S.6., B.T.

Office of..... County of.....
 State of....., I hereby certify that the within instrument was filed in this office
 for record on the day of; 19....., at..... o'clockm., (signed)
 by
 (COUNTY OFFICIAL) (DEPUTY)

CERTIFIED RECORD OF LAND CORNER MONUMENTATION

History of original corner establishment:

No corner had previously been set.

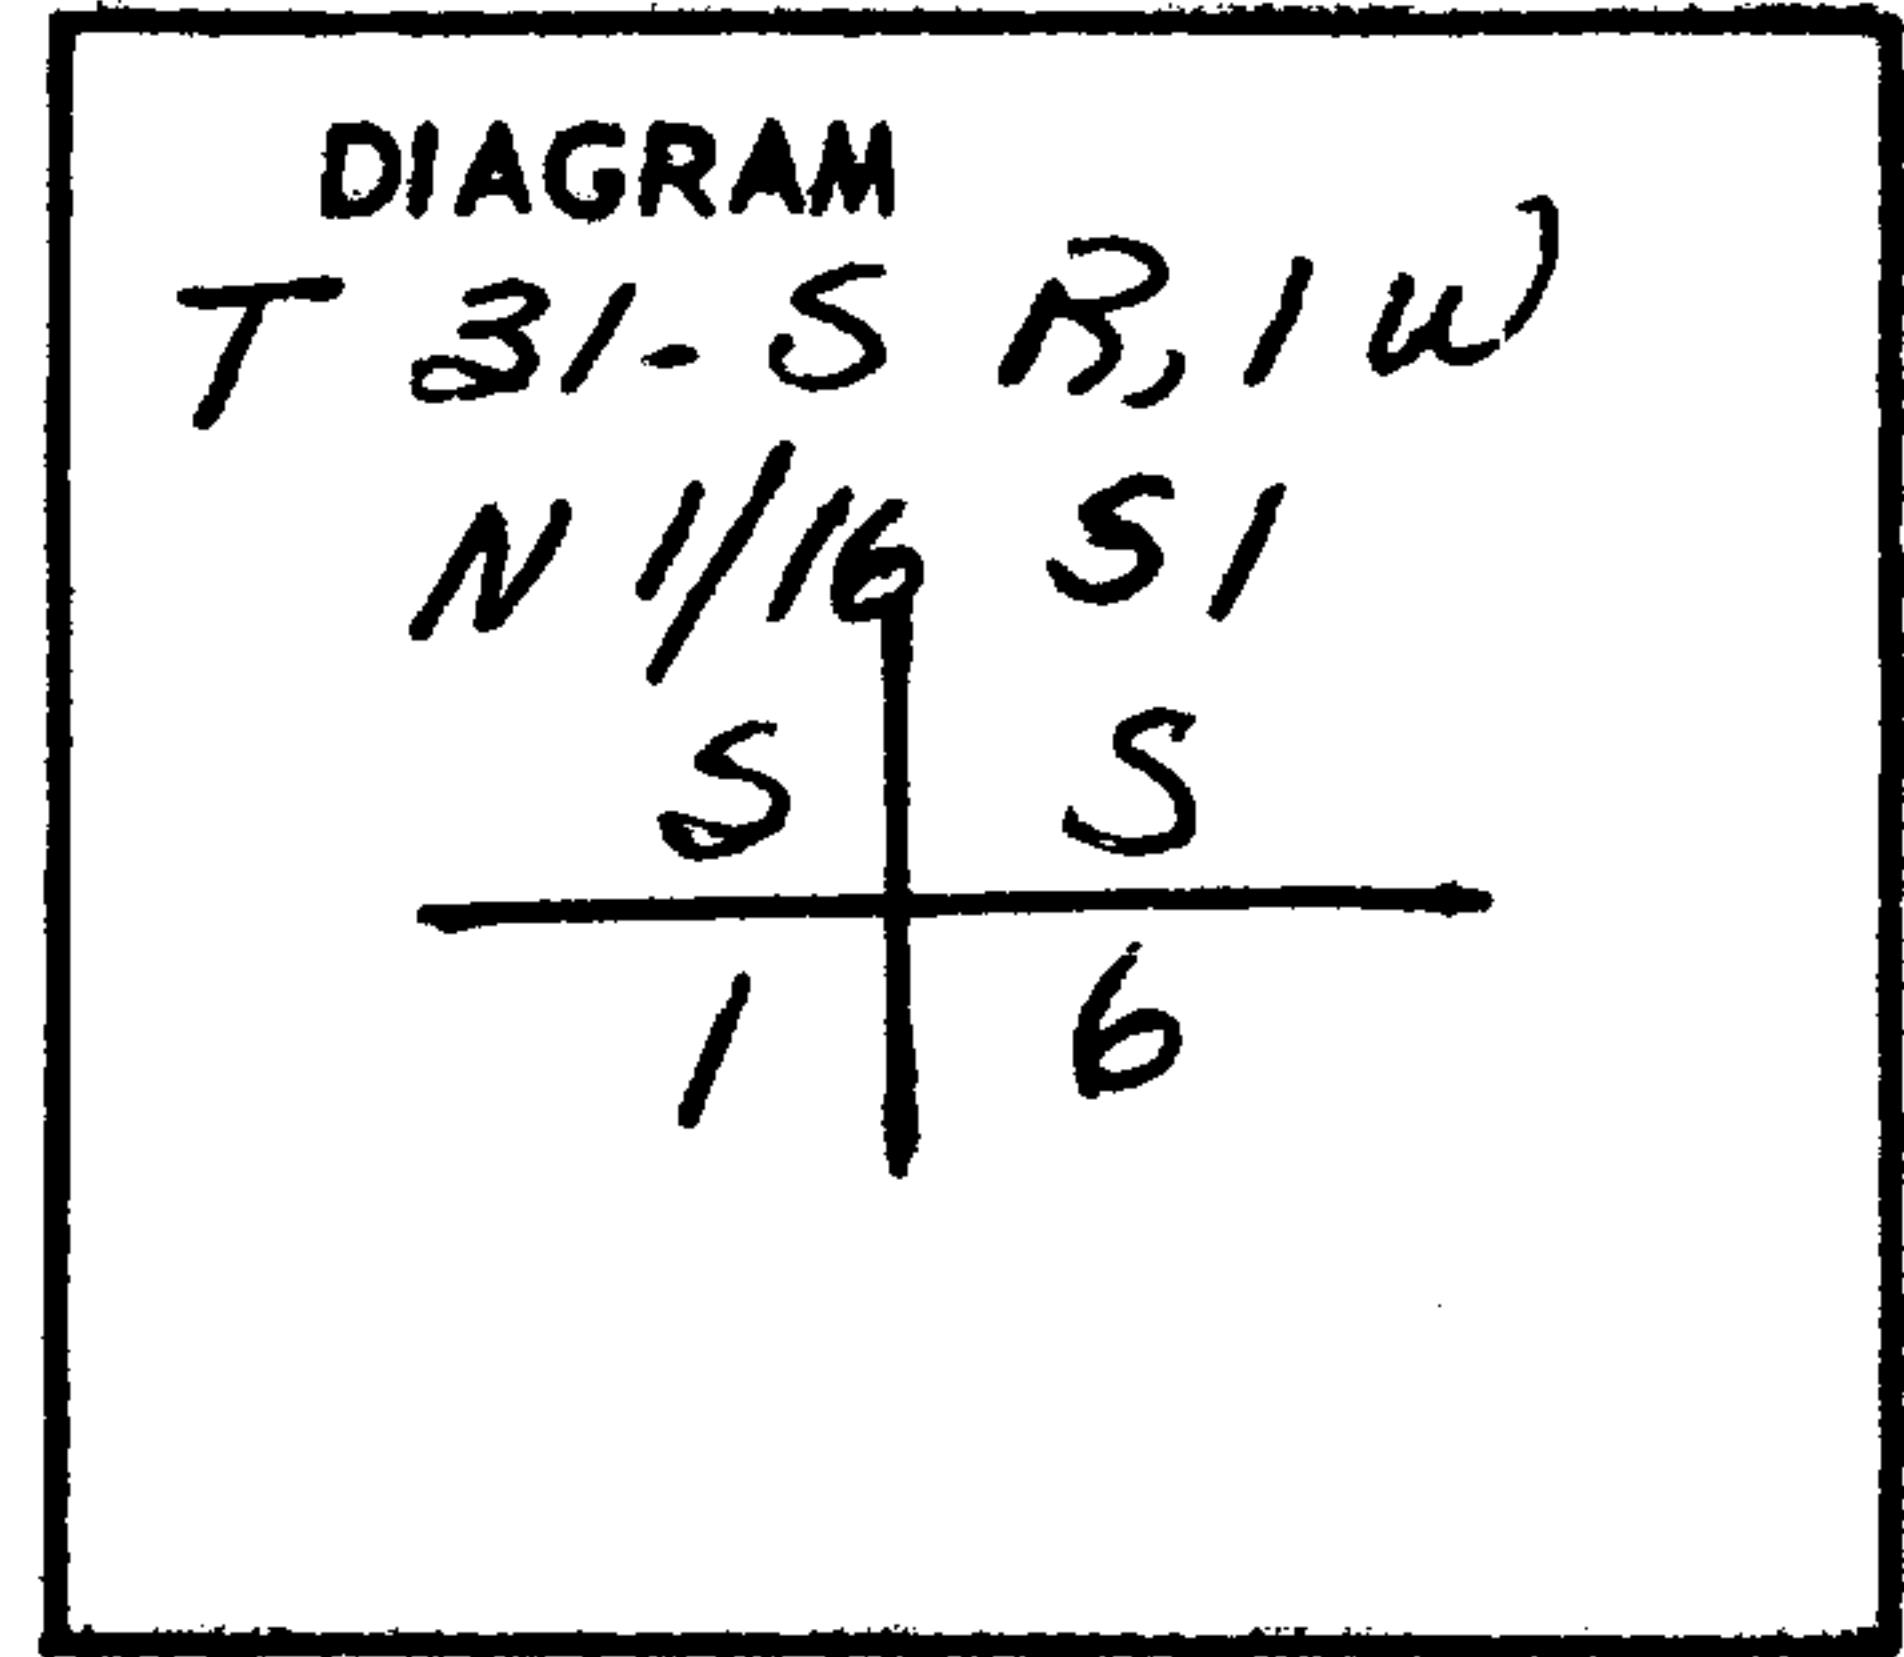


Description of corner evidence found:

None.

Description of monument and accessories I established to perpetuate the original location of this corner

I placed an iron pipe 30" long and 2" in diameter, flared at the bottom and capped with a bronze disk. Monument projects 6 inches above ground. I filled in around the pipe with stone and packed earth.

I stamped the disk:

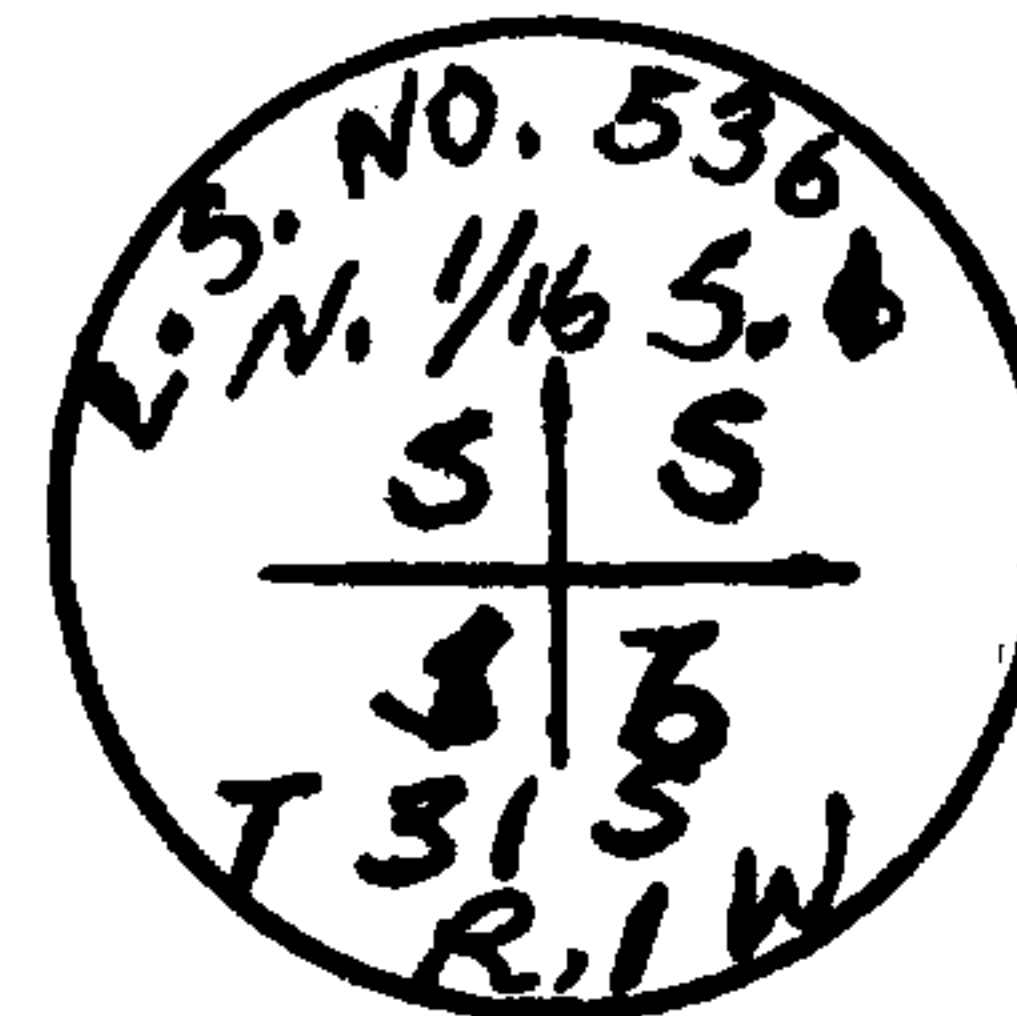


I established two new witness trees a 36" sugar pine which bears N 1 1/2° W 46.5' in dist. blazed and scribed N 1/16 S.1., B.T. also a 16" Douglas fir which bears S 22° E. 12.0' ft. in dist. blazed and scribed N 1/16 S.6 ., B.T.

Office of..... County of.....
 State of....., I hereby certify that the within instrument was filed in this office
 for record on the day of, 19....., at..... o'clockm., (signed)
 by
 (COUNTY OFFICIAL) (DEPUTY)

CERTIFIED RECORD OF LAND CORNER MONUMENTATION

History of original corner establishment:

No previous corner had been set.

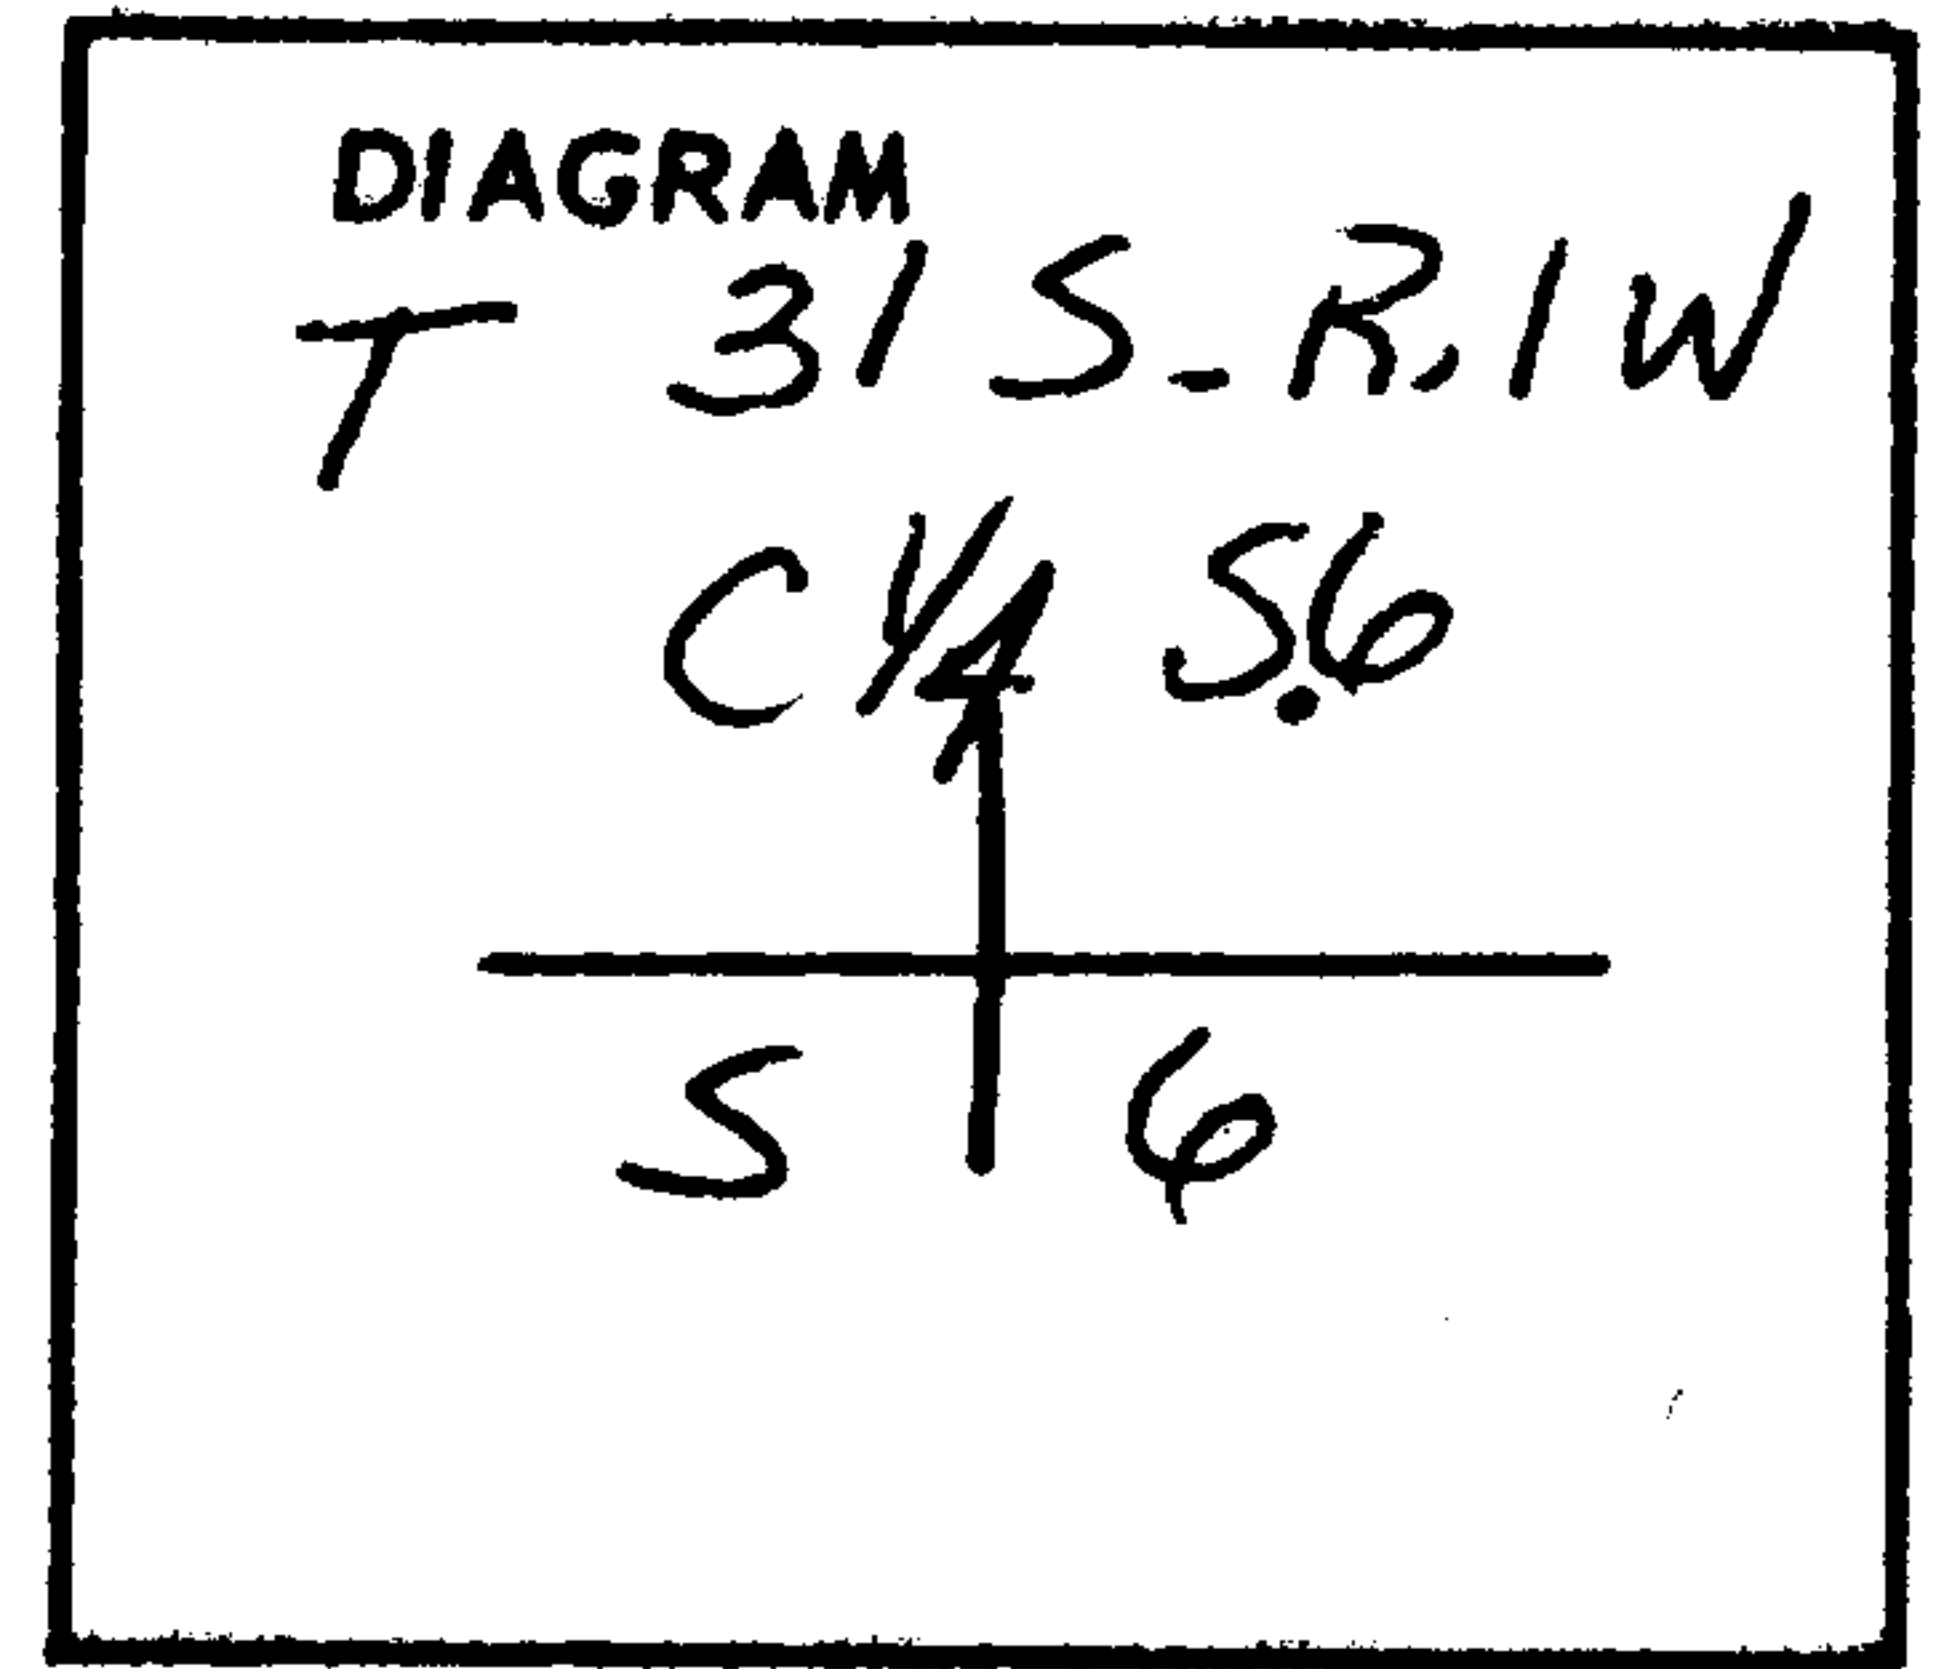


Description of corner evidence found:

None.

Description of monument and accessories I established to perpetuate the original location of this corner

I placed an iron pipe 30" long and 2" in diameter, flared at the bottom and capped with a bronze disk. Monument projects 6 inches above ground. I filled in about the pipe monument with stone and packed earth.

I stamped the disk:

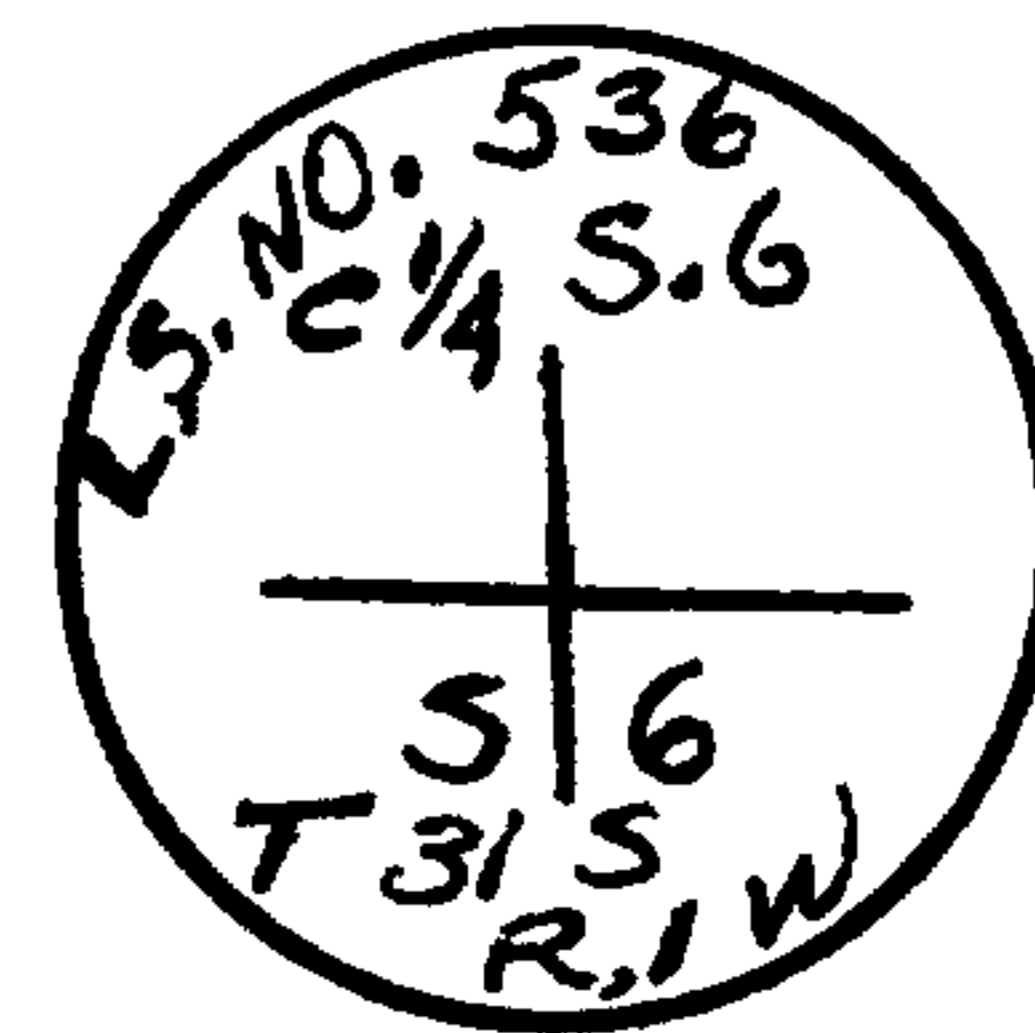

I established two new witness trees; a 8" white fir which bears N. 83 $\frac{1}{2}$ ^o E. and a distance of 22.6'. Blazed and scribed C $\frac{1}{4}$ S. 6., B.T. Also, a 10" white fir which bears S. 83^o W. and a distance of 51.2'ft. Blazed and scribed C $\frac{1}{4}$ S. 6., B.T.

Office of..... County of.....
 State of....., I hereby certify that the within instrument was filed in this office
 for record on the day of; 19....., at..... o'clockm., (signed)
 by
 (COUNTY OFFICIAL) (DEPUTY)