


COUNTY SURVEYORS FILE DATA
DO NOT REMOVE FROM OFFICE

SURVEY IN SECTION 1, T. 26 S., R. 6 W., W.M.
SURVEYED FOR DARWYN T. SUMSTINE
SURVEYED BY R. H. GEE APRIL, 1967
SCALE 1" = 50'



	R 6 W	R 5 W
T 25 S	36	31
T 26 S	1	6

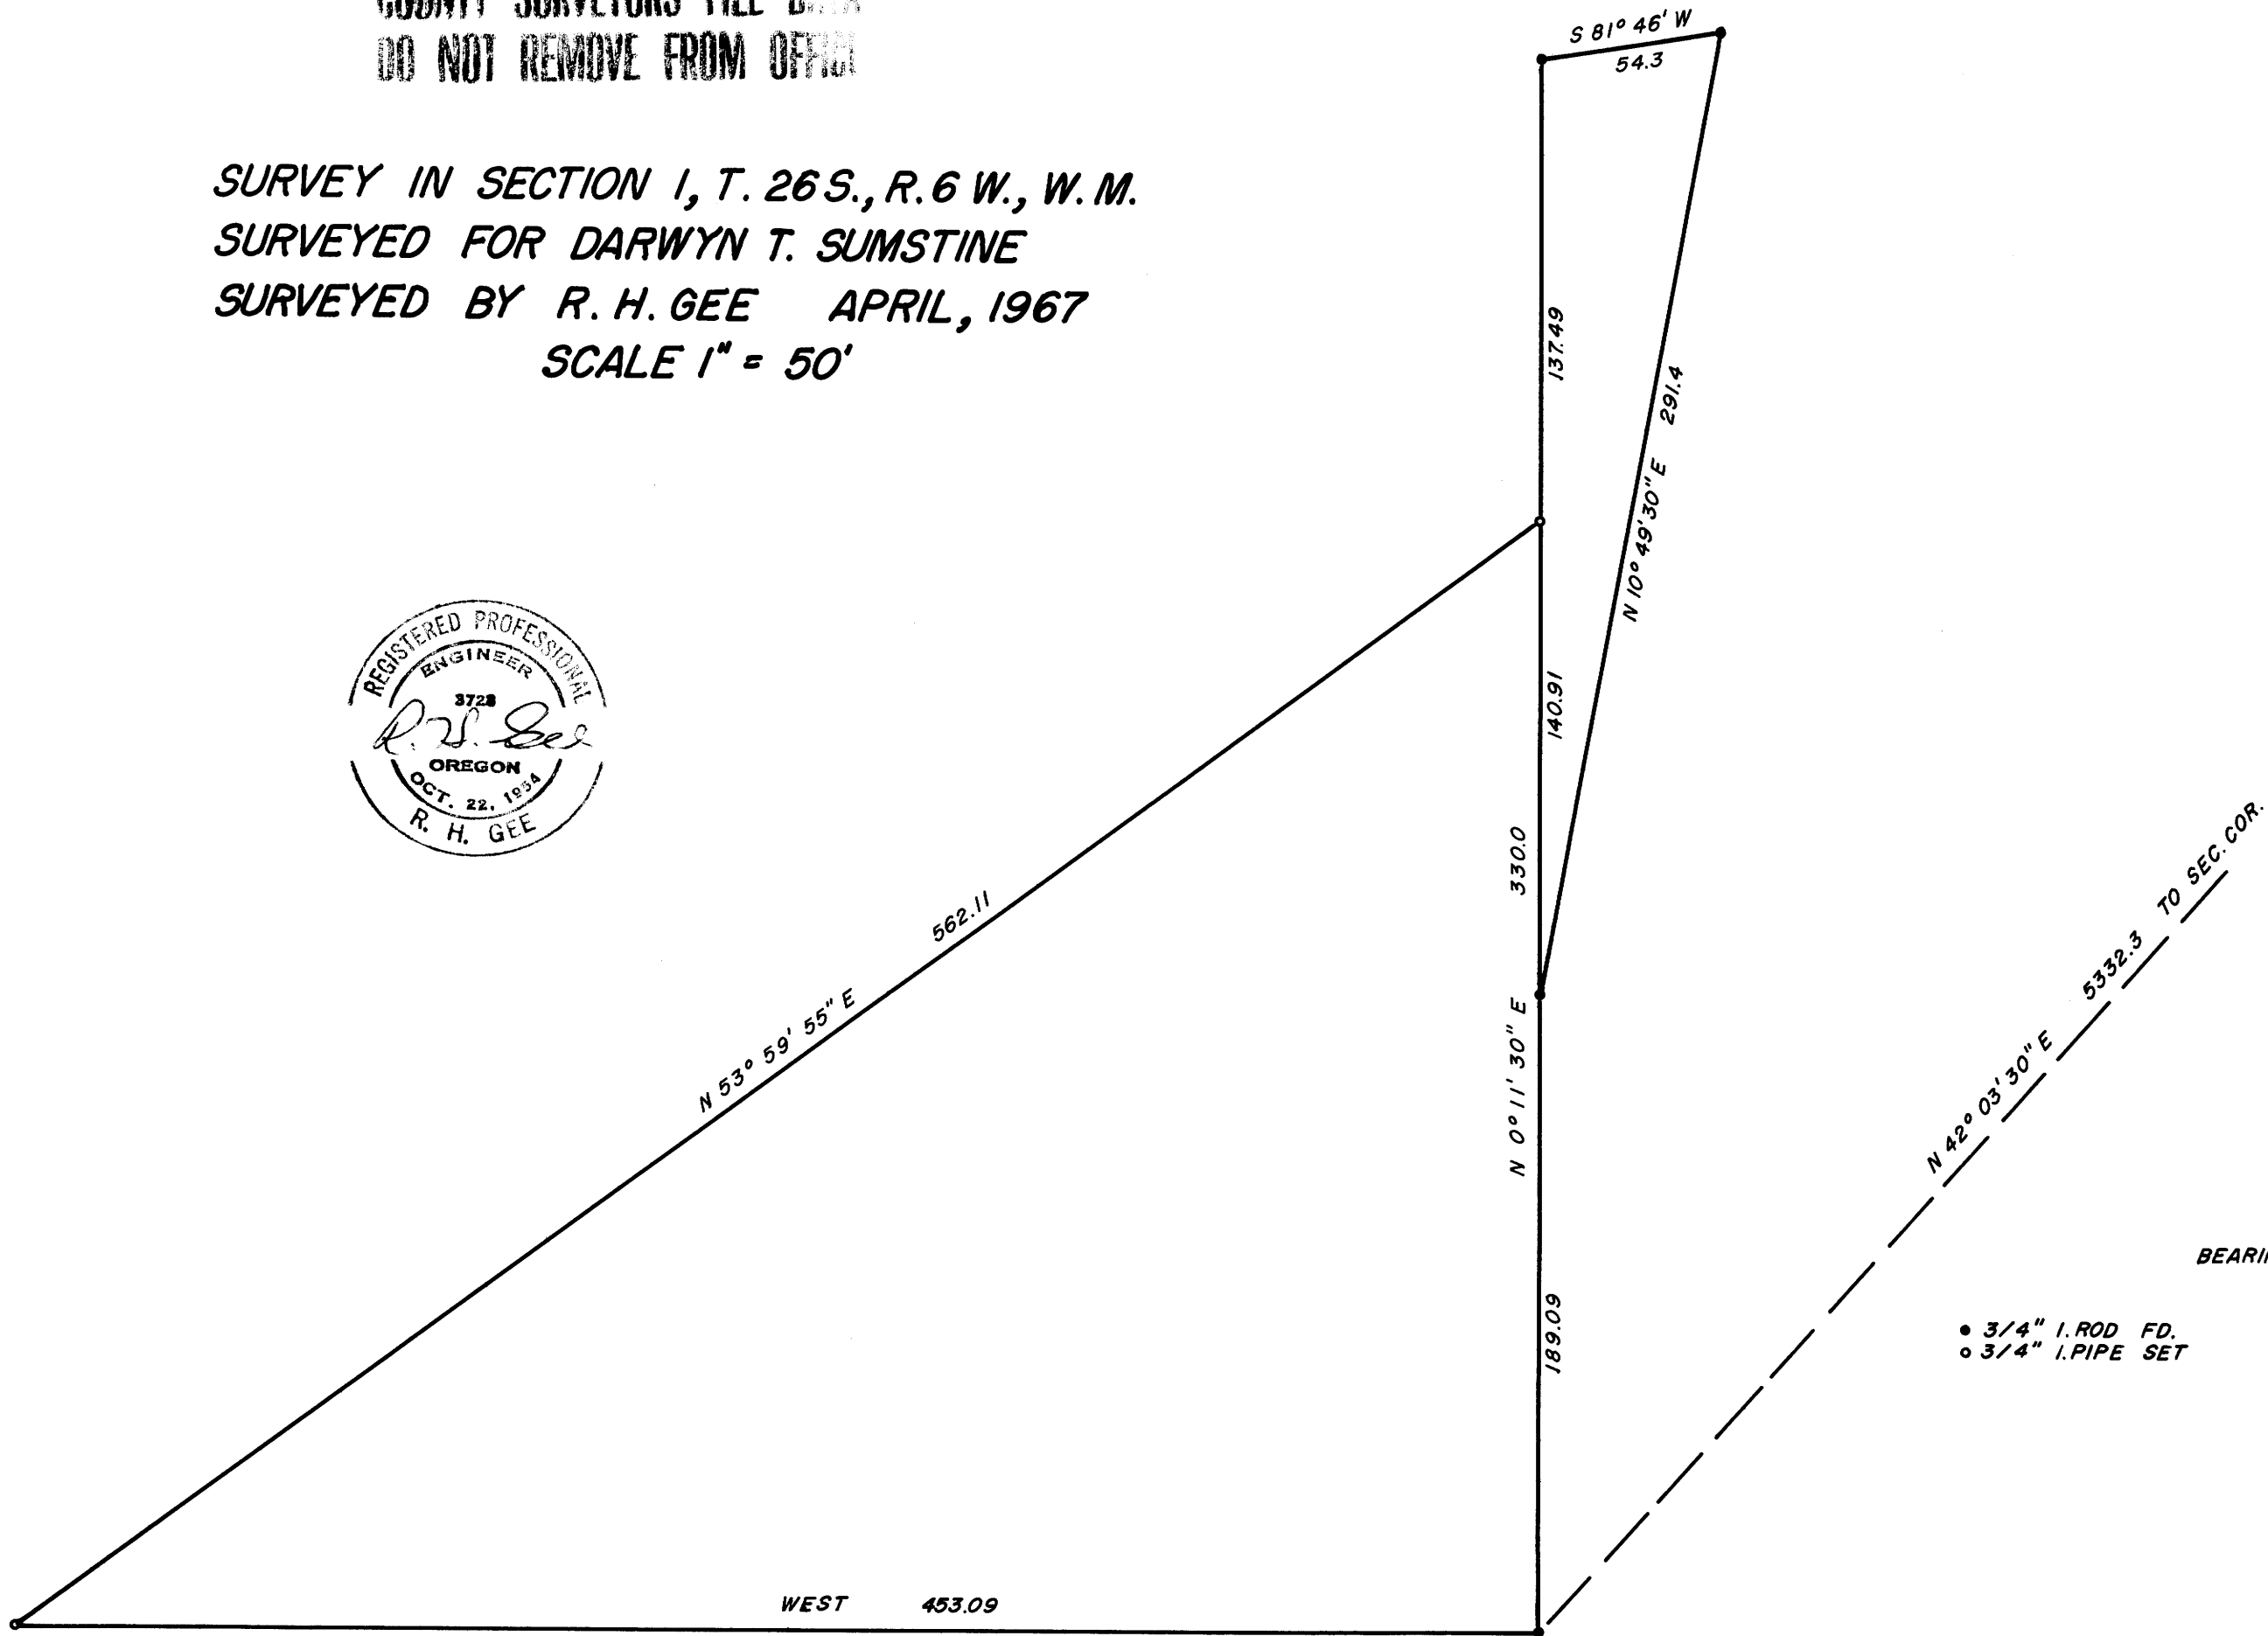

BEARINGS BASED ON C.S. FILE M 6-54

- 3/4" I. ROD FD.
- 3/4" I. PIPE SET

FILED
RECEIVED

MAY 17 1967

COUNTY SURVEYOR
DOUGLAS COUNTY, ORE.