


Mr. P. FILE. 1134. # 63

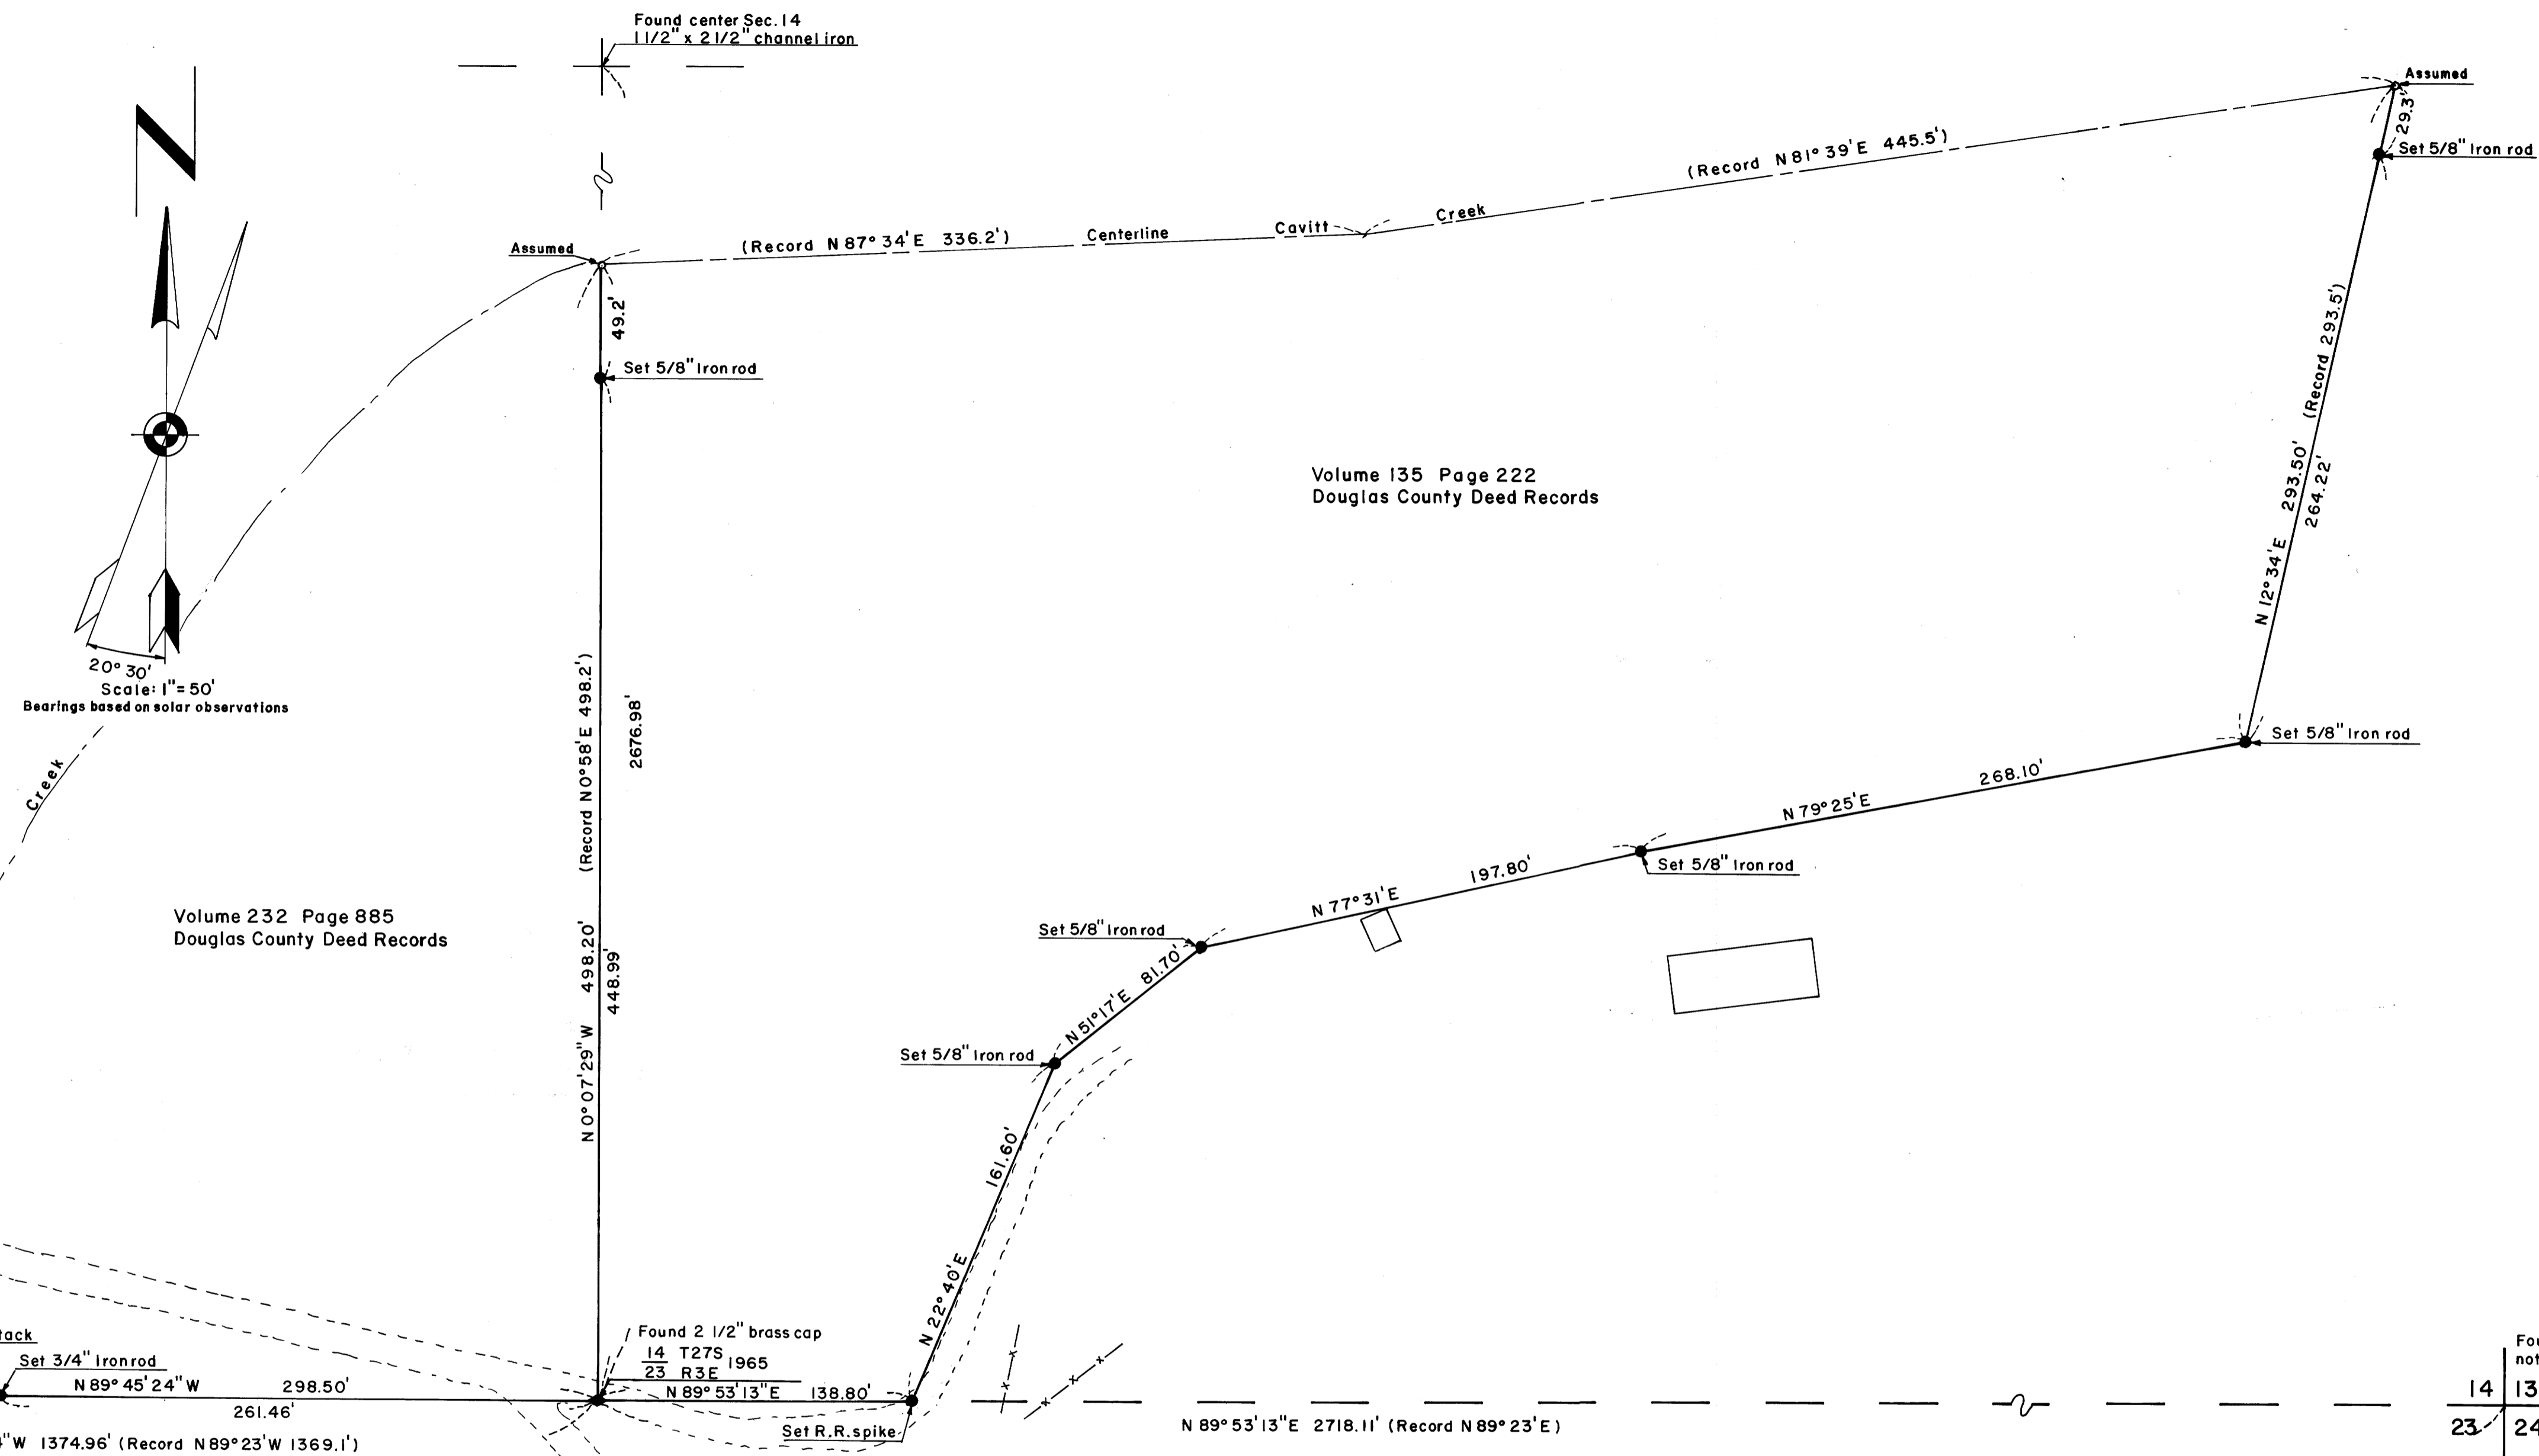

M 34-63

COUNTY SURVEYORS FILE DATA  
DO NOT REMOVE FROM OFFICE

FILED  
RECEIVED  
OCT 5 1967  
COUNTY SURVEYOR  
DOUGLAS COUNTY, ORE.

REGISTERED  
OREGON  
LAND SURVEYOR  
*William C. Stiles*  
OCT. 4, 1957  
WILLIAM C. STILES  
432

PROPERTY LINE SURVEY  
for  
O. J. & J. F. Feldkamp  
Sited in Section 14, T27S, R3W, W.M.  
Douglas County, Oregon  
Surveyed August, 1967 by  
SEEK, INC.  
P.O. Box 375 Roseburg, Oregon 97470  
JM