

COUNTY SURVEYORS FILE DATA  
DO NOT REMOVE FROM OFFICE

RETRACEMENT SURVEY IN SEC. 32, T27S, R7W, W.M.  
Surveyed for Wm. Sharp by Don E. Garrett  
November 4, 1967  
Scale 1" = 100'


Bearings are based on the West Line of Section 32. M18-80

Note: Wm. Sharp testifies that the 1 1/2" I. Pipes shown below were set by James R. Daugherty, who died before the survey was completed. I can't say that these pipes correctly mark the West & South Lines of Lot 4, Section 32.

REGISTERED  
O R E G O N  
L A N D S U R V E Y O R

*Don E. Garrett*

JULY 14, 1961  
DON E. GARRETT  
544

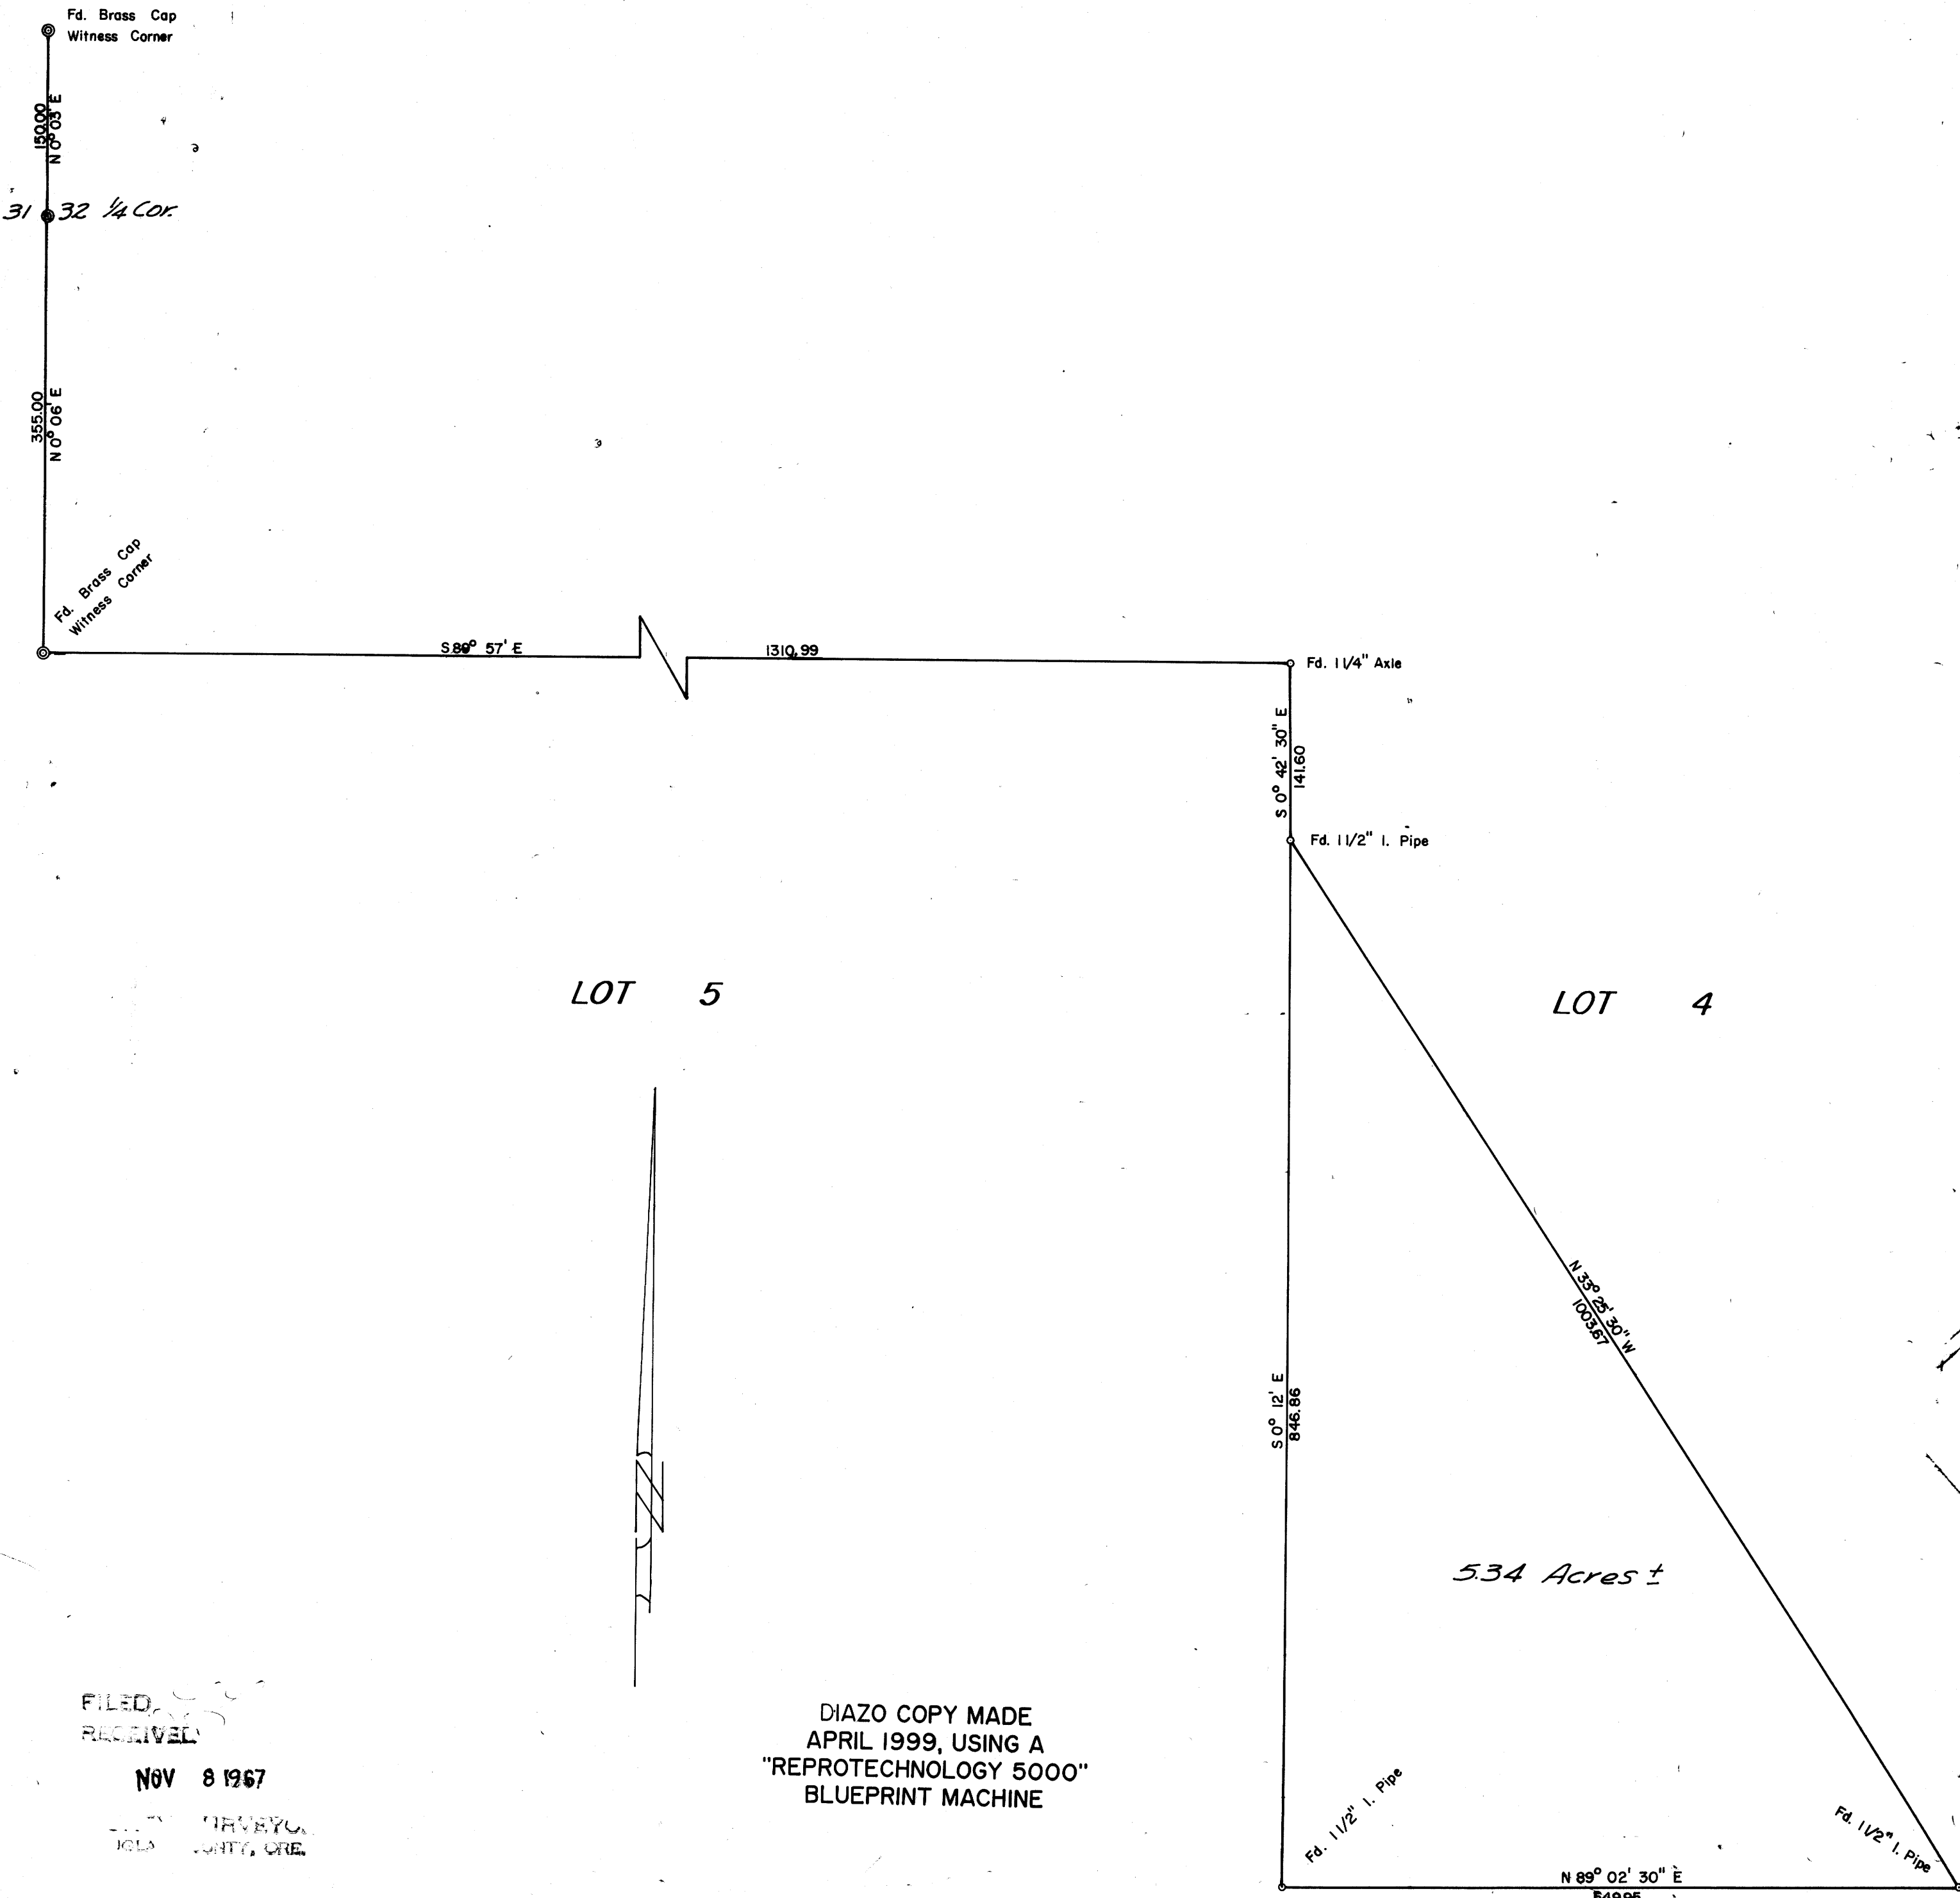

FILED  
RECEIVED  
NOV 8 1967

DIAZO COPY MADE  
APRIL 1999, USING A  
"REPROTECHNOLOGY 5000"  
BLUEPRINT MACHINE