


COUNTY SURVEYORS FILE DATA
DO NOT REMOVE FROM OFFICE

SURVEY FOR DESCRIPTION FOR KARL H. & JOAN B. FRAUN
IN LOT 99, MELROSE ORCHARDS, SEC. 26, T. 26 S., R. 7 W., W.M.,
DOUGLAS CO., OREGON

SCALE 1" = 30'
EAST, JAN, 68 414.38'

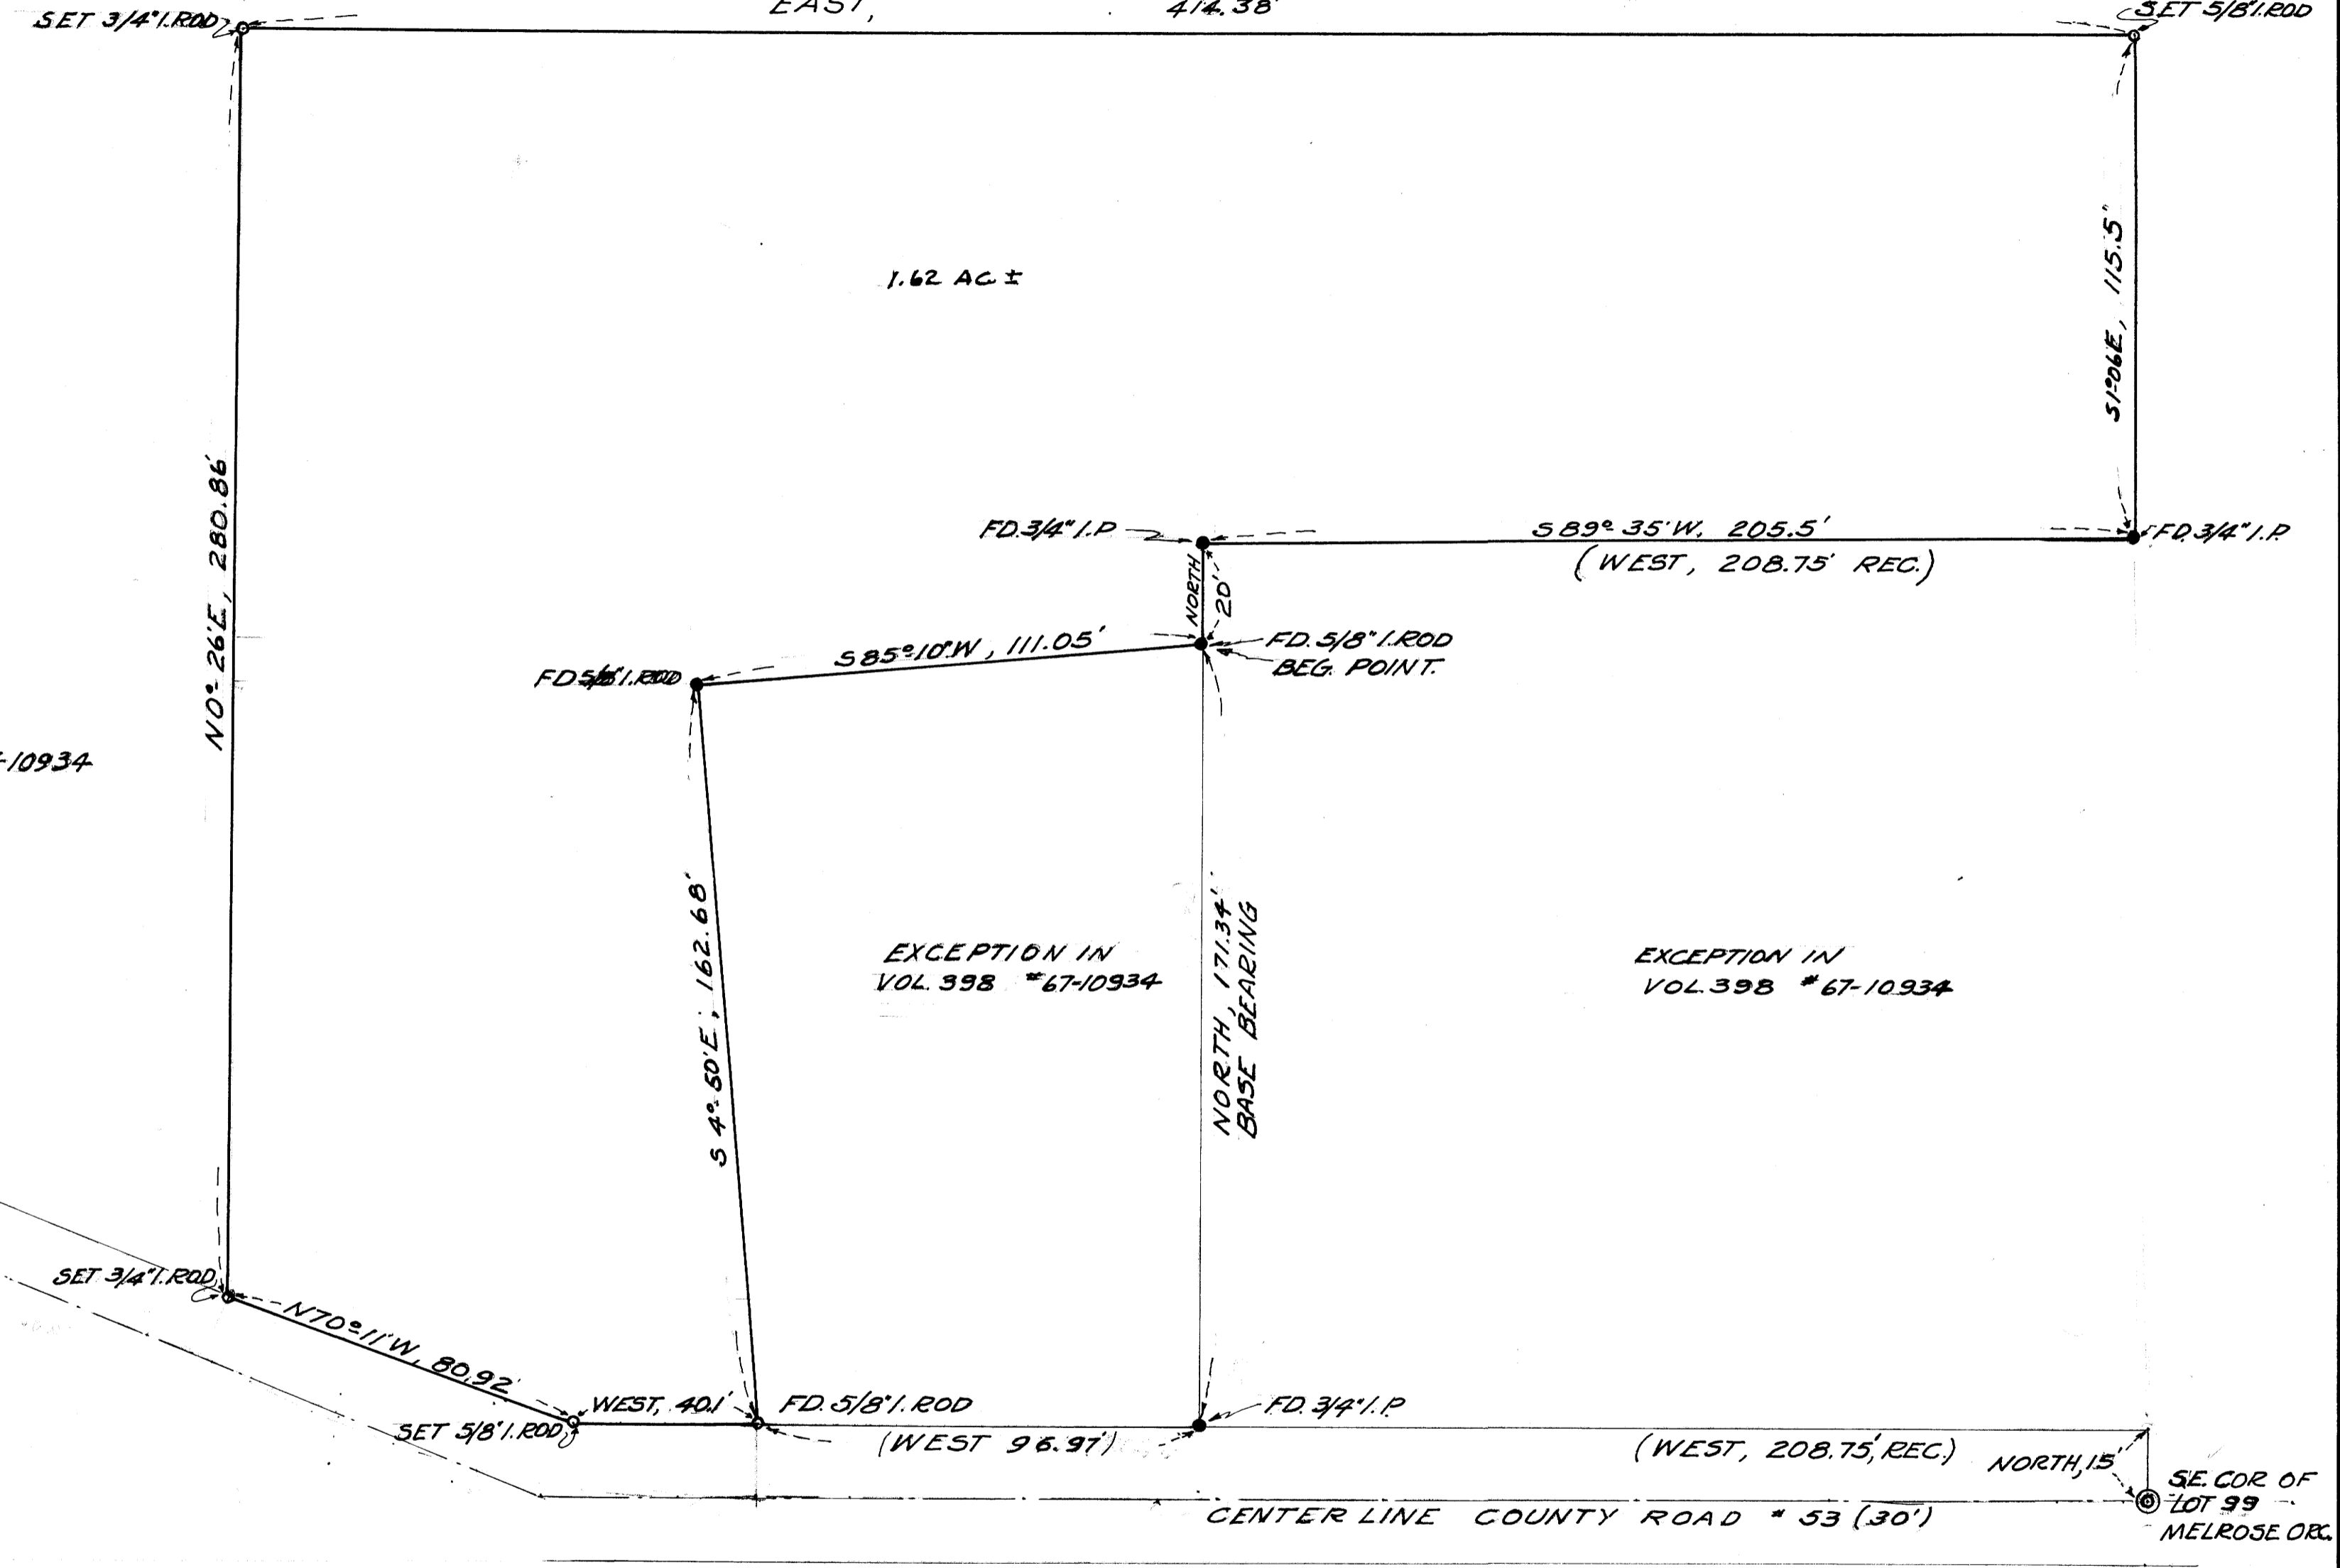

BASE BEARING - NORTH
BY DESCRIPTION IN D.V. #67-10934

- MON. FD
- MON. SET

REGISTERED
OREGON
LAND SURVEYOR

Herbert L. Northcraft

JULY 8, 1966
HERBERT L. NORTHCRAFT
750

FILED RECEIVED
FEB 20 1968
COUNTY SURVEYOR
DOUGLAS COUNTY, ORE.

MAP FILE 11357-43

MAP FILE 11357-43