

**SURVEY FOR DEED DESCRIPTION & LOT CORNERS
LOCATED IN LOT 13, BLOCK 5, GARDEN HOMES SUB.**

FOR WILLIAM JOHNSON

MARCH 1, 1968

BY BAUGHMAN & ACKABET INC.

SCALE 1" = 20'


• SET 78" IRON ROD

COUNTY SURVEYORS FILE NO.
DO NOT REMOVE FROM OFFICE

REGISTERED
OREGON
LAND SURVEYOR

Glenn S. Baughman

JULY 14, 1961
GLENN S. BAUGHMAN
536

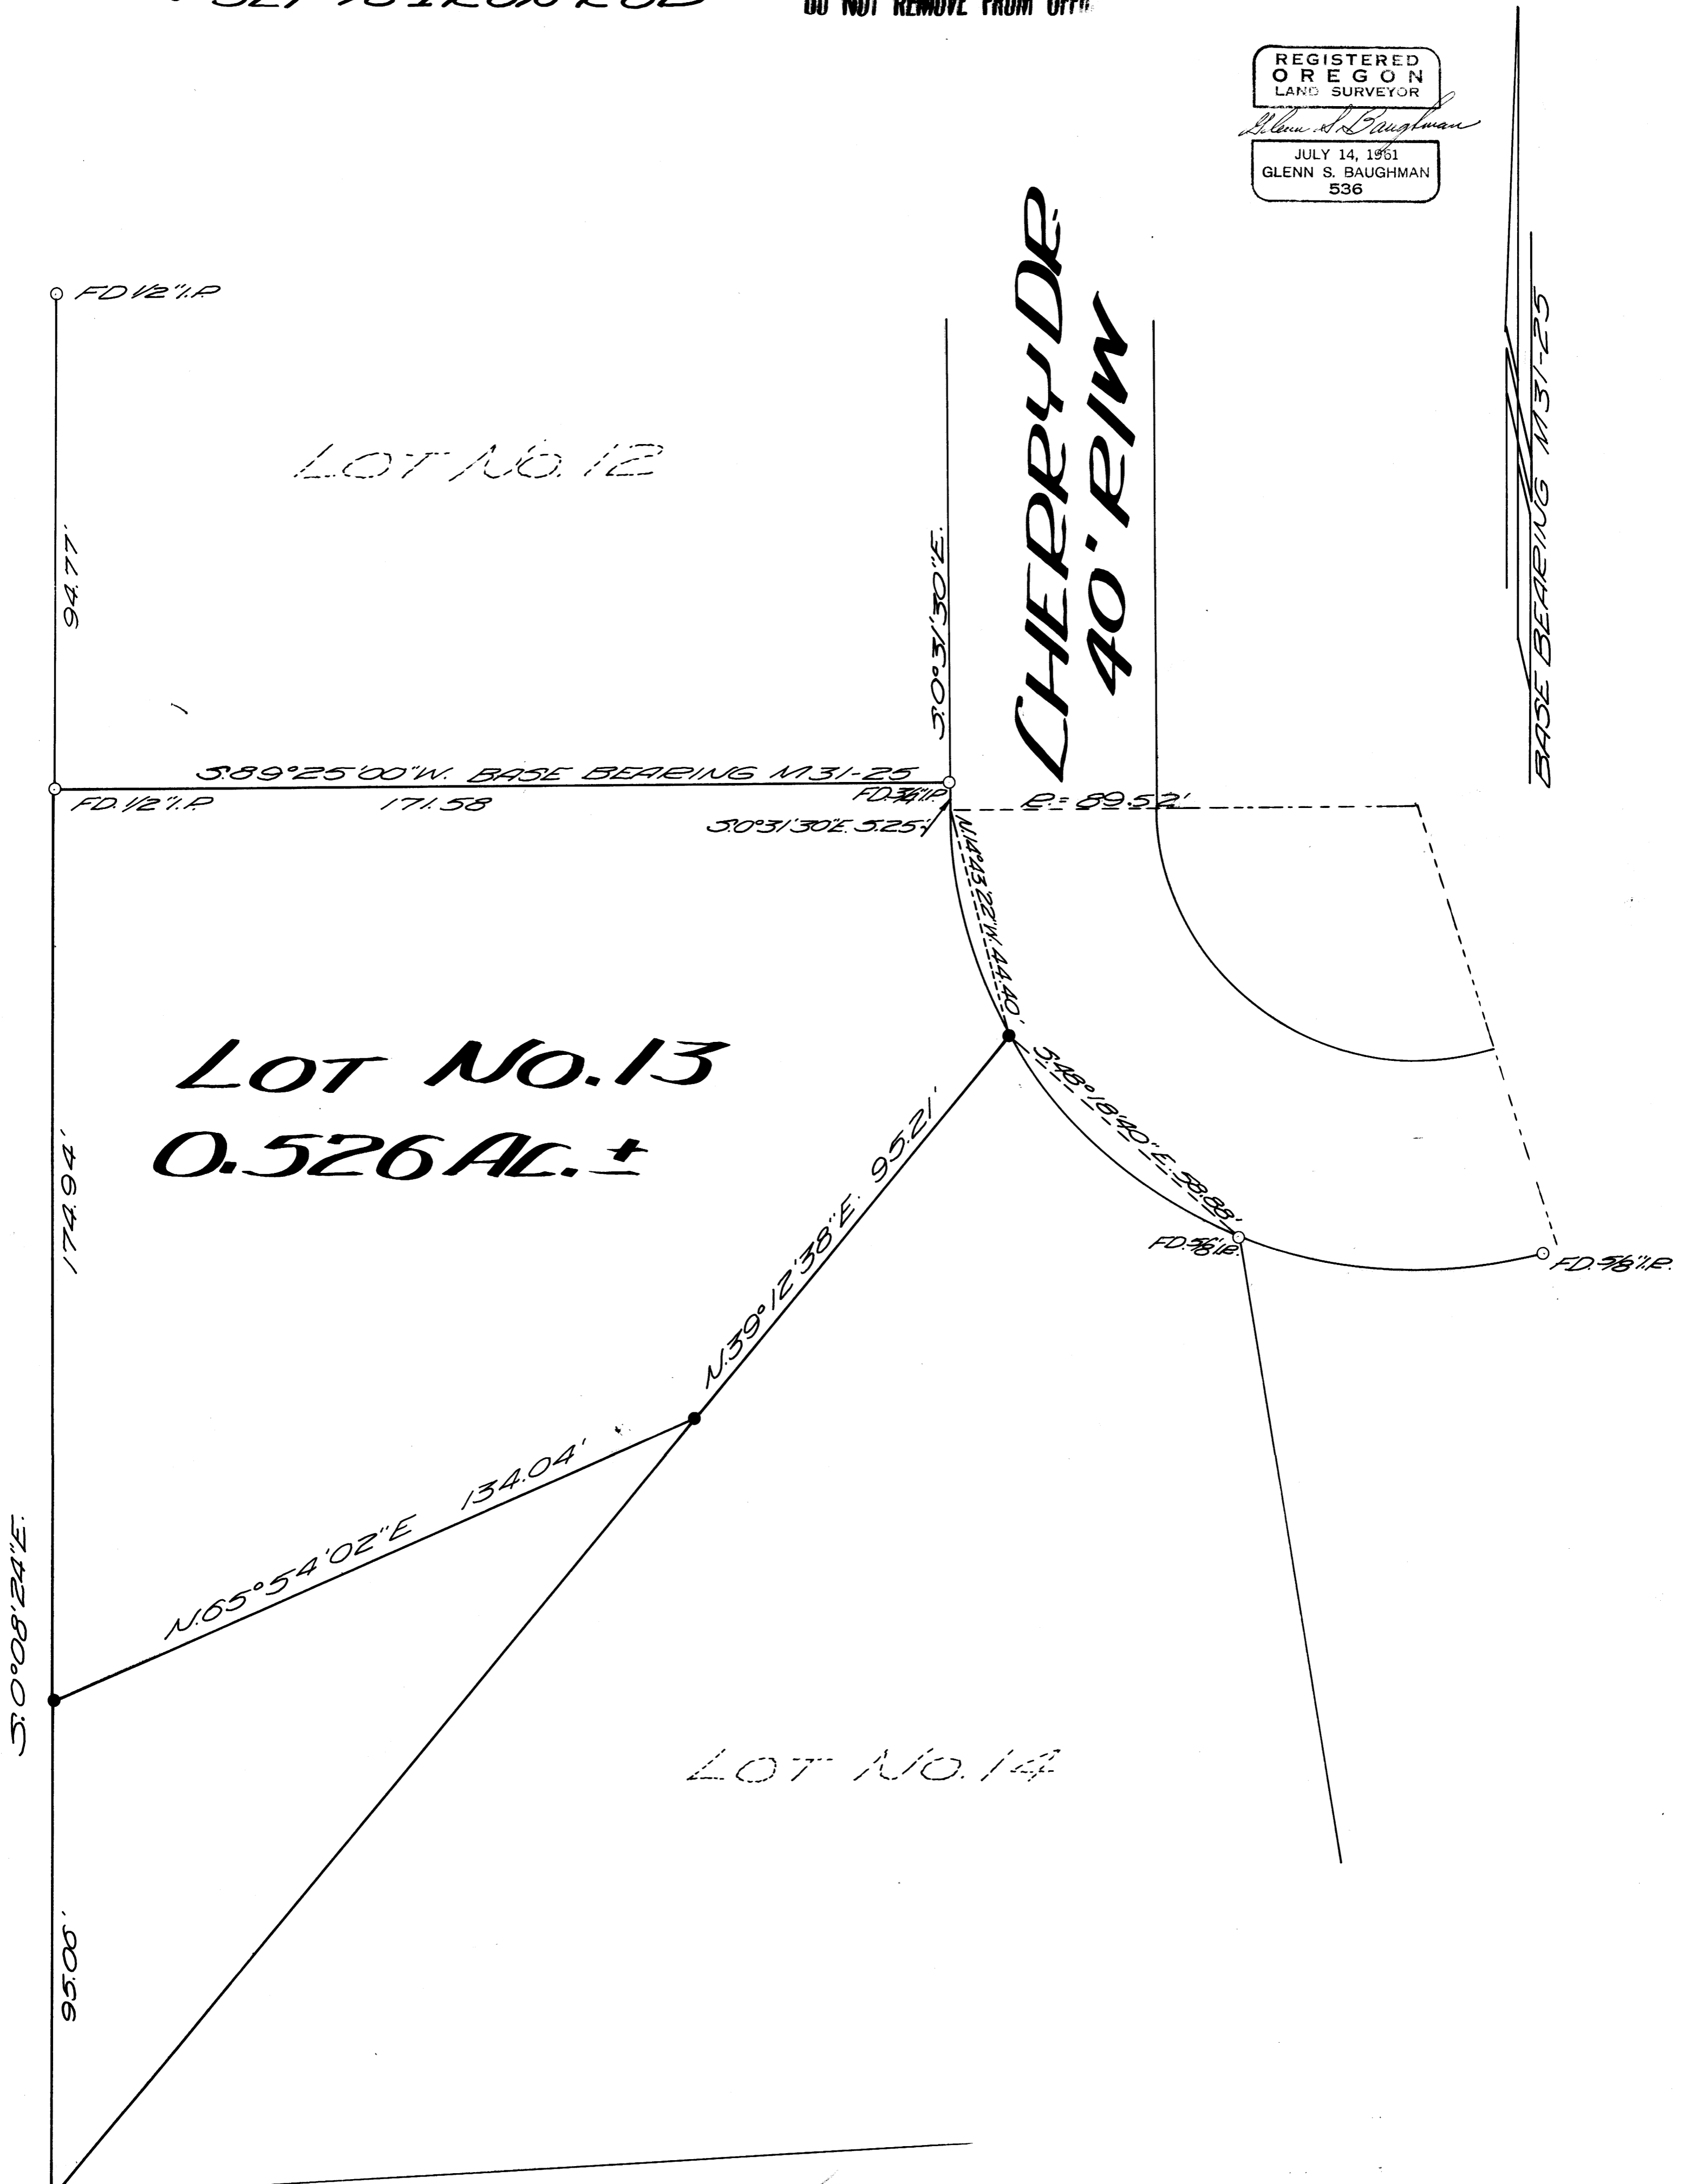

MAR 14 1968
COUNTY SURVEYOR
DOUGLAS COUNTY, OREGON