

COUNTY SURVEYORS FILE  
DO NOT REMOVE FROM OFFICE

SURVEY OF A PORTION OF THE  
N 1/2 OF THE SE 1/4 OF SECTION 4,  
T. 22 S., R. 12 W., W.M.,  
DOUGLAS COUNTY, OREGON

for: FRANK ROSE


Scale: 1" = 100'

Corners found: ○

March 26, 1968

Corners set: ○ 3/4" pipe

Basis for bearing: Monuments on Bowman Road

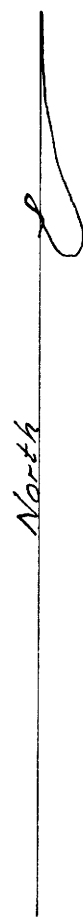

REGISTERED  
OREGON  
LAND SURVEYOR

*Warren D. Hootman*

MAY 10, 1957  
WARREN D. HOOTMAN  
399

Found: Original corner  
of Doyle Tract

*[Signature]*

MAY 2 1968

COUNTY SURVEYOR  
DOUGLAS COUNTY, OREGON