

COUNTY SURVEYORS FILE DATA
DO NOT REMOVE FROM OFFICE

**SURVEY FOR DEED DESCRIPTION
LOT 36 EDEN ORCHARDS**

Surveyed for Edna Marie Sjogren

Surveyed by Don E. Garrett

April 1968

Scale 1" = 100'


Bearings are based on a solar observation taken March 30, 1968.
• - Set 5/8" Iron Rod

APR 10 1968

REGISTERED
OREGON
LAND SURVEYOR

Don E. Garrett

JULY 14, 1961
DON E. GARRETT
544

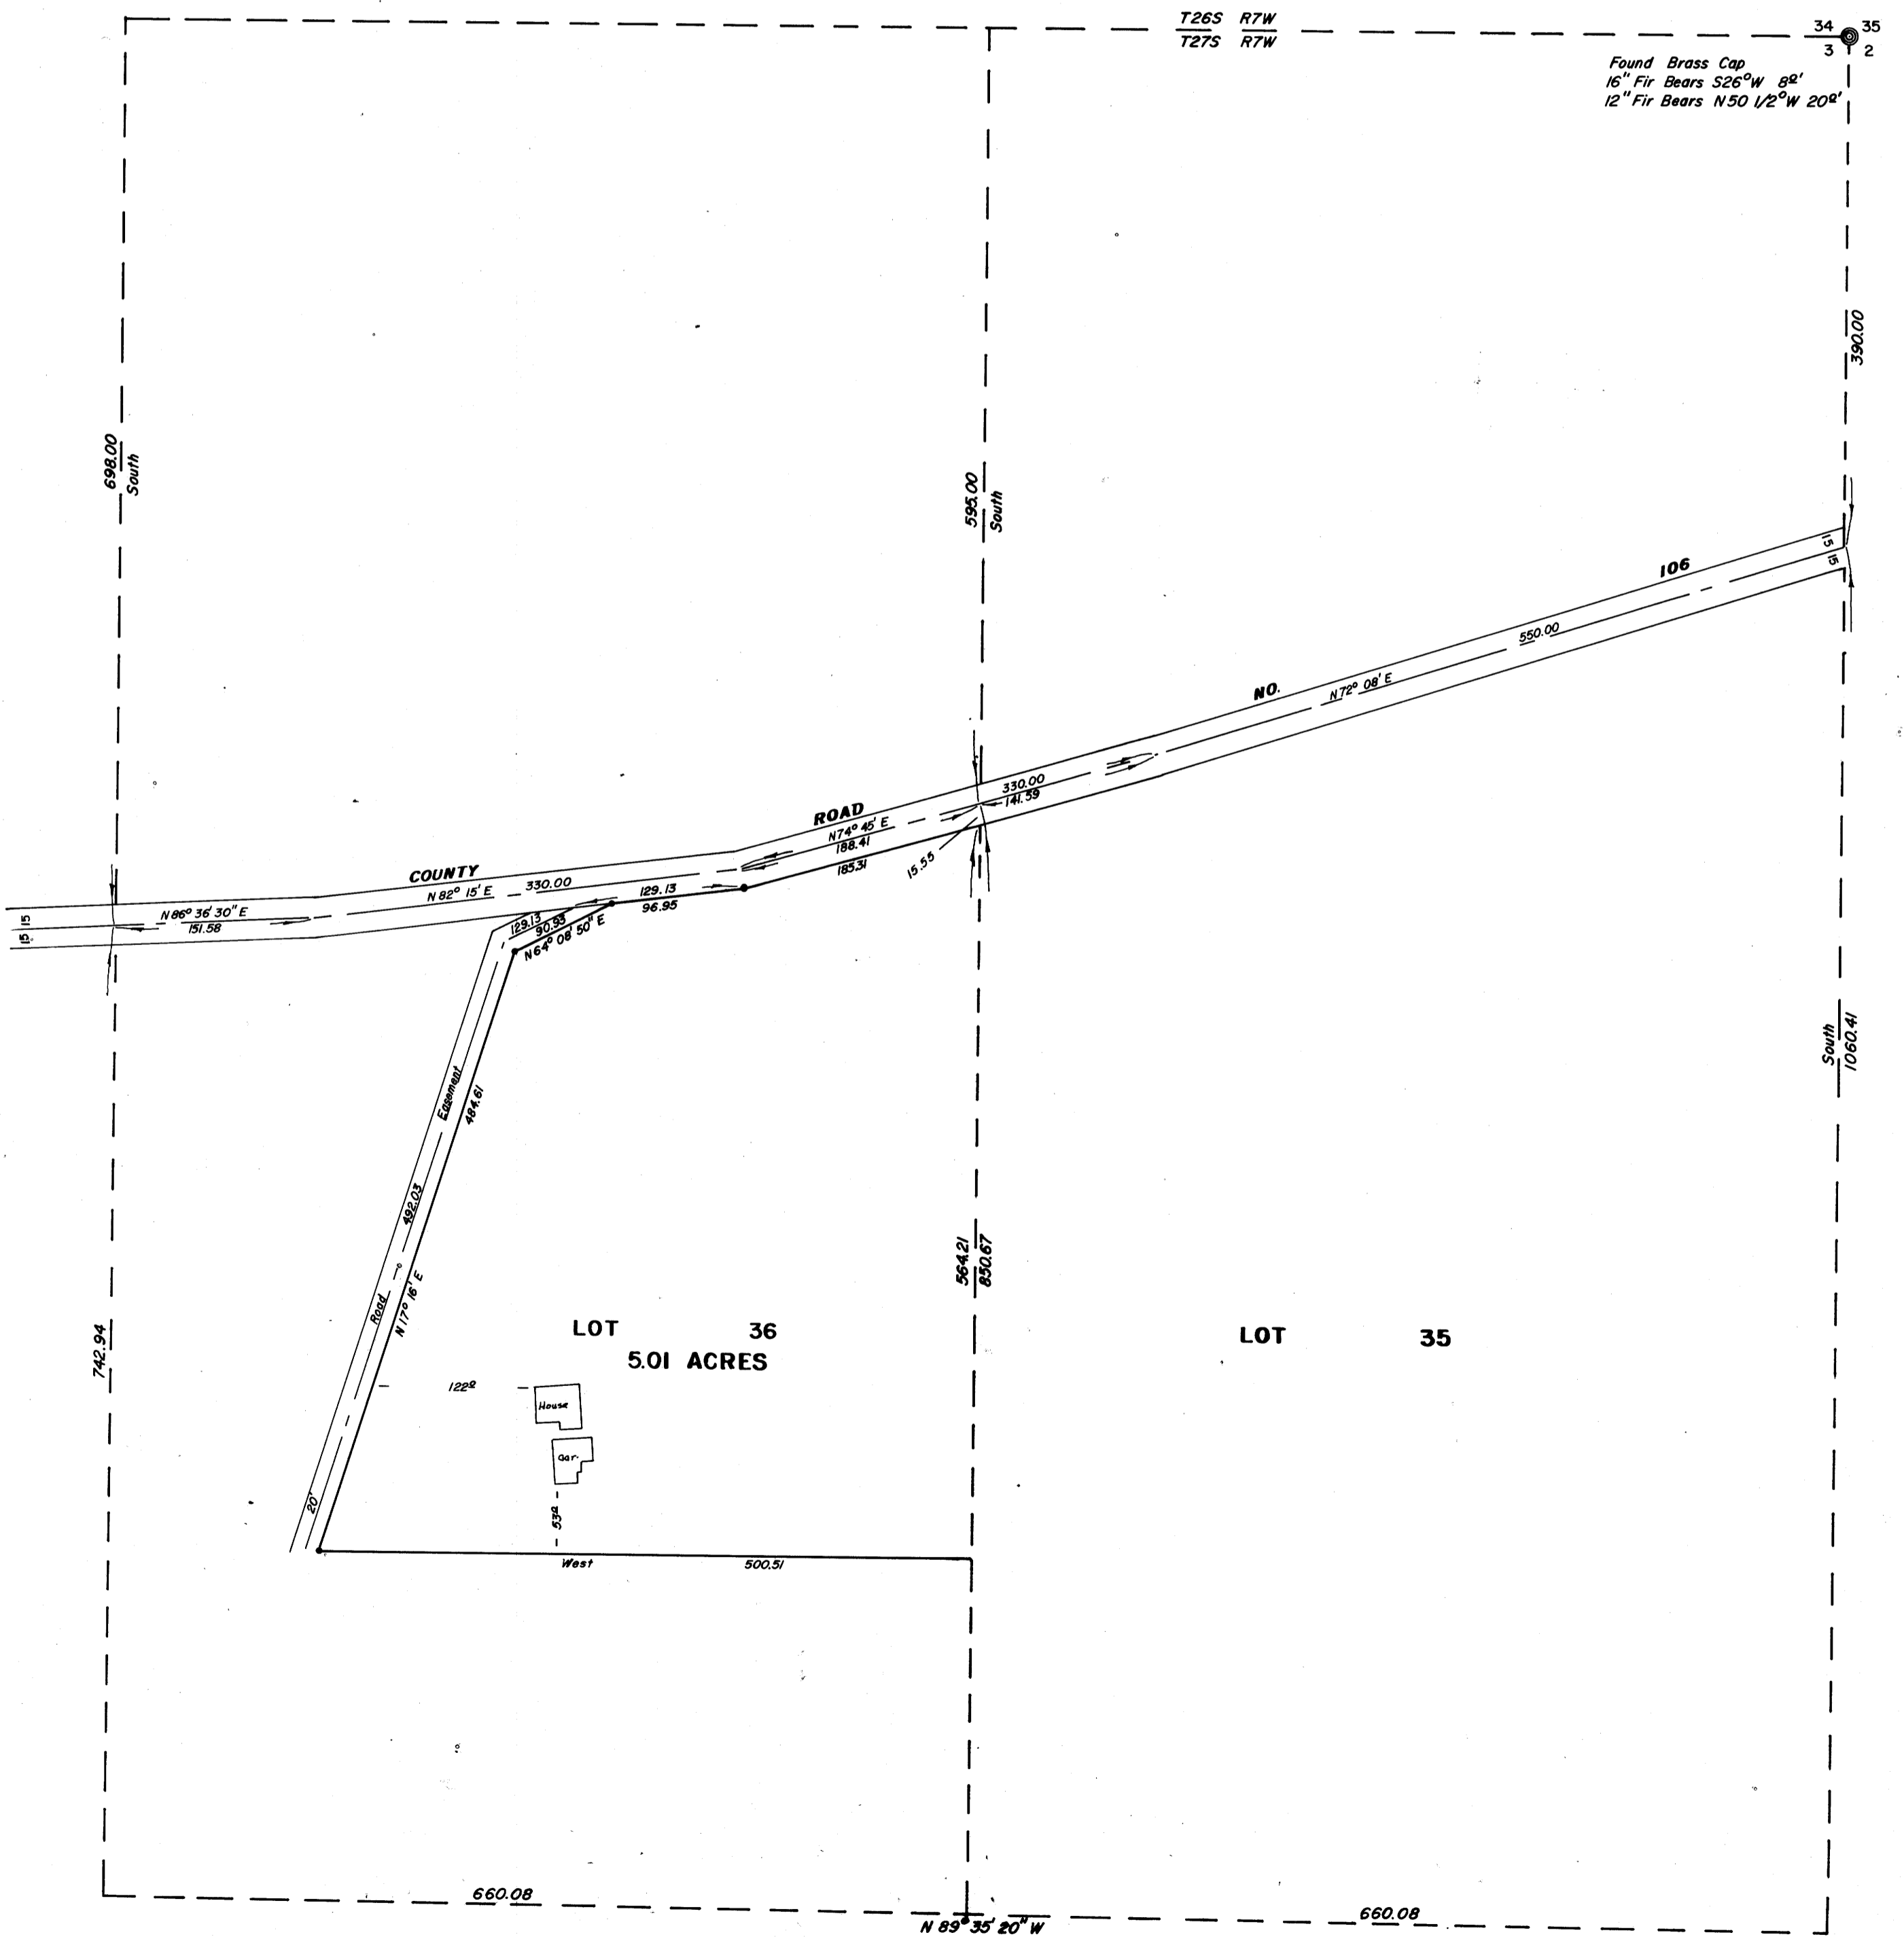

DIAZO COPY MADE
APRIL 1999, USING A
"REPROTECHNOLOGY 5000"
BLUEPRINT MACHINE