
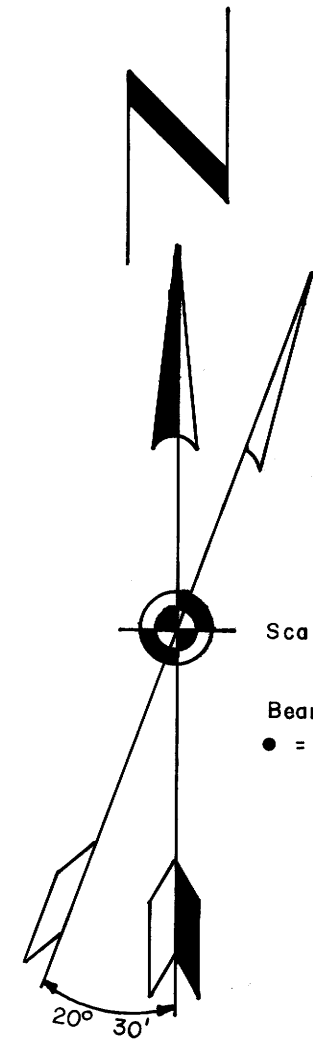


FILED
RECEIVED

AUG 2 1968

COUNTY SURVEYOR
DOUGLAS COUNTY, ORE.

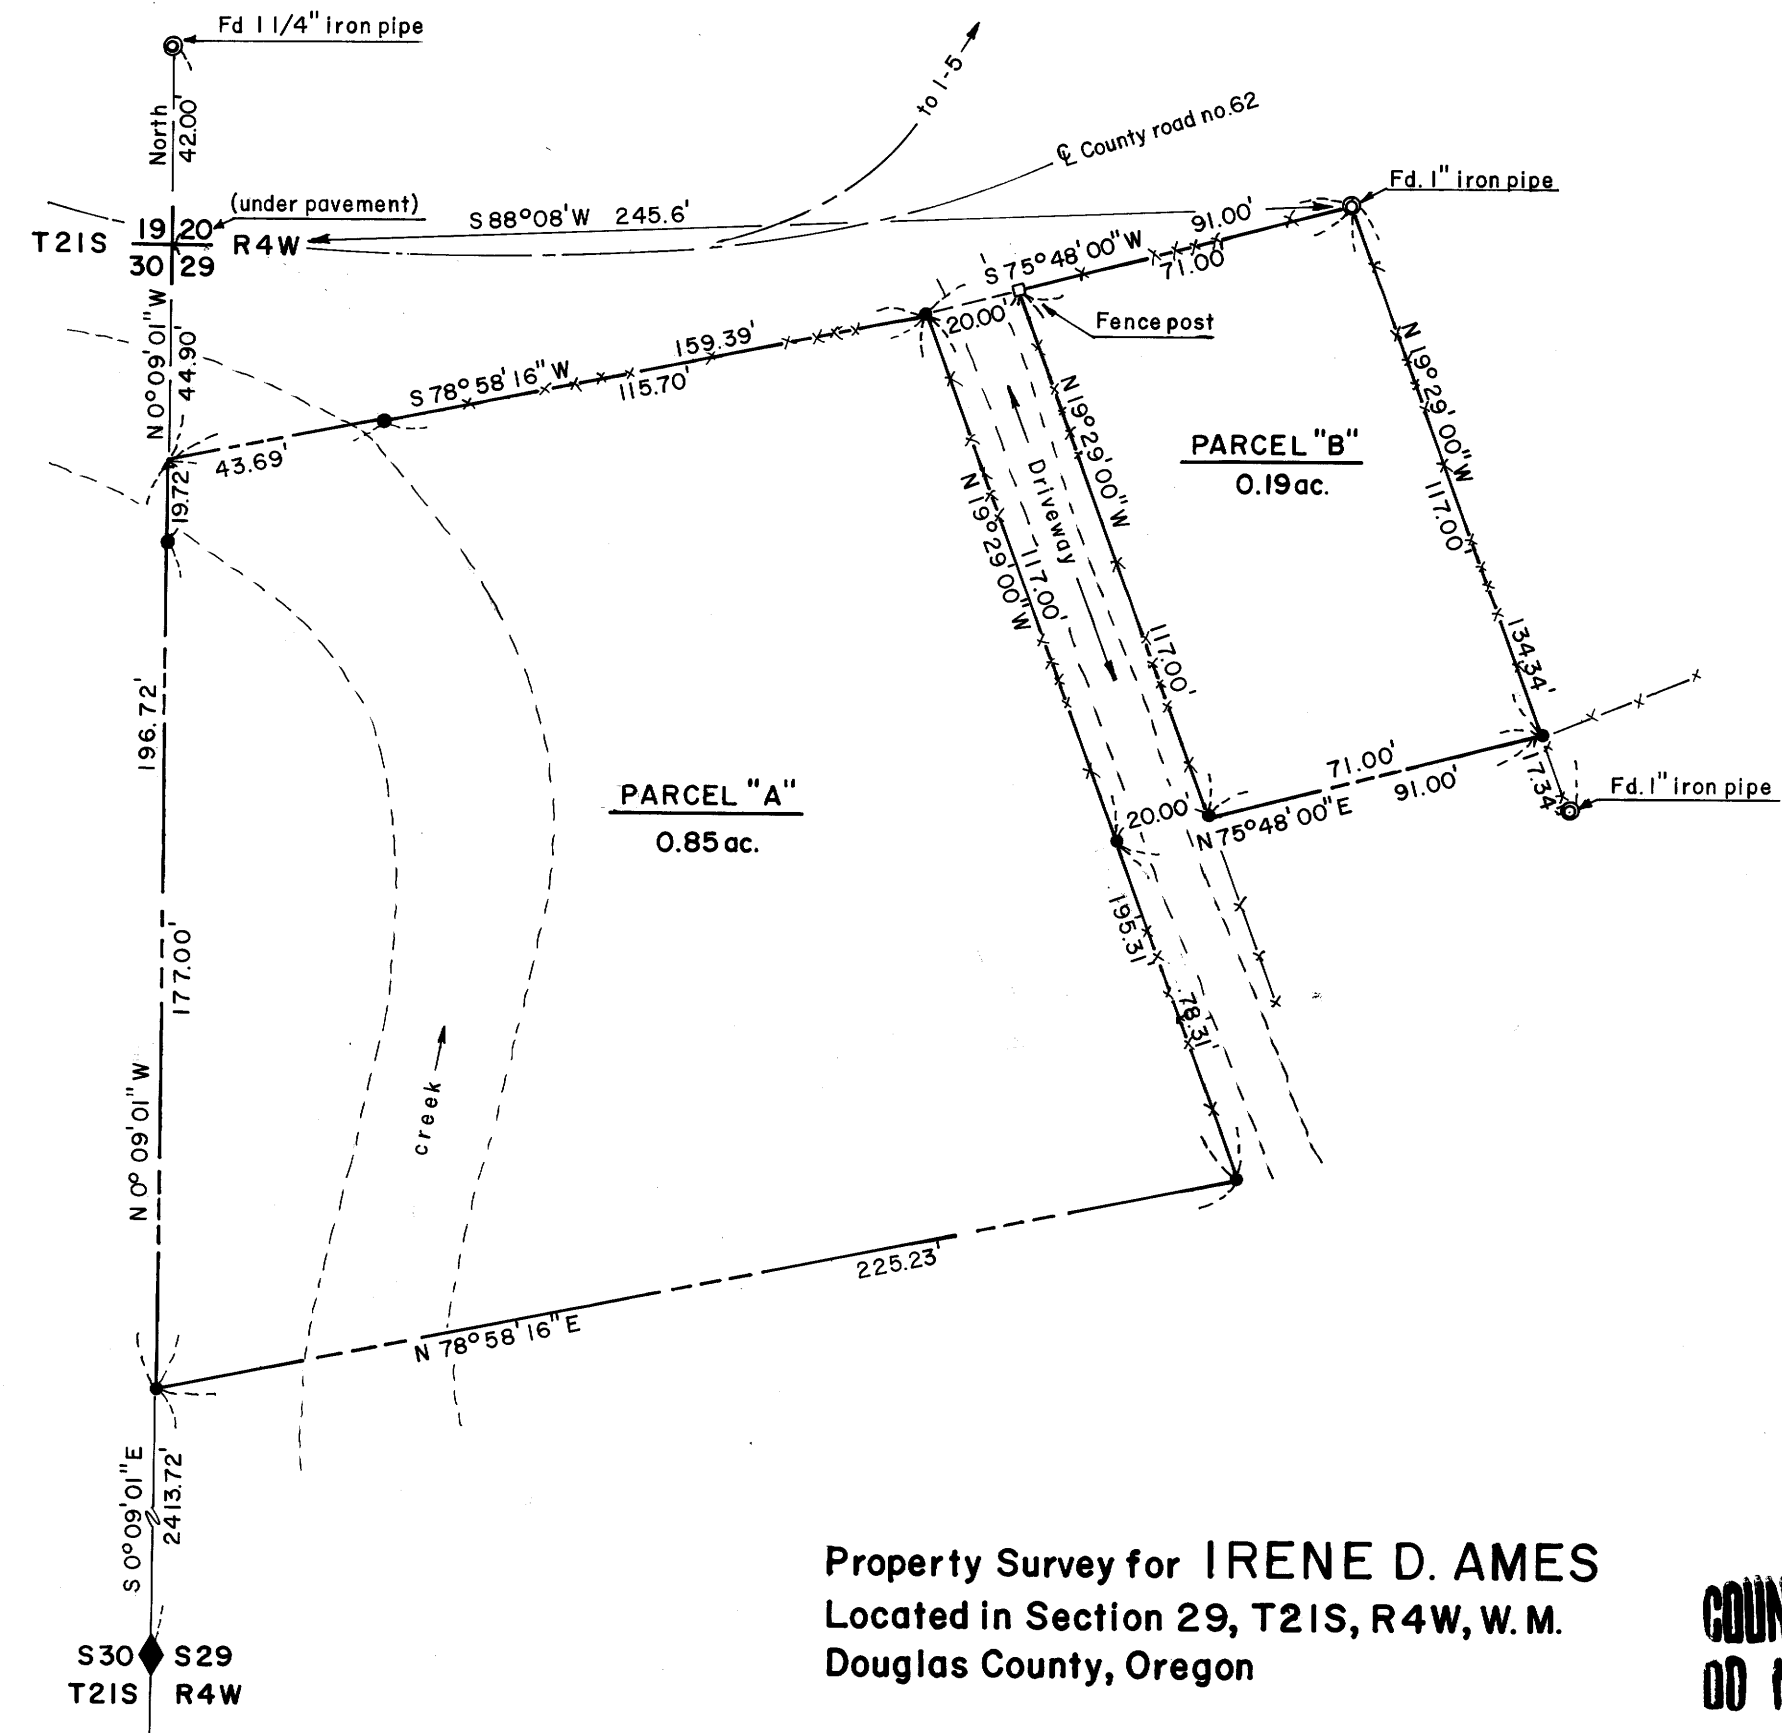

Property Survey for IRENE D. AMES
Located in Section 29, T21S, R4W, W.M.
Douglas County, Oregon

COUNTY SURVEYORS FILE DATA
DO NOT REMOVE FROM OFFICE

REGISTERED
OREGON
LAND SURVEYOR

William C. Stiles

OCT. 4, 1957
WILLIAM C. STILES
432

SEEK, INC. July 25, 1968

M 36-21