


COUNTY SURVEYORS FILE DATA
DO NOT REMOVE FROM OFFICE

SURVEY FOR DEED DESCRIPTION IN LOT 10 OF
EDENBOWER ORCHARD TRACTS
SEC. 1, T. 27 S., R. 6 W. W.M., DOUGLAS CO., ORE.
SURVEYED FOR - PAUL NOTT
SURVEYED BY - W. S. BARNES
JULY 1968.
SCALE 1" = 60'

FILED *LS*
RECEIVED
AUG 9 1968
COUNTY SURVEYOR
DOUGLAS COUNTY, ORE.

9

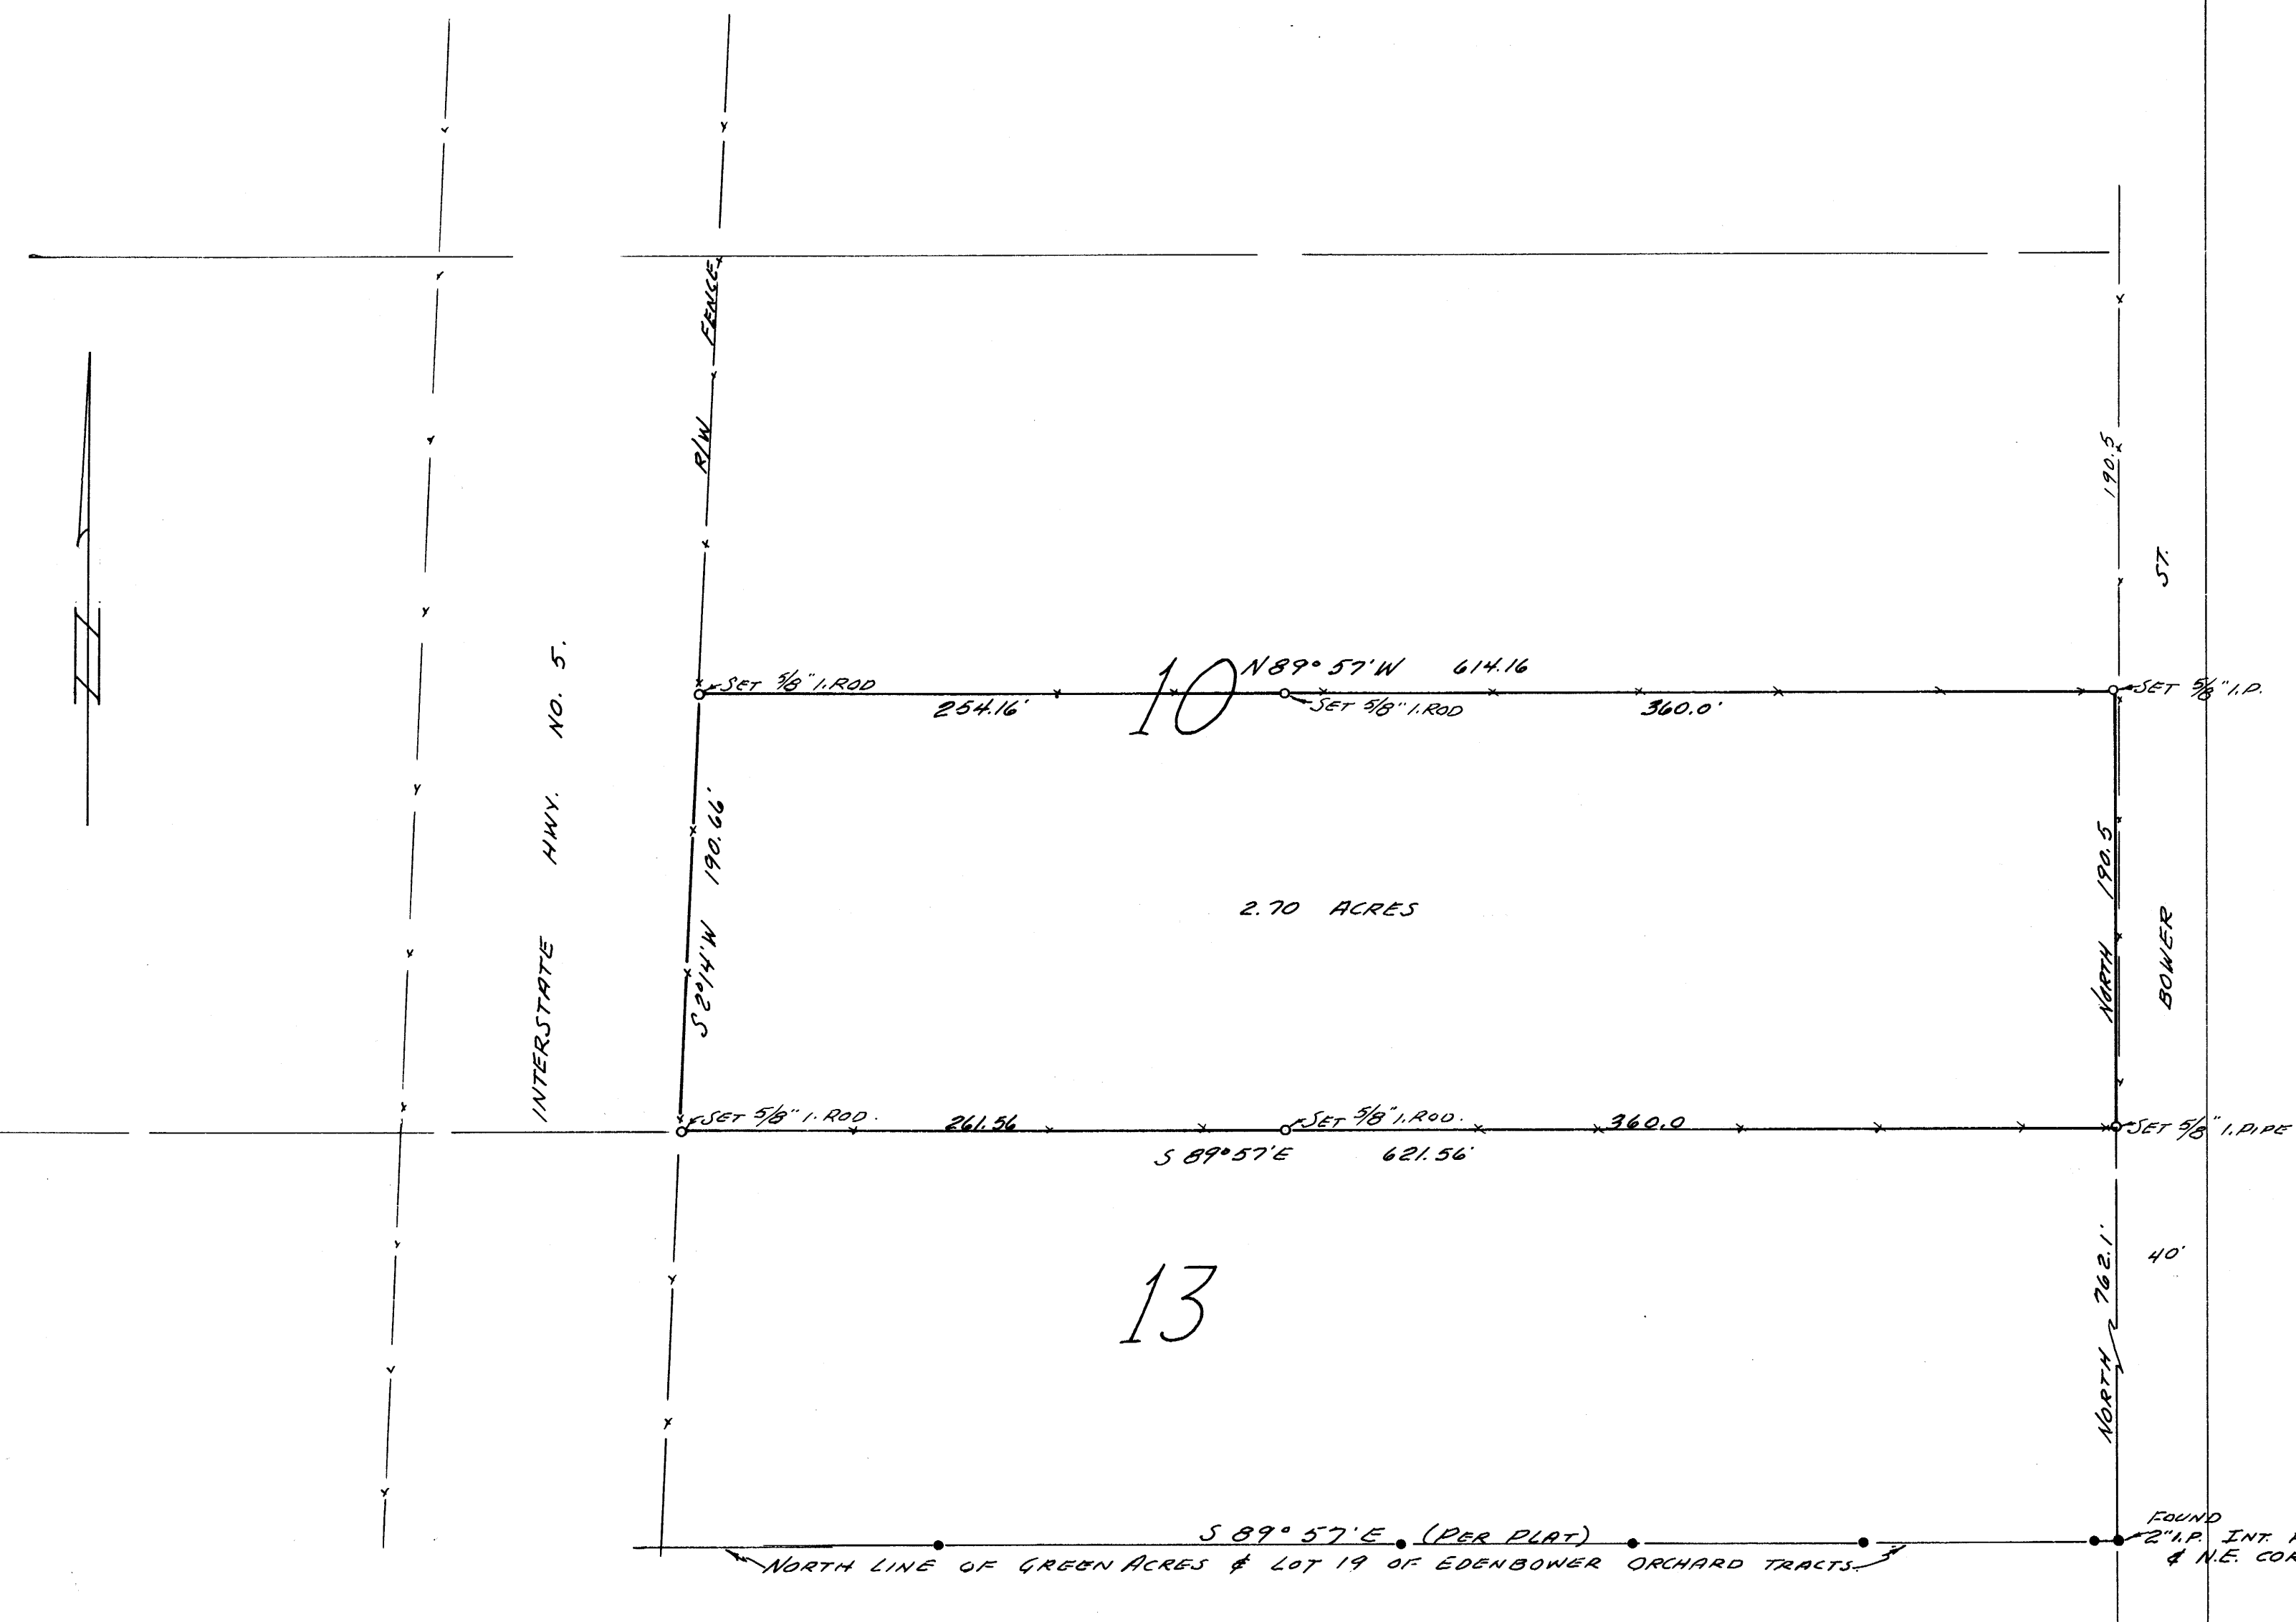

\circ DENOTES MONUMENTS SET.
 \bullet " " " FOUND.
BASE OF BEARINGS TAKEN FROM NORTH LINE OF GREEN ACRES.



MAP FILE M. 36. 7-24

MAP FILE M. 36. 7-24