

FILED
RECEIVED

COUNTY SURVEYORS FILE DATA
DO NOT REMOVE FROM OFFICE


AUG 26 1968

COUNTY SURVEYOR
DOUGLAS COUNTY, ORE.

SURVEY FOR DEED DESCRIPTION
IN D.L.C. NO. 43, T.27 S., R. 6 W. W.M.
SURVEYED FOR - SIG WOLF
SURVEYED BY - W. S. BARNES

AUG. 1968
SCALE 1"=100'

N.E. COR. JACOB JONES
D.L.C. NO. 43.

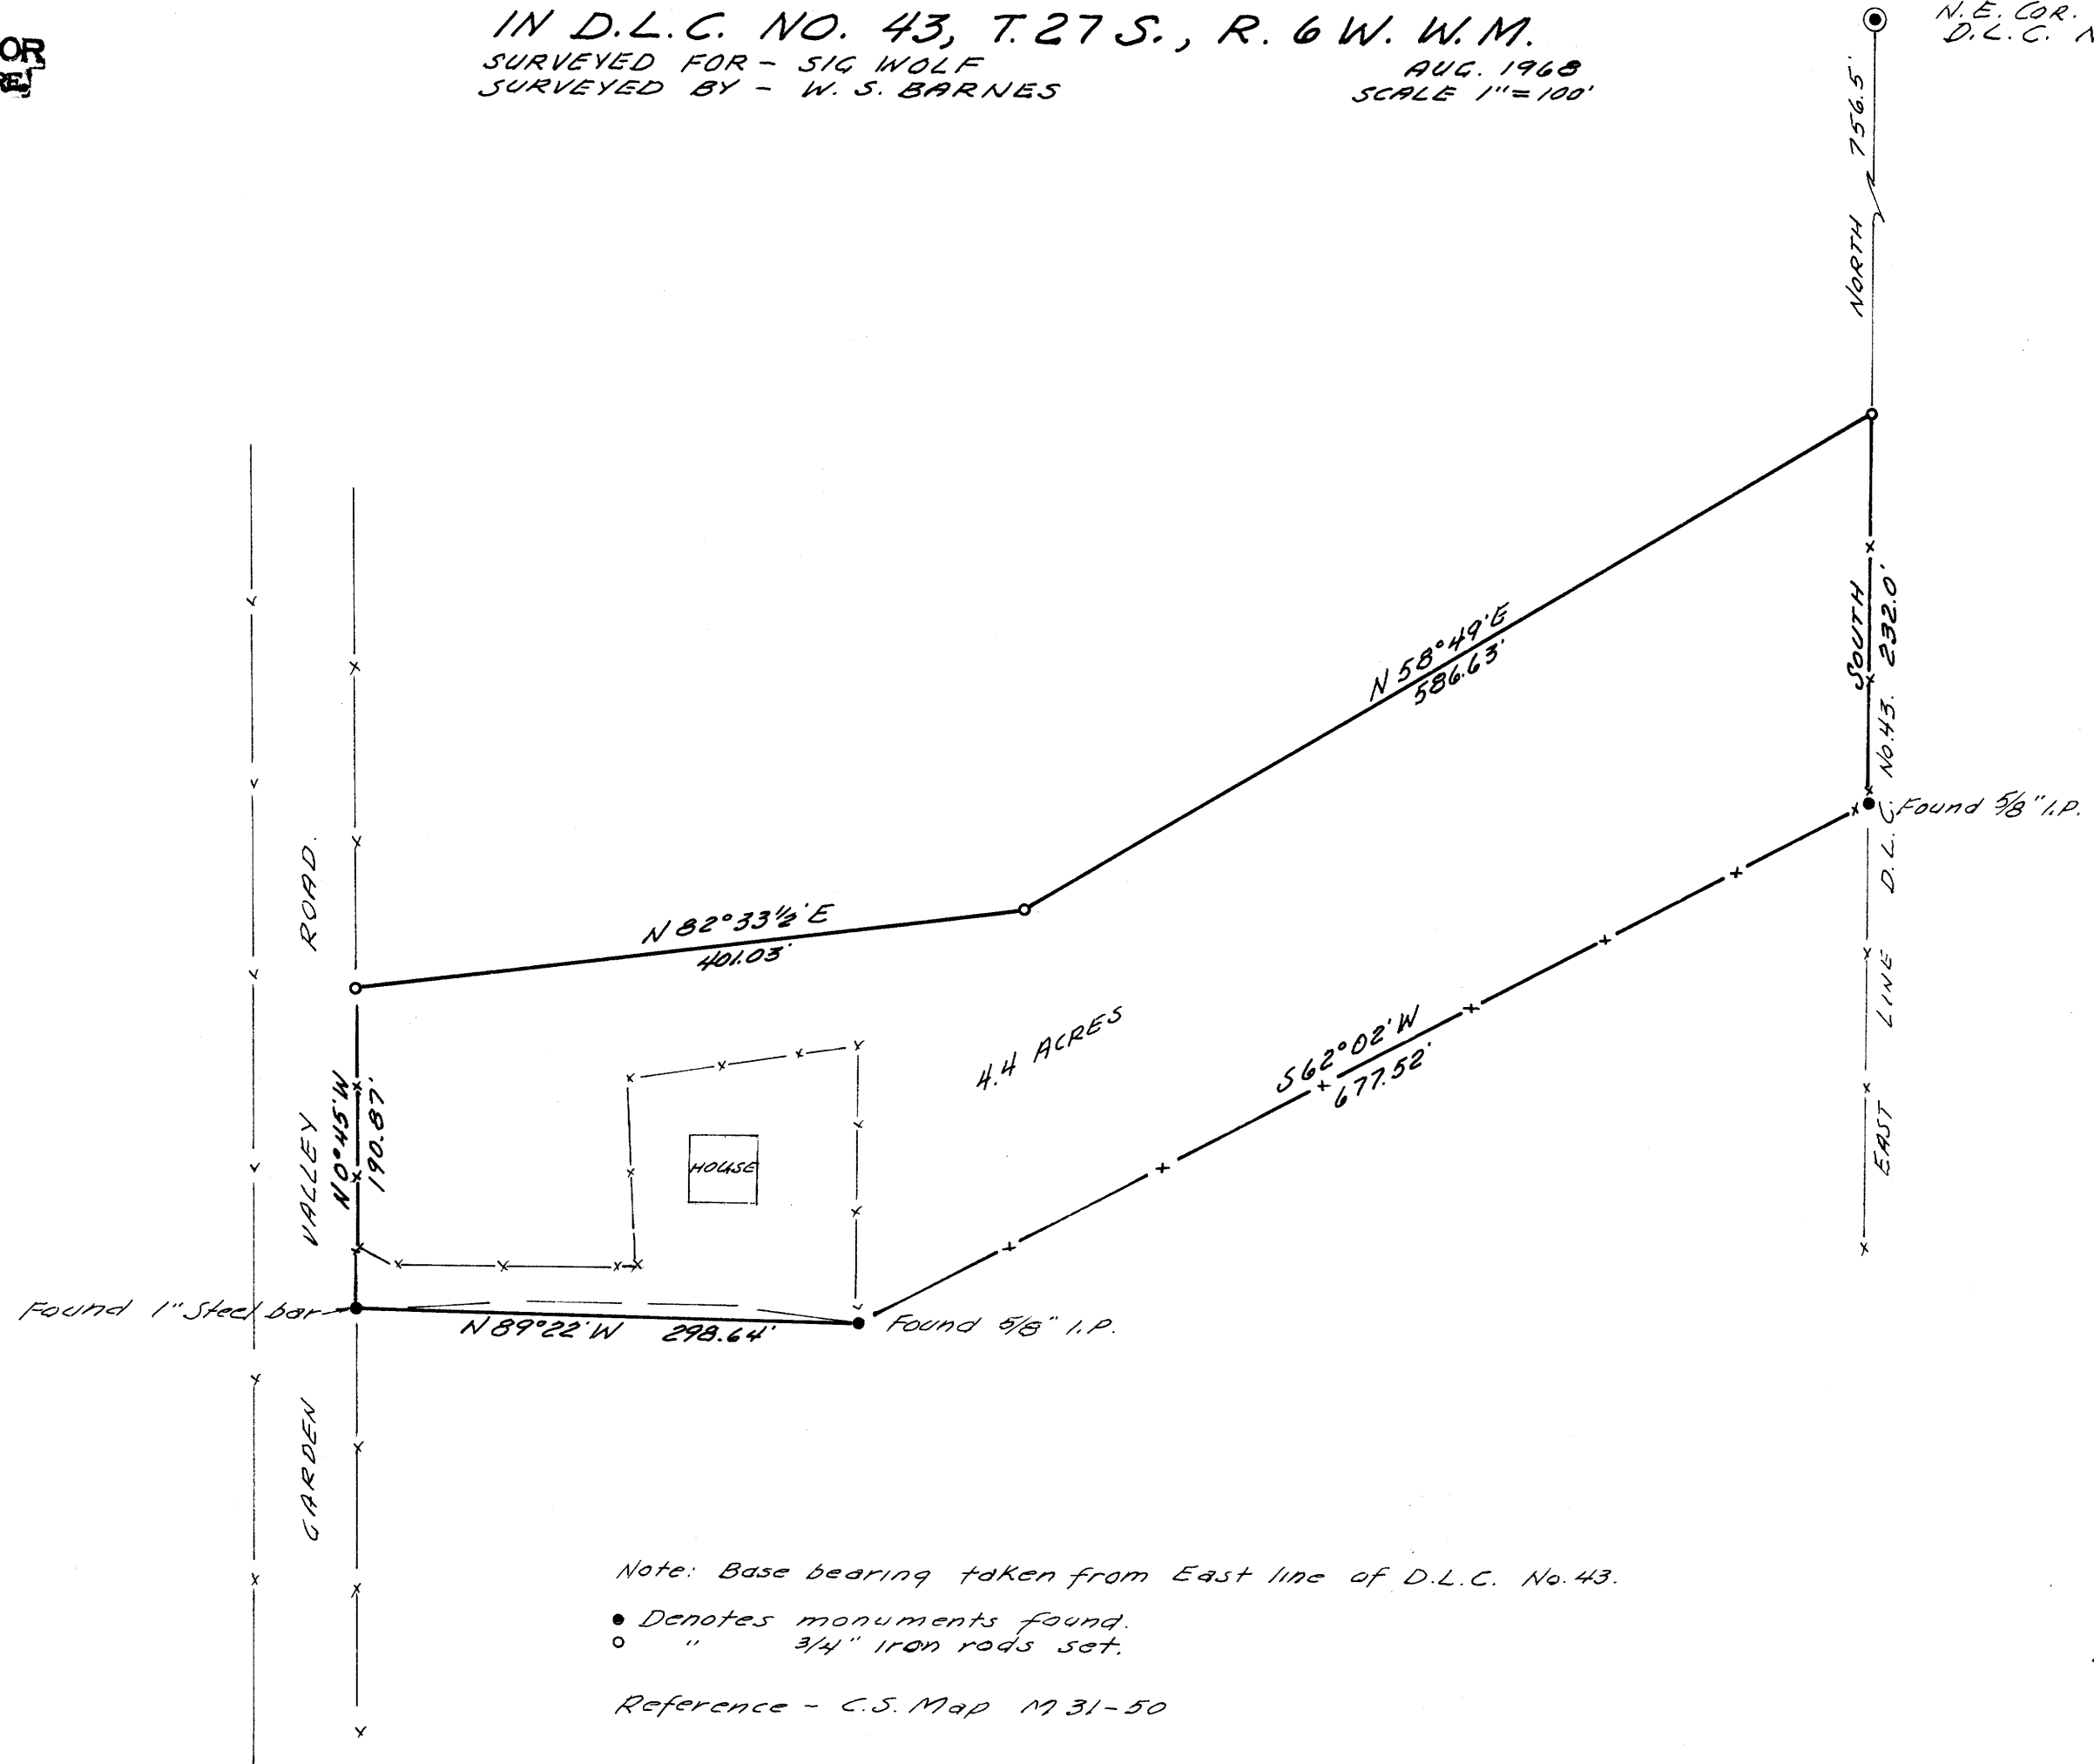

Note: Base bearing taken from East line of D.L.C. No. 43.

- Denotes monuments found.
- " 3/4" iron rods set.

Reference - C.S. Map M 31-50



MAP FILE M-36-1-30

MAP FILE M 36 1 30