

COUNTY SURVEYORS FILE DATA  
DO NOT REMOVE FROM OFFICE



FILED *[Signature]*  
RECEIVED

SEP 12 1968

COUNTY SURVEYOR  
DOUGLAS COUNTY, ORE.

Survey for Frank Kinnan  
Located in Section 6, T29S, R8W, W.M.  
Douglas County, Oregon

by SEEK, INC. August 14, 1968

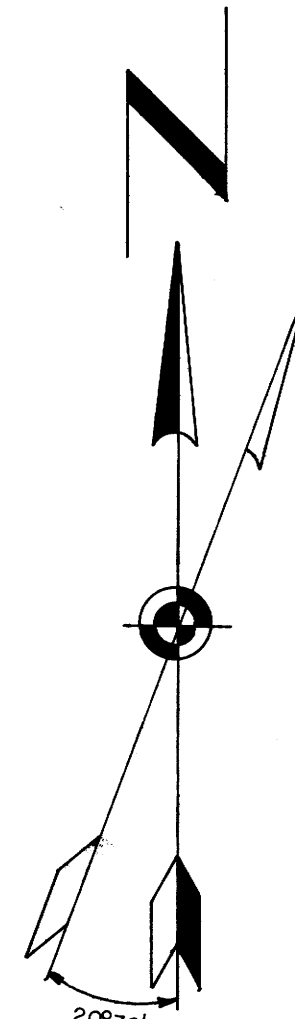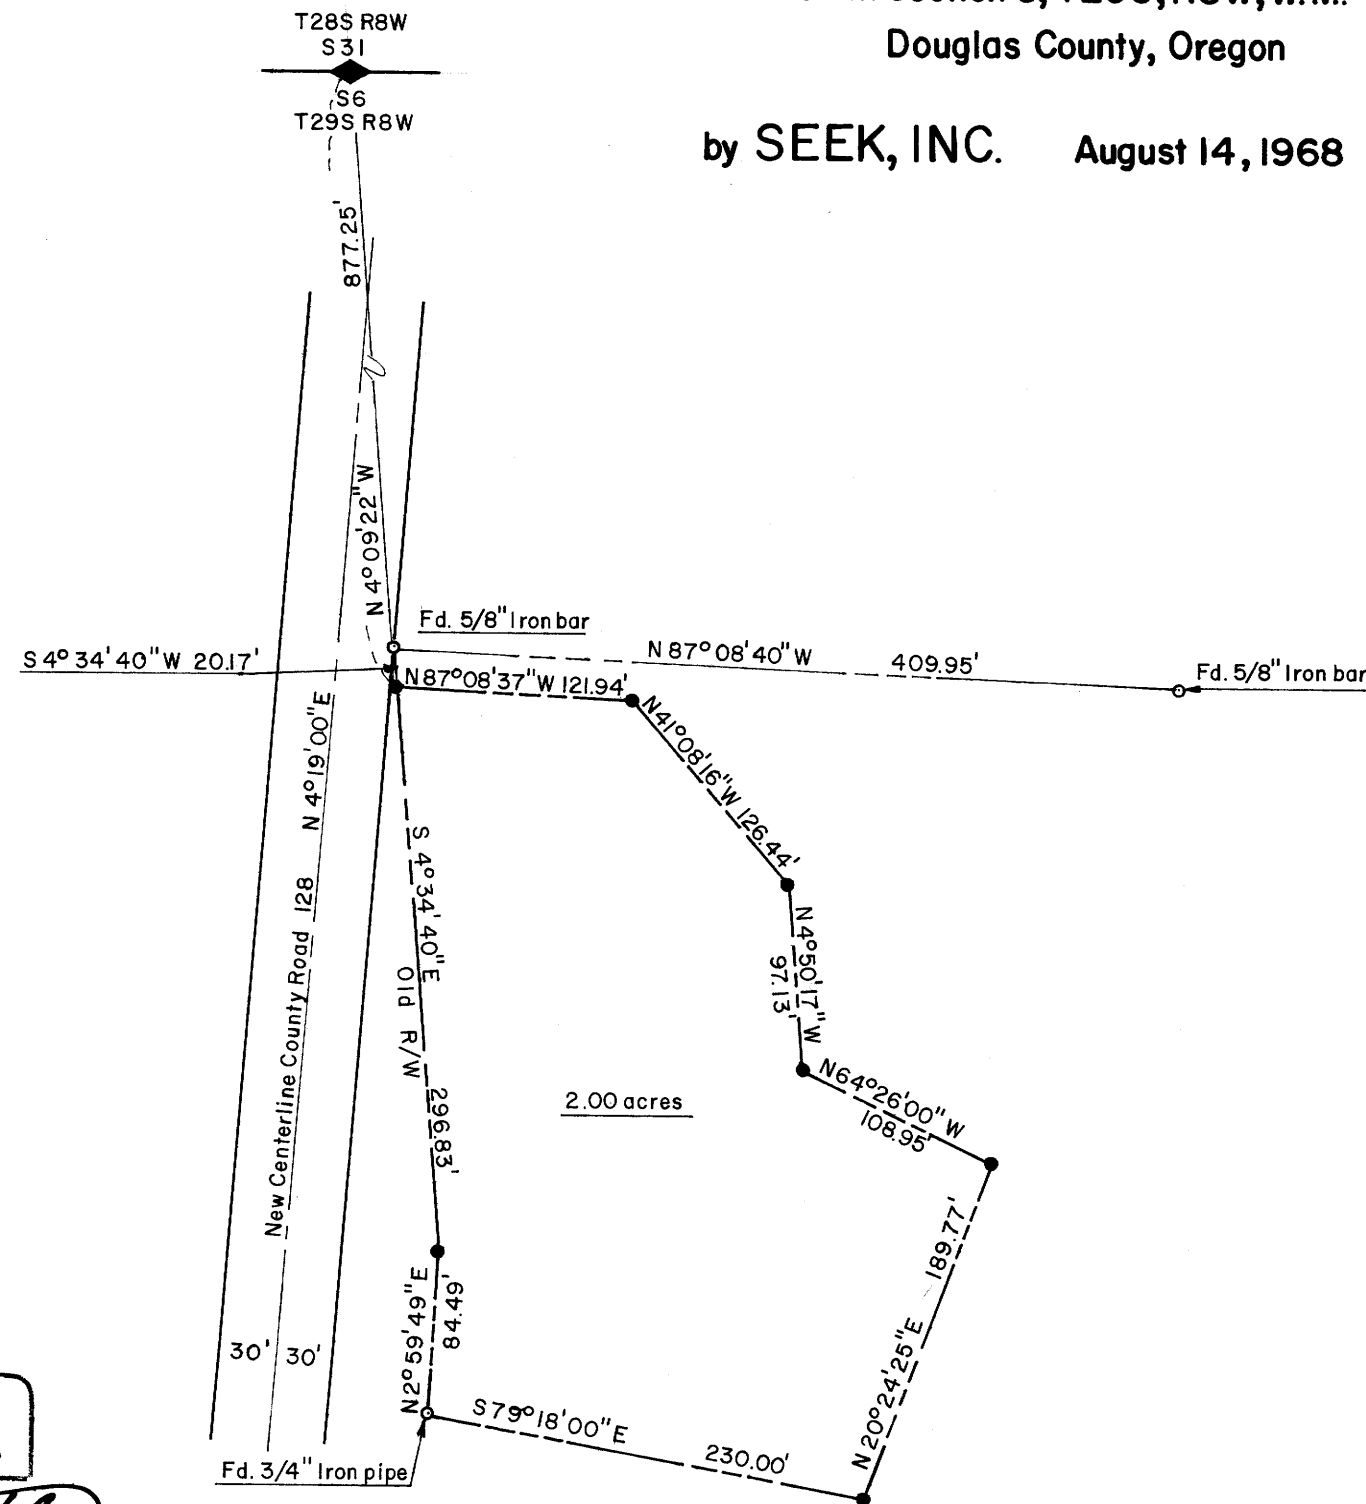

Scale: 1" = 100'

● 5/8" iron bar set  
Bearings from Douglas County  
Surveyor's File M35-32

REGISTERED  
OREGON  
LAND SURVEYOR  
*William C. Stiles*  
OCT. 4, 1957  
WILLIAM C. STILES  
432

MAP FILE M36-1-37

M36-37  
ME P