

REGISTERED
OREGON
LAND SURVEYOR
William C. Stiles
OCT. 4, 1957
WILLIAM C. STILES
1932

Note: Bearings based on Solar Observations.
Corner of Sections 1, 2, 11 & 12 established per suggested procedure in letter No. 9180 (100.4c) from the Oregon State Office of the Bureau of Land Management, U.S. Department of the Interior, dated August 20, 1968.

COUNTY SURVEYORS FILE DATA
DO NOT REMOVE FROM OFFICE

Survey for Jackson Beaman
Located in Sections 12 & 13, T23S, R10W, W.M.,
Douglas County, Oregon

SEEK, INC.
Roseburg, Oregon
September 13, 1968

Jackson Beaman Property
Sections 12 & 13, T23S, R10W, W.M.
Douglas County, Oregon

1/4 Corner, Sections 1 & 12

Set 2-1/2" Brass Cap Marked

SEEK, Inc.
T23S
1/4
S1

S12
R10W
1968

Bearing Tree 12" Maple S72°E 13.0'
Marked 1/4
S12

6" Cross in Rock Wall N76°W 20.5'
Marked 1/4
S1

#75

East 1/4 Corner, Section 12

Set 2-1/2" Brass Cap Marked

SEEK, Inc.
T23S
1/4
S
12
R10W
1968

Bearing Tree 30" Fir N18°W 28.0'
Marked 1/4
S12

Bearing Tree 36" Fir S78°W 19.7'
Marked 1/4
S12

#54-T23-9
#76-T23-10

West 1/16 Corner, Sections 12 & 13

Set 5/8" Iron Bar

Bearing Tree 8" Ash N58°E 9.2'
Marked W 1/16
S 12

Bearing Tree 8" Chinquapin S36°W 36.0'
Marked W 1/16
S 13

FILED
RECEIVED

OCT 3 1968

COUNTY SURVEYOR
DOUGLAS COUNTY, OREGON

C.S. File 55/89A

Map File M36 + 42

Jackson Beaman Property
Sections 12 & 13, T23S, R10W, W.M.
Douglas County, Oregon
Page -2-

South 1/16 Corner, Sections 11 & 12

Set 5/8" Iron Bar

Bearing Tree 38" Maple N70°E 22.0'
Marked S 1/16
S 12

Bearing Tree 12" Fir S83°W 34.0'
Marked S 1/16
S 11

Southwest 1/16 Corner, Section 12

Set 5/8" Iron Rod

Bearing Tree 8' Myrtlewood N80°E 4.2'
Marked SW 1/16
S 12

Bearing Tree 22" Fir S2°W 20.0'
Marked SW 1/16
S 12

South Center 1/16 Corner, Section 12

Set 5/8" Iron Rod

Bearing Tree 36" Myrtlewood North 52.0'
Marked CS 1/16
S 12

Bearing Tree 8' Myrtlewood N74°W 79.8'
Marked CS 1/16
S 12

FILED
REGISTERED

OCT 3 1955

C.S. File 55/896

COUNTY SURVEYOR
DOUGLAS COUNTY, OREGON

Map File M.36 + 42

Jackson Beaman Property
Sections 12 & 13, T23S, R10W, W.M.
Douglas County, Oregon
Page -3-


Witness Corner Center 1/4, Section 12

Set 5/8" Iron Rod 128.48' S0°46'42"E of Center of Section

Bearing Tree 18" Fir S28°E 36.8'
Marked W.C.
C 1/4
S 12

Bearing Tree 6" Fir N10°W 5.0'
Marked W.C.
C 1/4
S 12

#77

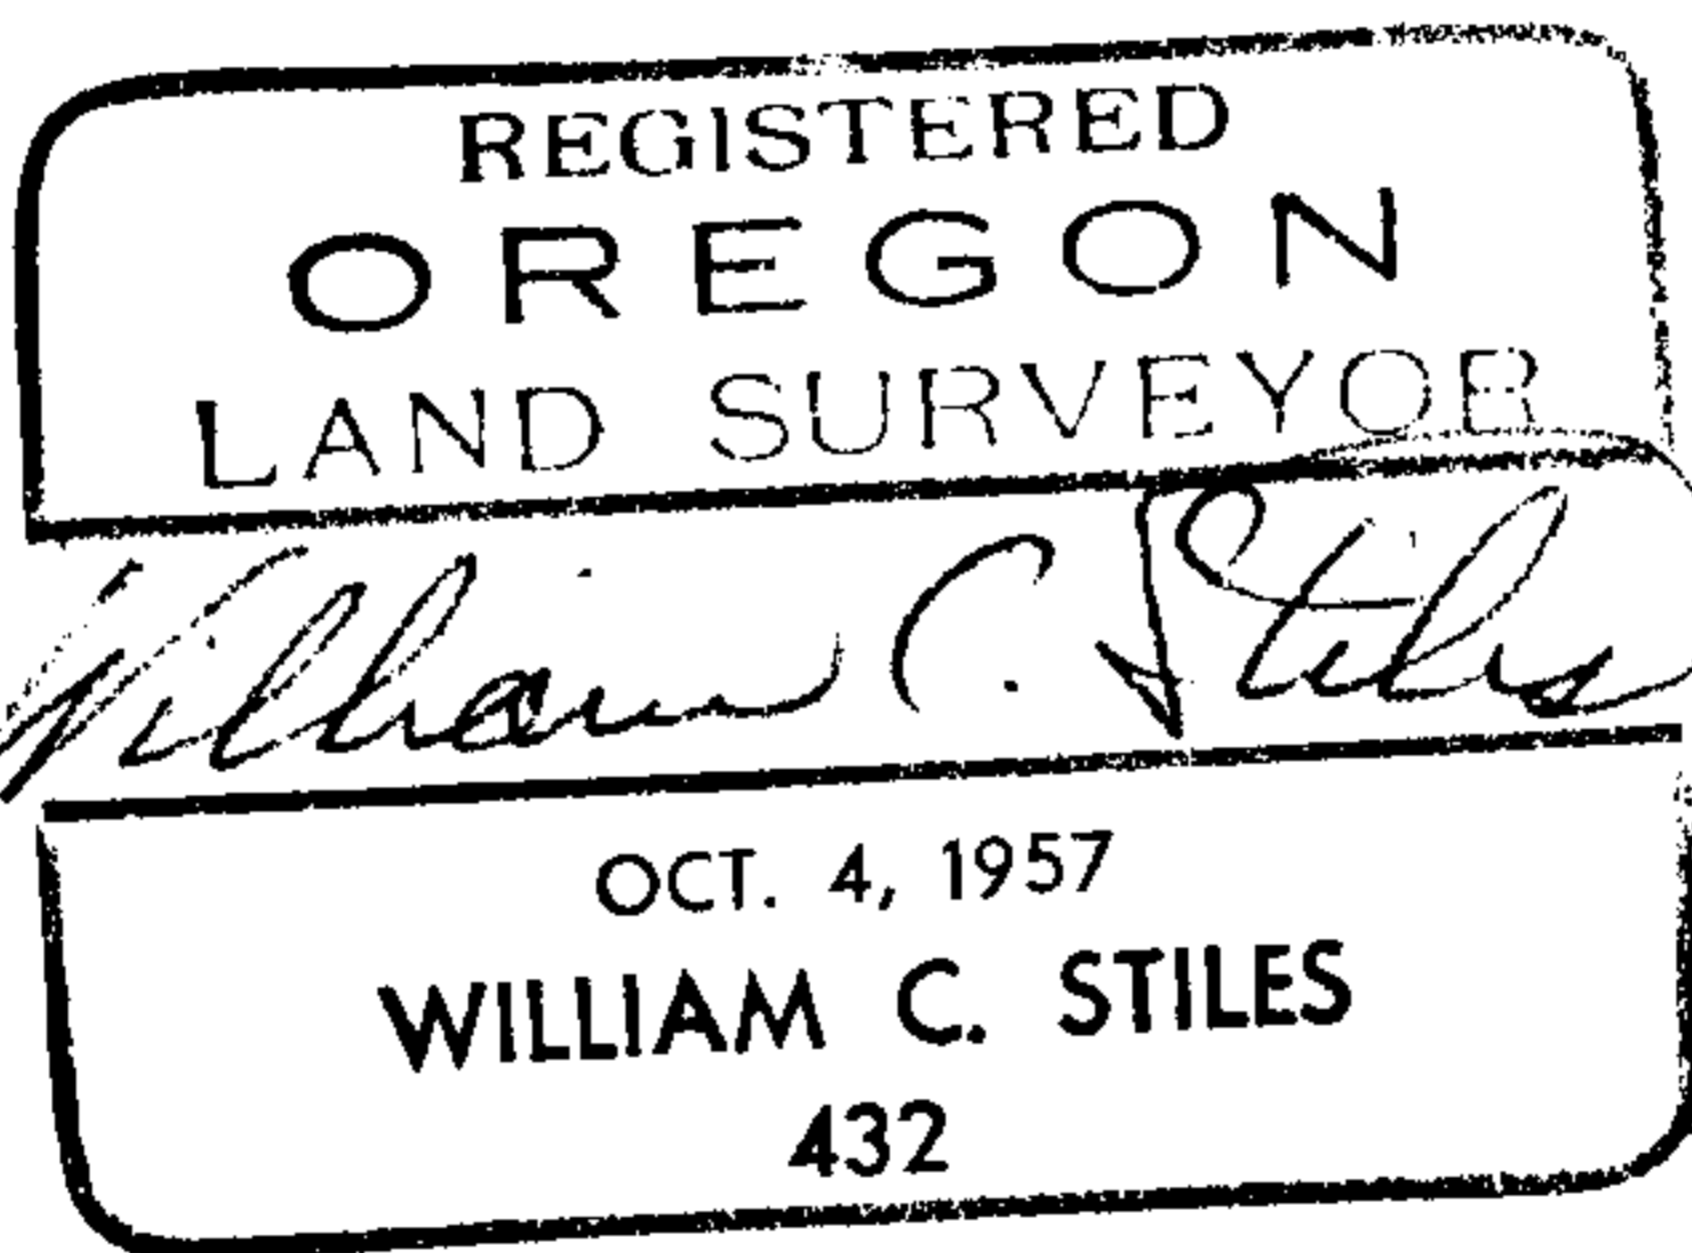

FILED
REGISTERED
OCT 3 1957
C.S. File 55/89C
COUNTY SURVEYOR
DOUGLAS COUNTY, OREGON
Map File M36 + 42