


FILED
RECORDED
OCT 8 1966
COUNTY SURVEYOR
DOUGLAS COUNTY, ORE.

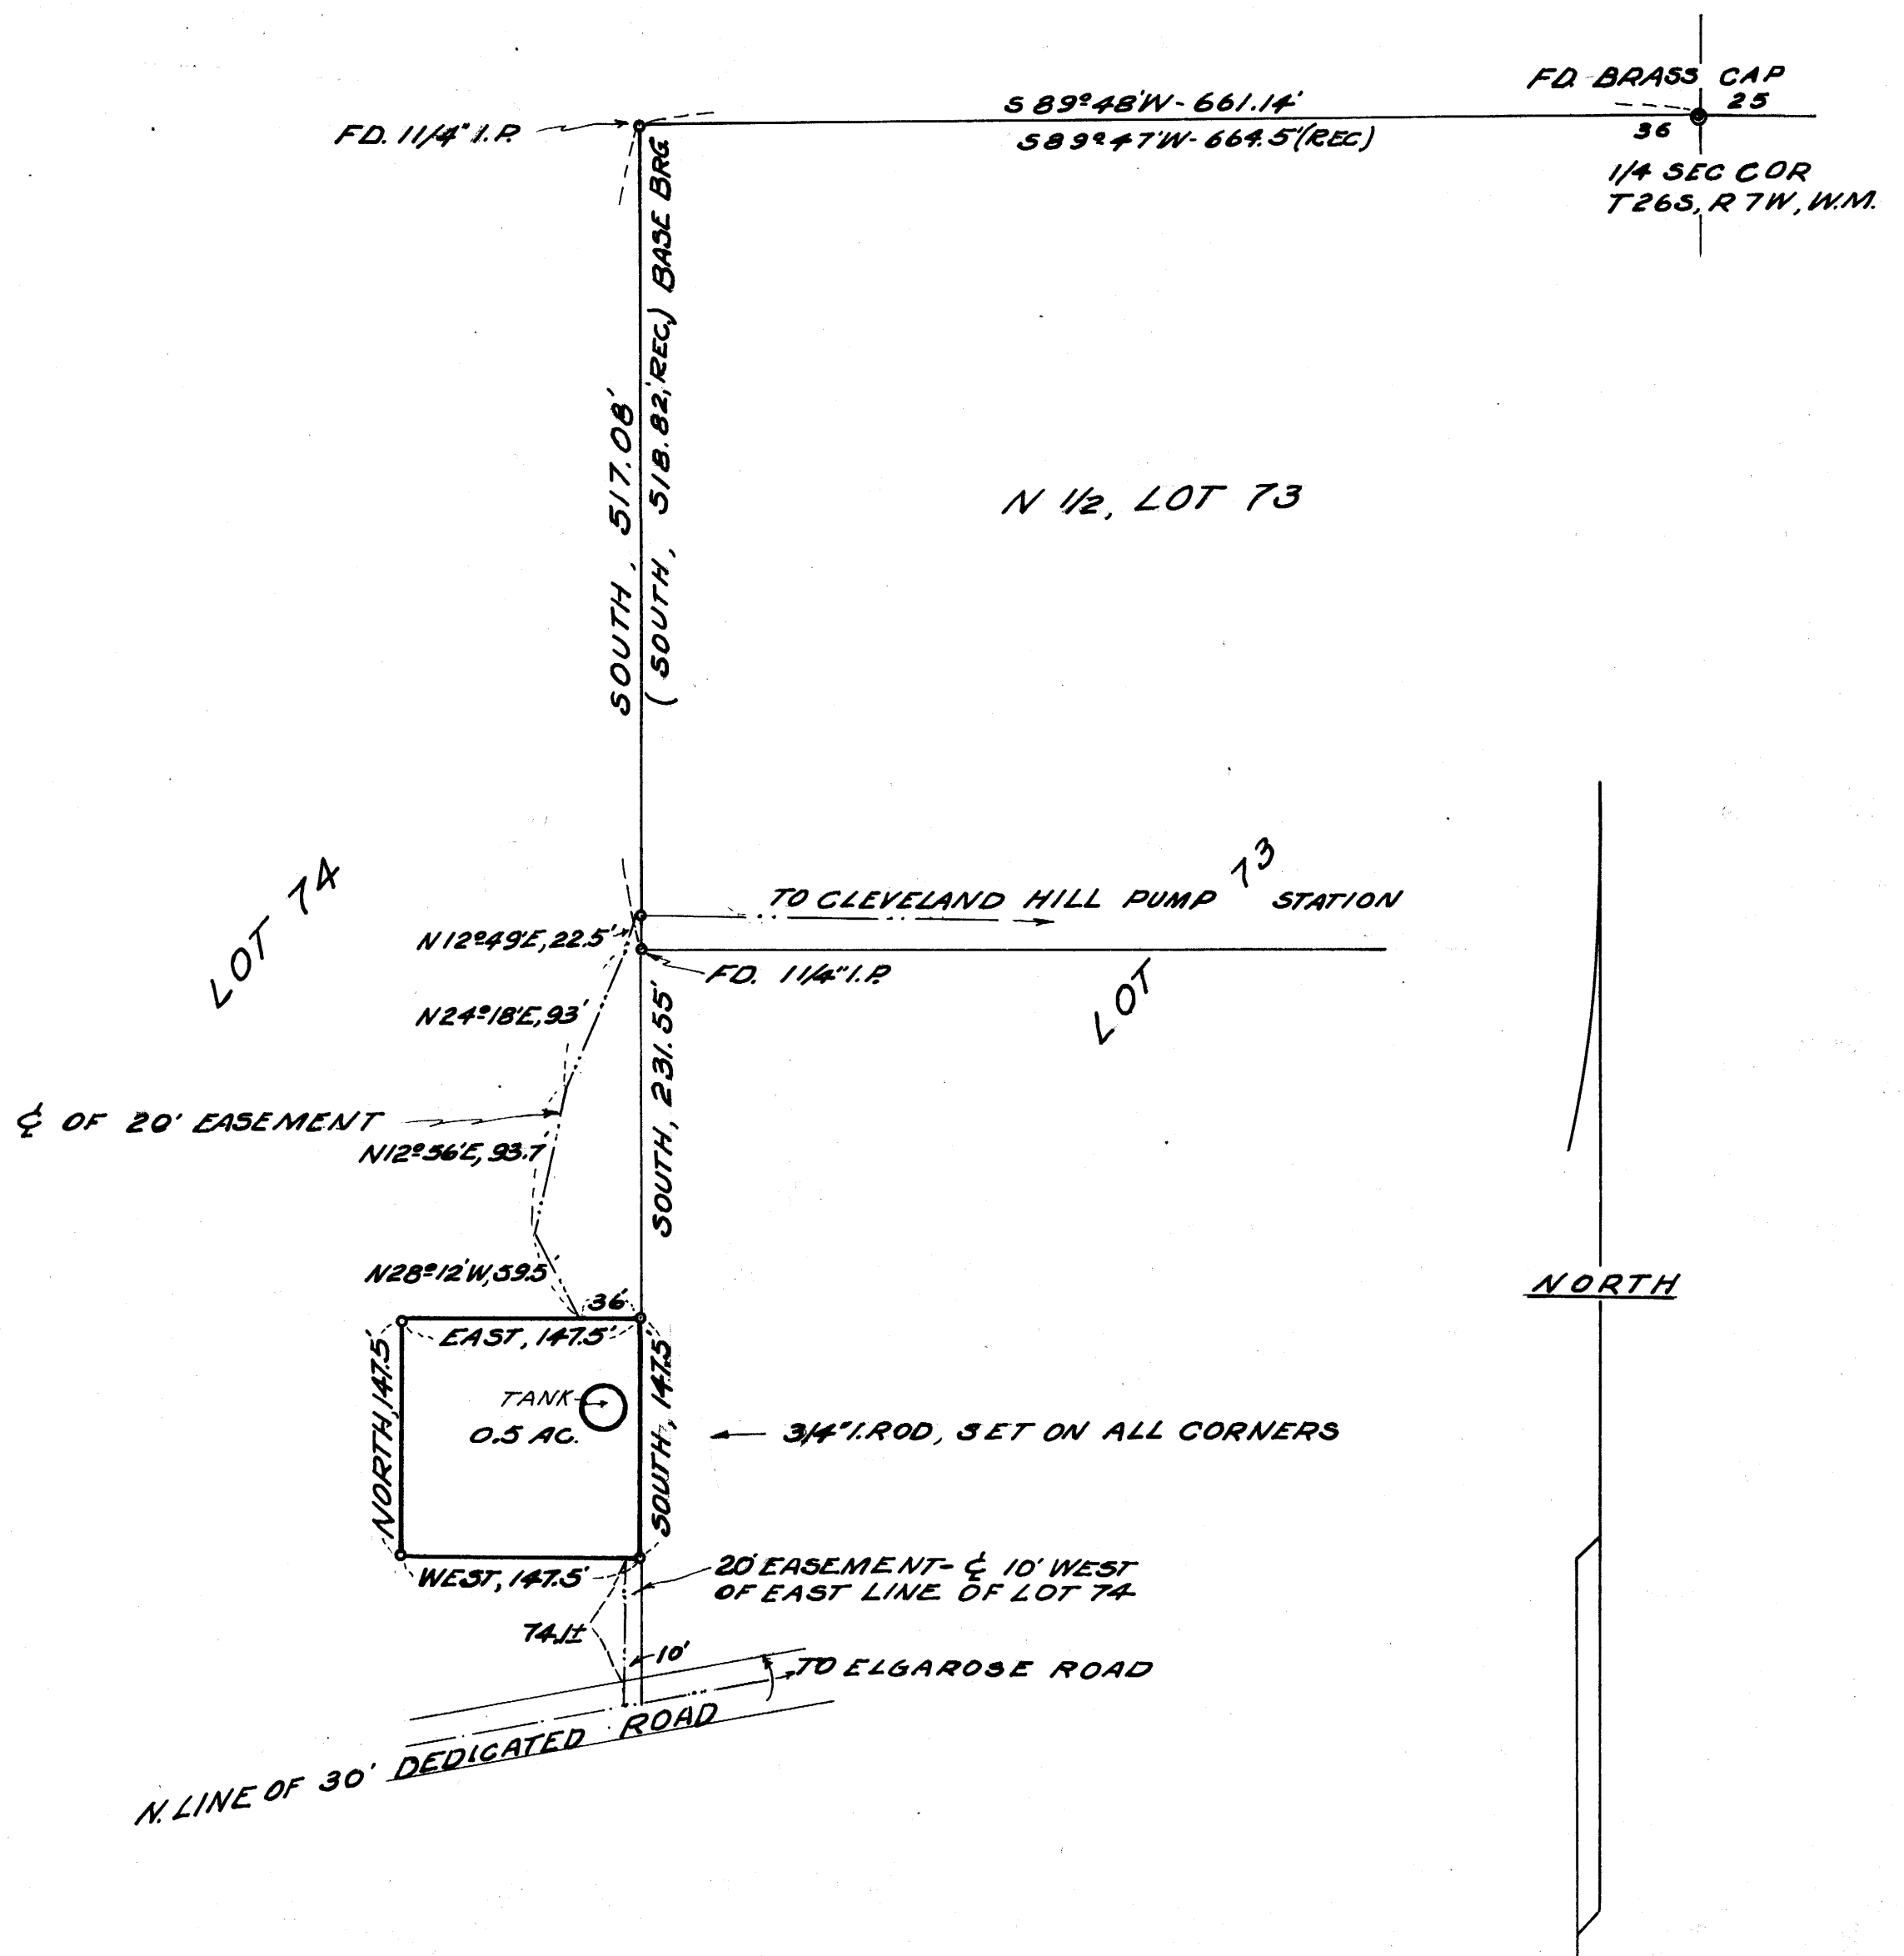

REGISTERED
OREGON
LAND SURVEYOR

Herbert L. Northcraft

JULY 8, 1966
HERBERT L. NORTHCRAFT
75Q

BASE BEARING SOUTH
A/C C.S. 40/448

COUNTY SURVEYORS FILE DATA
DO NOT REMOVE FROM OFFICE

| | |
|---|-----------------|
| UMPQUA BASIN WATER ASSOC. INC ROSEBURG, ORE. | |
| SURVEY FOR TANK SITE IN LOT 74, MELROSE ORCHARDS, SUBD. IN SEC. 36, T26S, R7W, W.M. DOUGLAS CO, ORE. ON R.L. McDONALD PROPERTY | |
| SCALE 1" = 100' | MAY-1967 |
| SURVEY BY - H.L.N. | MAP BY - H.L.N. |