

DO NOT REMOVE FROM OFFICE


M 367 72

DEC 16 1968

FIRST ADDITION TO ELKTON BLOCKS 10 + 11

Scale: 1" = 100'

Dec 14, 1968

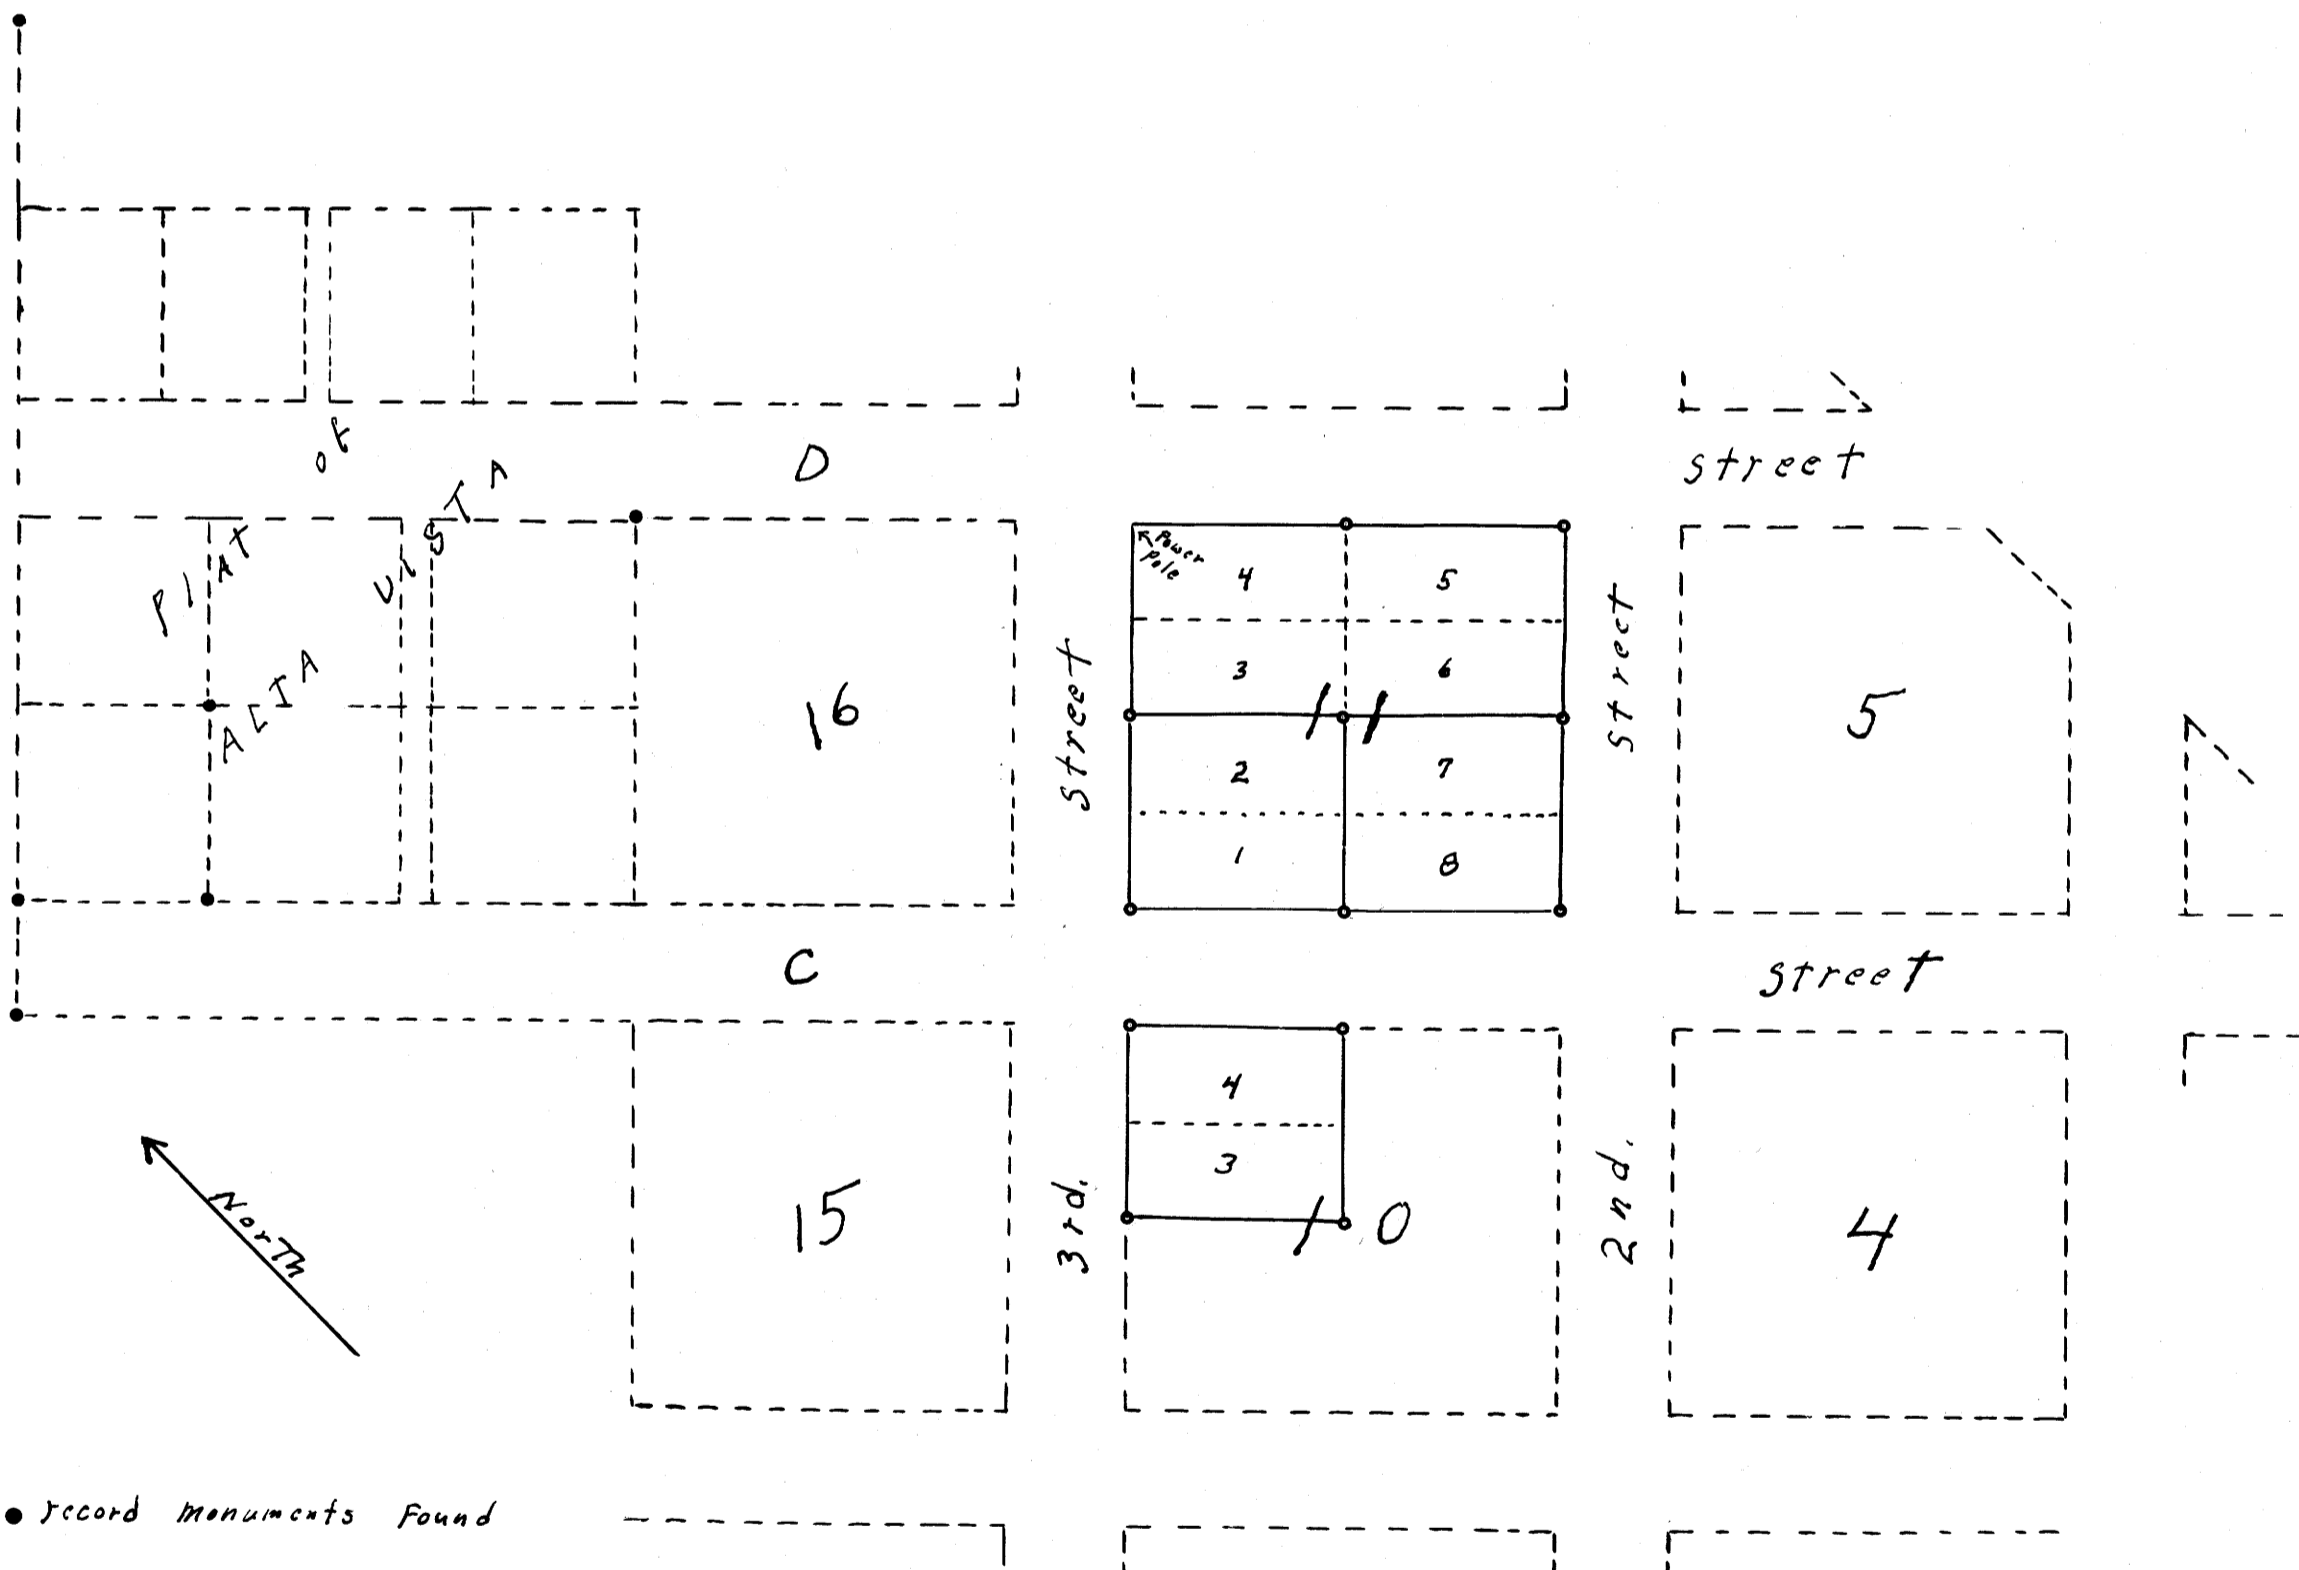

- Record Monuments Found
- Set 5/8 steel Rods This Survey

For
 Mrs. Stewart
 Bill Miller
 J. O. Haines

REGISTERED
 OREGON
 LAND SURVEYOR

Wilford N. Haines

MAY 7, 1948
 WILFORD N. HAINES
 239