


COUNTY SURVEYORS FILE DATA
DO NOT REMOVE FROM OFFICE

SURVEY IN WATTS ACRES
SEC. 11, T28S, R6W, W.M.
SURVEYED FOR J. BAXTER DAVIS
BY DON E. GARRETT
DECEMBER, 1968

1" = 100'
• - SET 3/4" IRON RODS

REGISTERED
OREGON
LAND SURVEYOR
Don E. Garrett
JULY 14, 1961
DON E. GARRETT
544

LD

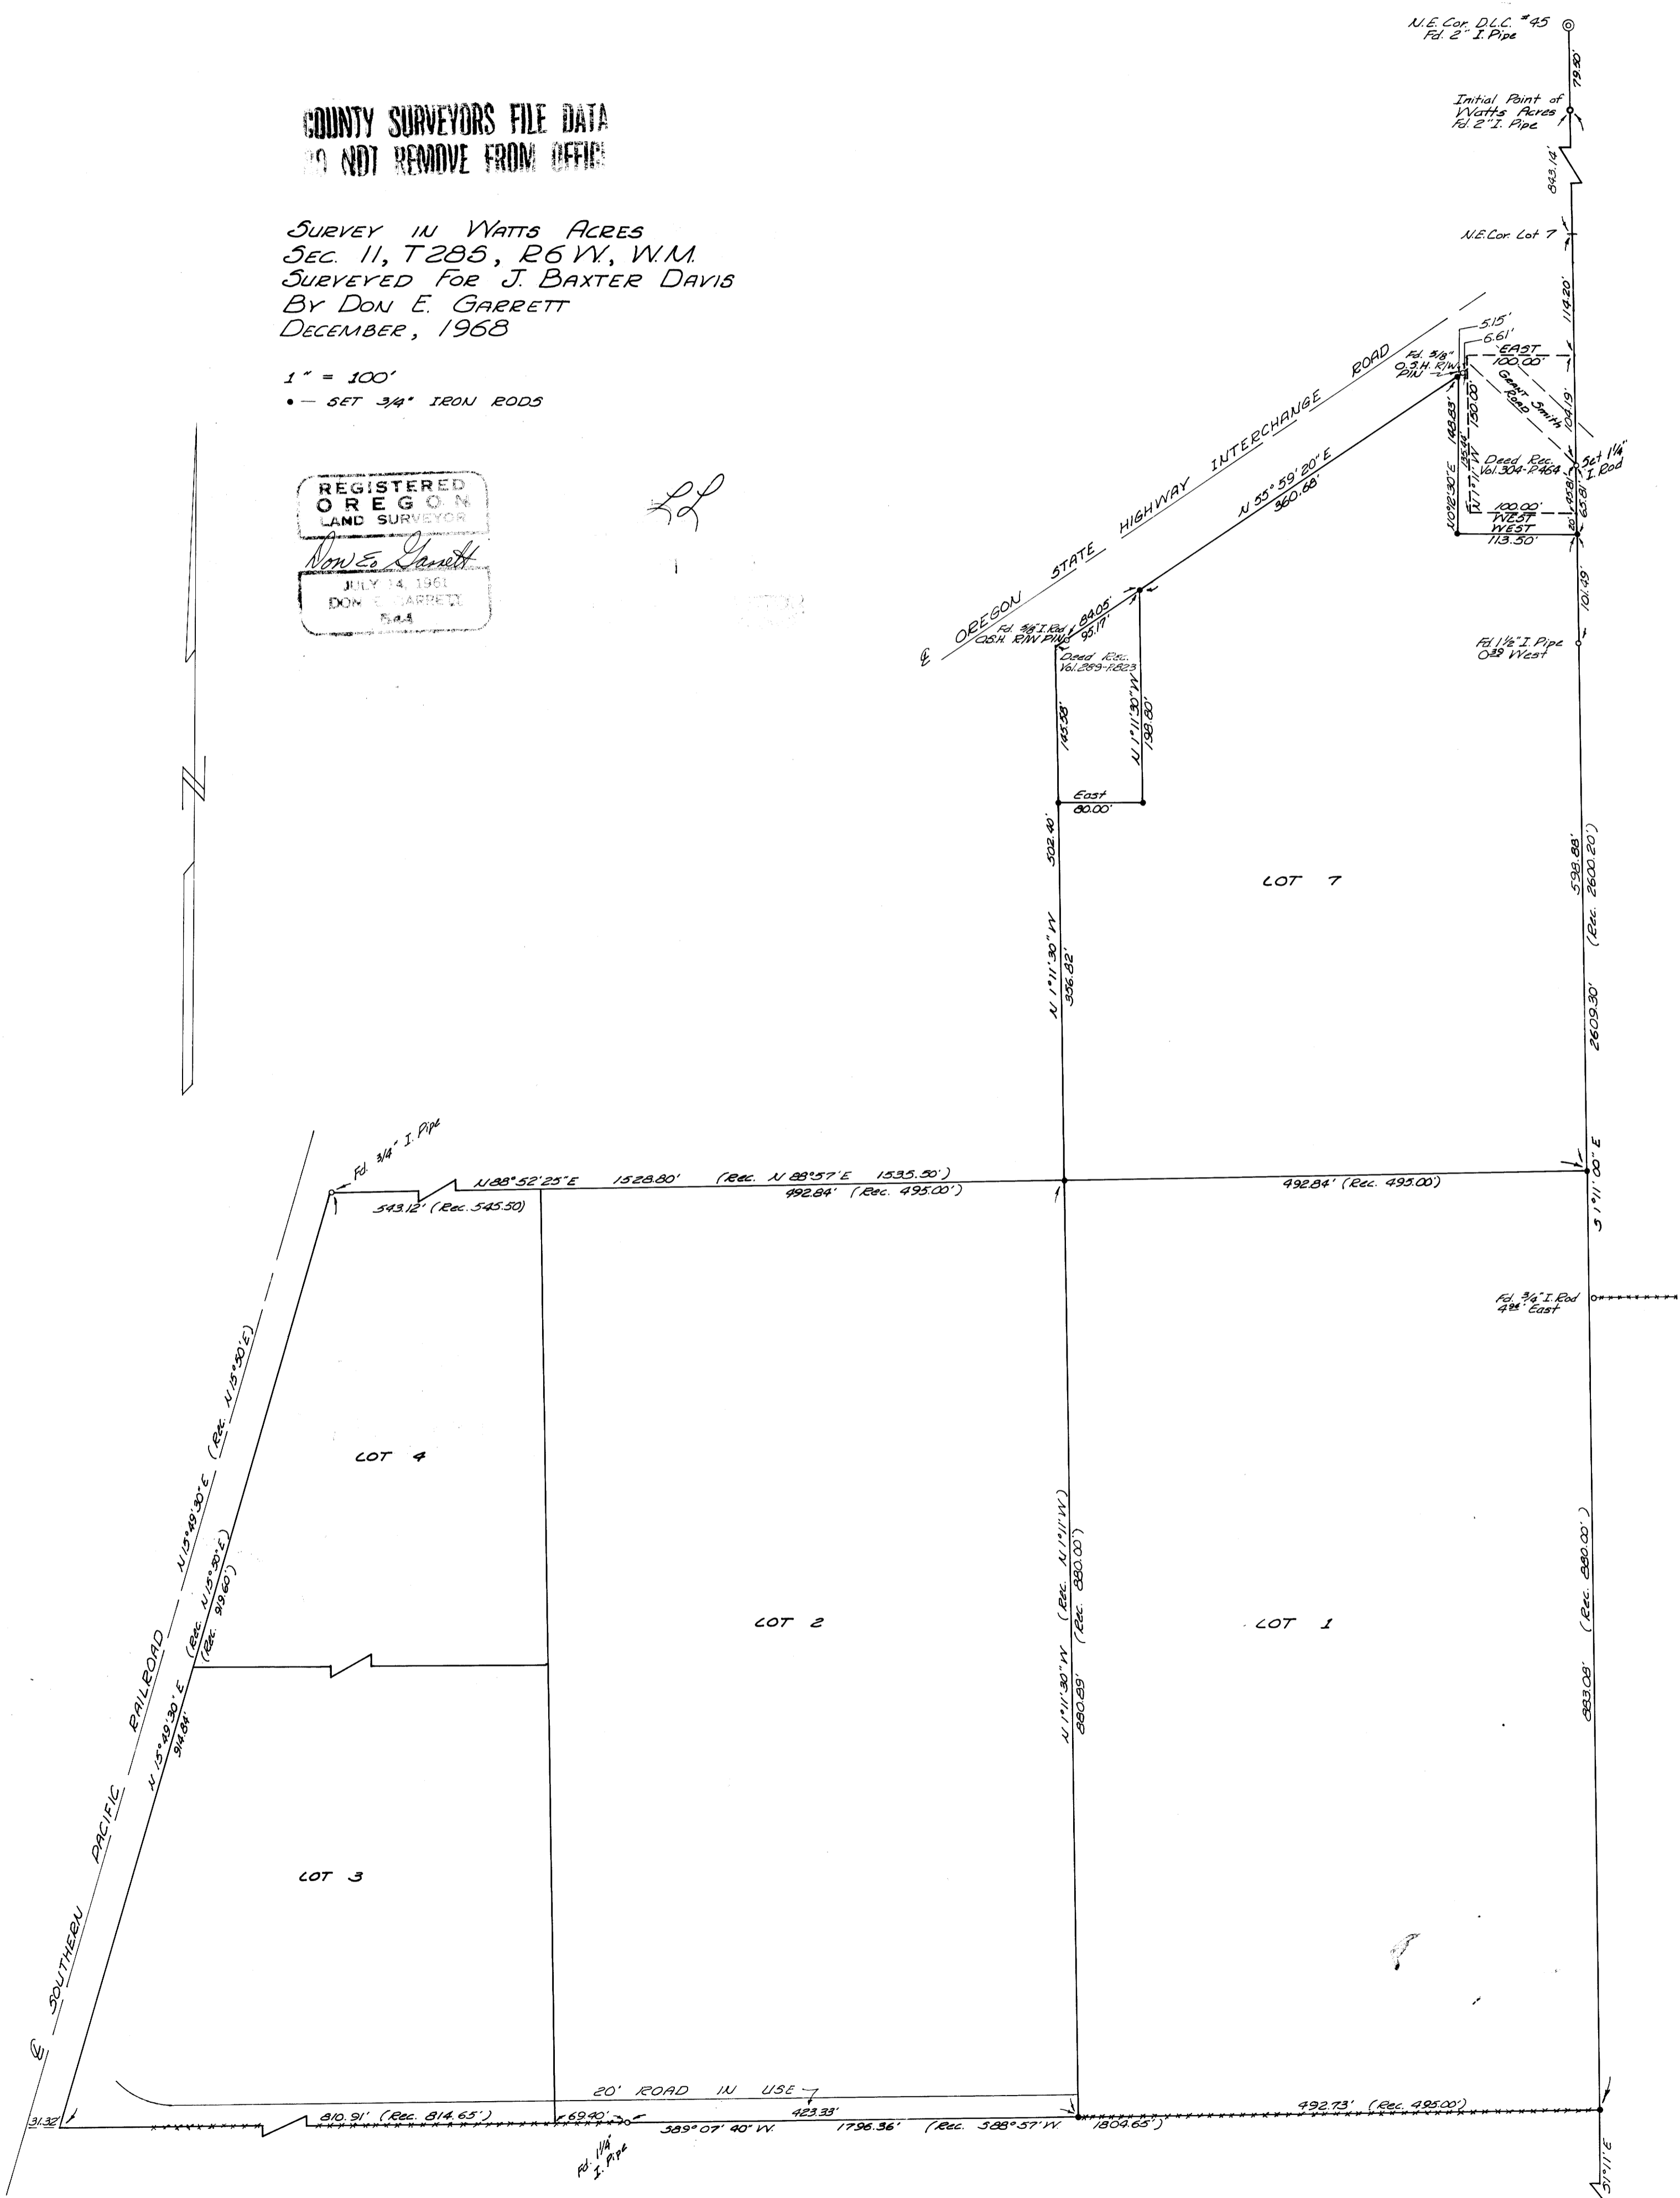

N.E. Cor. D.L.C. #45
Fd. 2" I. Pipe

Initial Point of
Watts Acres
Fd. 2" I. Pipe

N.E. Cor. Lot 7

5.15'
6.61'
EAST
100.00'
SOUTH
100.00'
WEST
113.50'

Deed Rec.
Vol. 304-P-464
1777

100.00'
WEST
113.50'

101.49'

101.49'

Fd. 1/2" I. Pipe
0.25 West

101.49'

101.49'

101.49'

538.88'
(Rec. 2600.20')

2609.30'

538.88'

538.88'

Fd. Brass Cap
Marked
S.W. Cor. D.L.C. #23
T28S, R6W