


NOT REMOVE FROM OFFICE

SEC. & 1/4 COR. RESTORATION & SUB. OF THE N.W. 1/4 OF SEC. 15, T. 24S. R. 9W. W.M.

SURVEYED FOR THE UMPQUA NATIONAL FOREST
GLIDE RANGER DISTRICT PROJECT 902 031.01.04 0053
BY BAUGHMAN & ACKARET INC. MARCH 1969
SCALE 1"=400'

REGISTERED
OREGON
LAND SURVEYOR
Glenn S. Baughman
JULY 14, 1965
GLENN S. BAUGHMAN
536

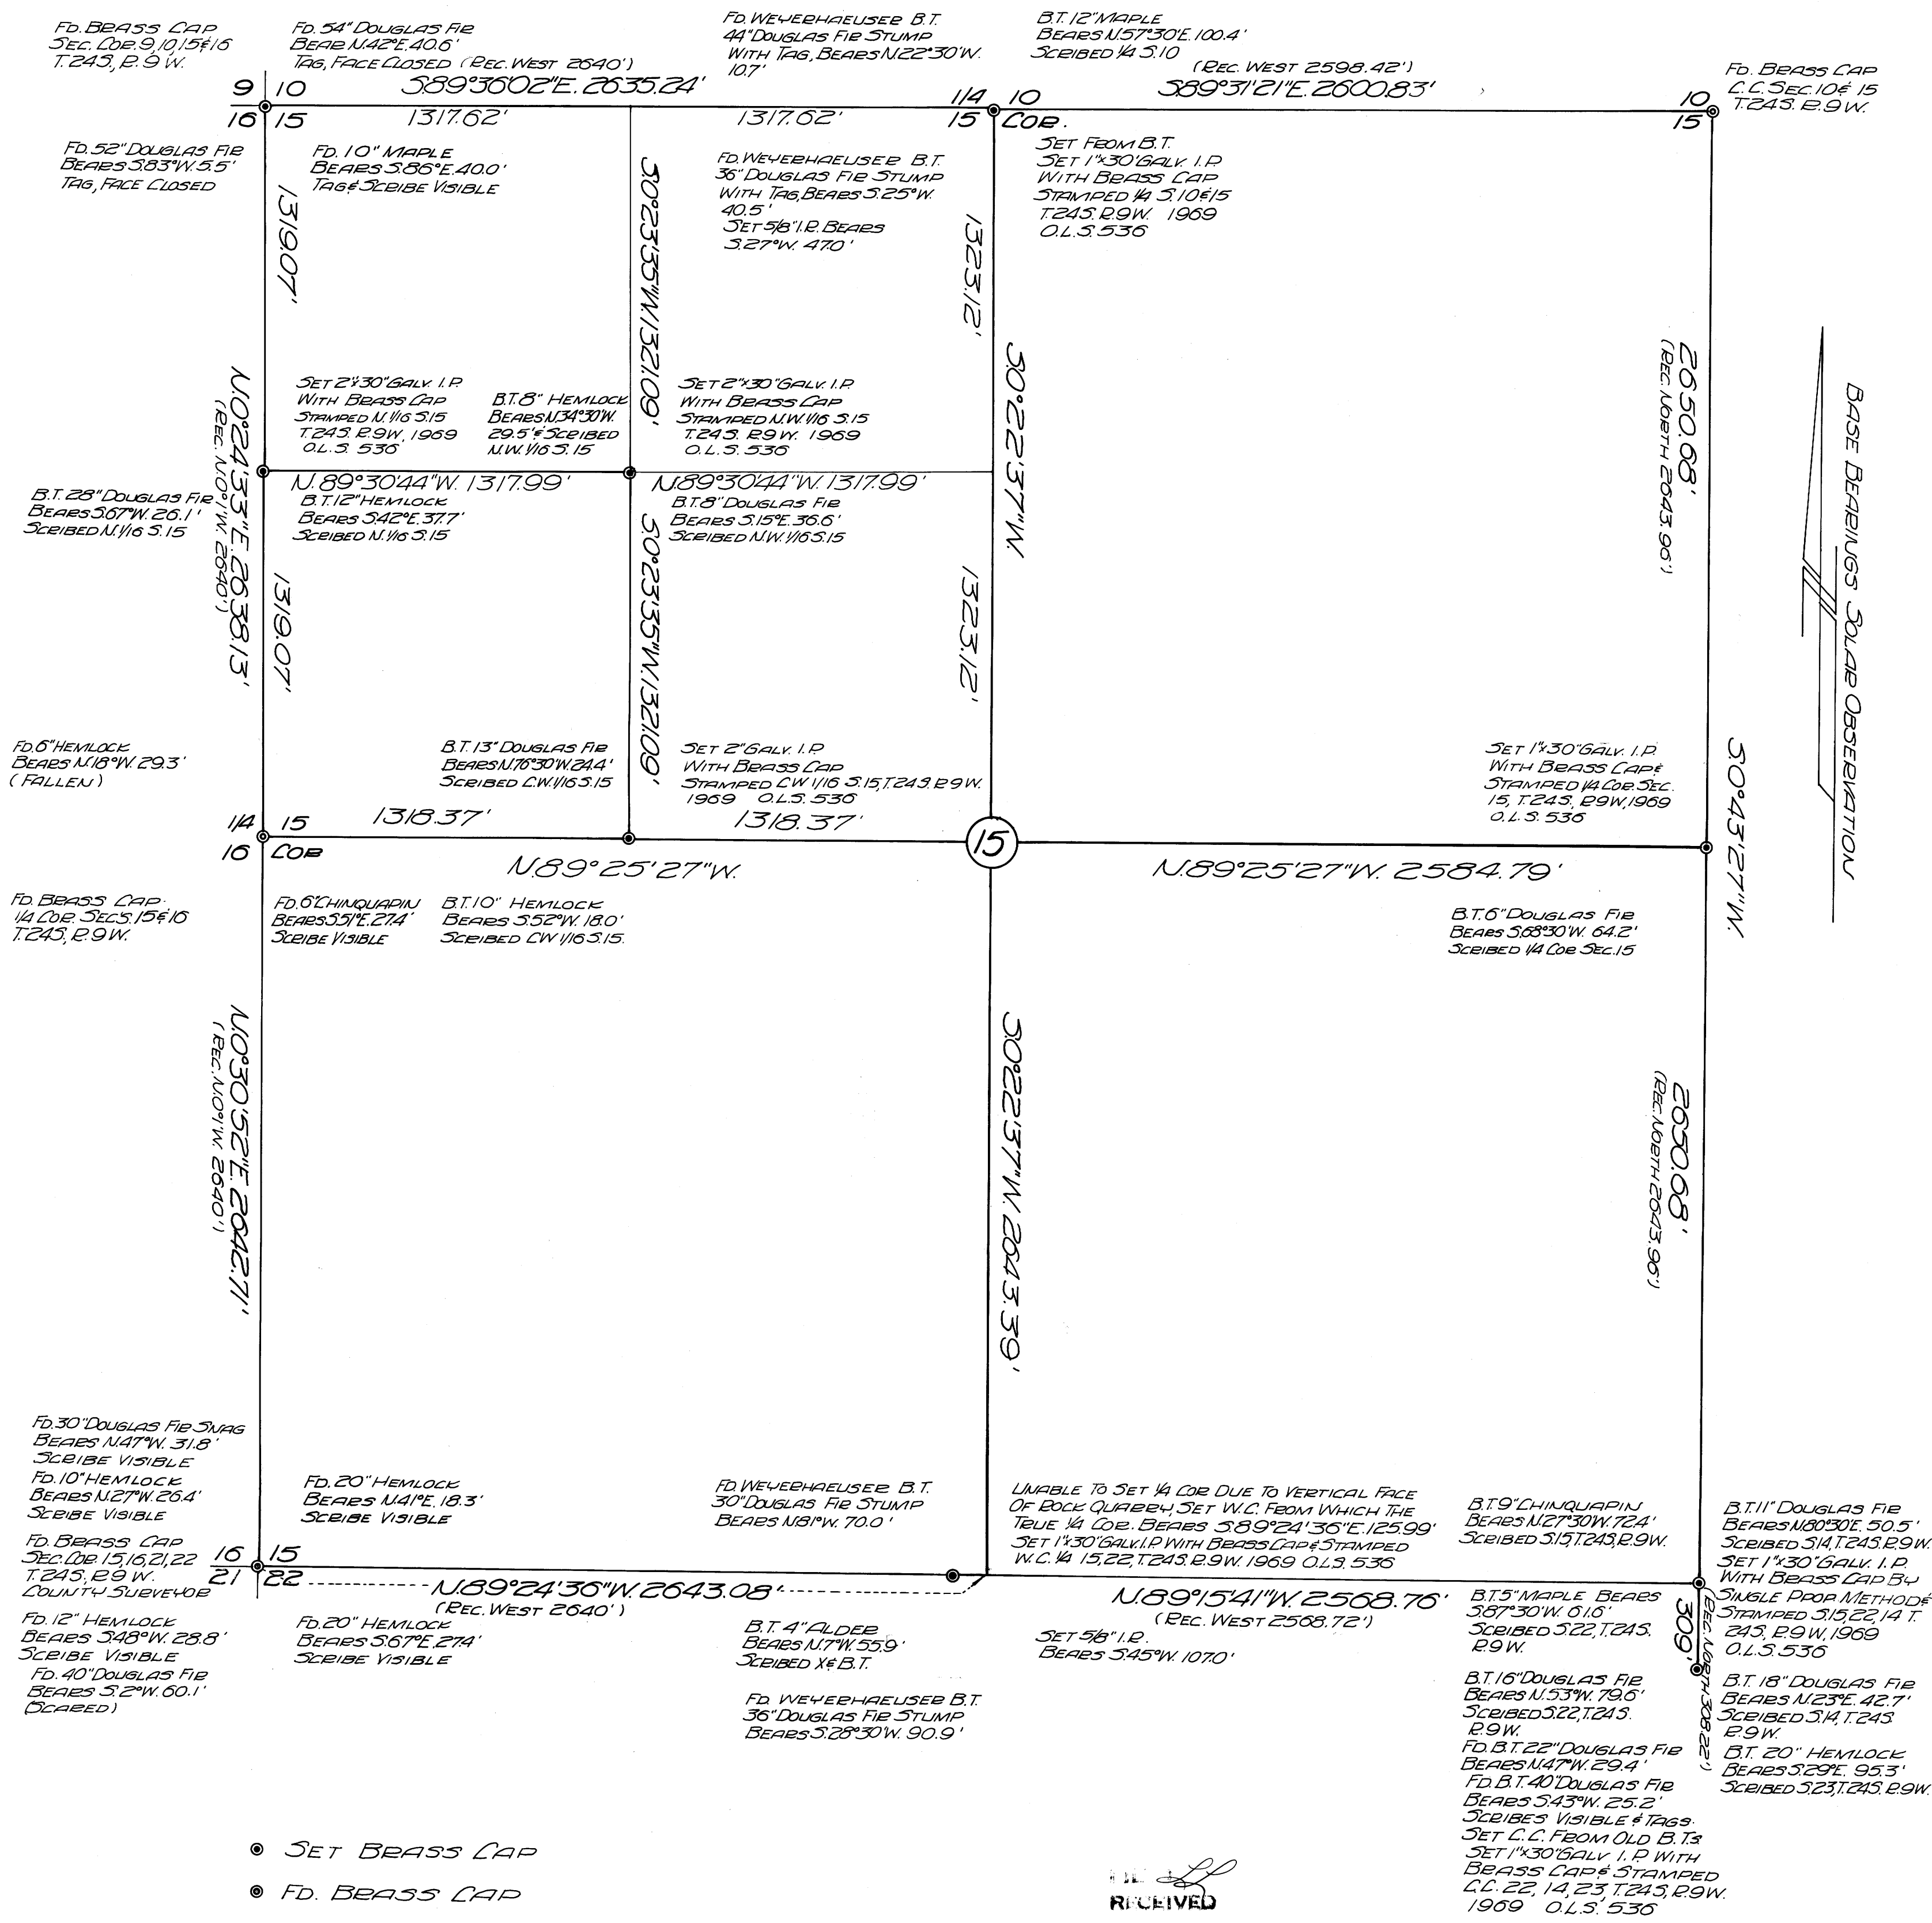

BASE BEARINGS SOLAR OBSERVATION

- SET BRASS CAP
- F.D. BRASS CAP

RECEIVED

APR 3 1969

COUNTY SURVEYOR
DOUGLAS COUNTY, ORE.


C.S. File 55/112

Map File M.37+42

CERTIFIED RECORD OF LAND CORNER MONUMENTATION

History of original corner establishment:

None

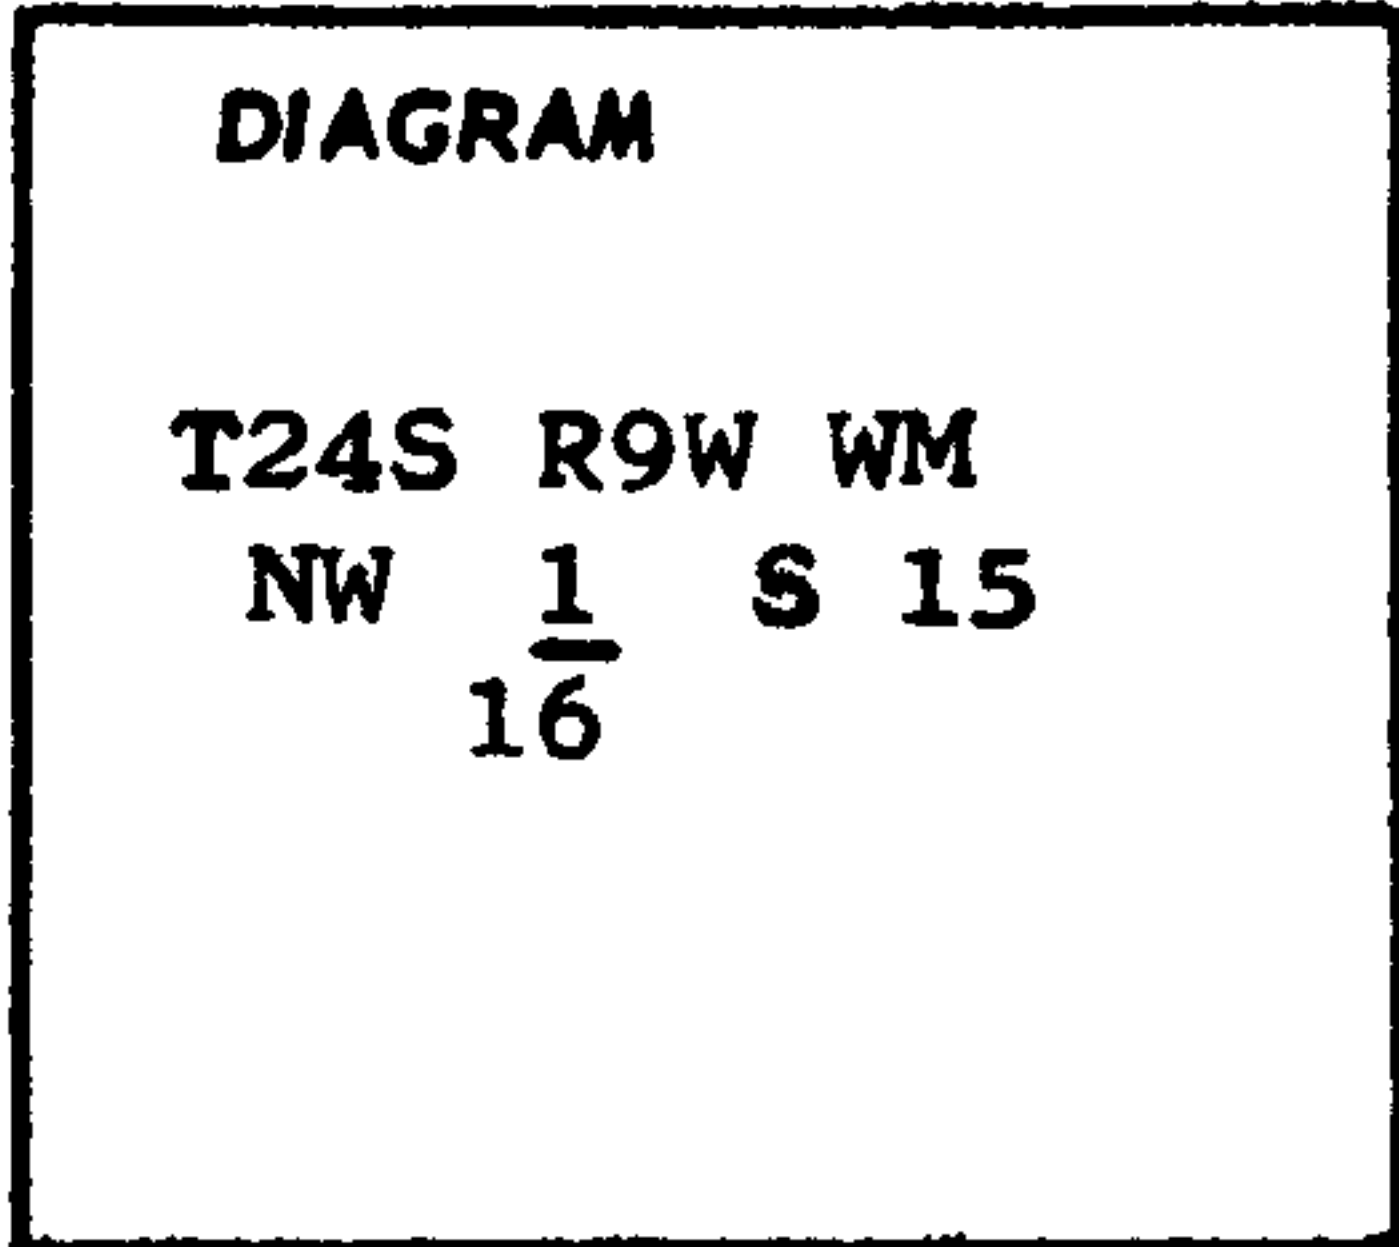

Description of corner evidence found:

None

REGISTERED
OREGON
LAND SURVEYOR

Glenn S. Baughman

JULY 14, 1961
GLENN S. BAUGHMAN
536

Description of monument and accessories I established to perpetuate the original location of this corner

I set a 2" by 30" galvanized iron pipe, with brass cap, 26" in the ground.

I stamped the cap

T24S R9W WM
NW $\frac{1}{16}$ S 15
1969
OLS 536

From the iron monument I marked

A 8" Hemlock NW 1/16 S 15 BT which bears N 34 1/2° W 29.5 FT.

A 8" Douglas Fir NW 1/16 S 15 BT which bears S 15° E 36.6 FT.

I set bearing tree tags on all bearing trees facing the monument.

Office of..... SURVEYOR..... County of..... DOUGLAS.....

State of..... OREGON....., I hereby certify that the within instrument was filed in this office for record on the ...4... day of ...April....., 1969, at 9:30 clock a.m., (signed)


James A. Ryan
(COUNTY OFFICIAL)

by..... (DEPUTY)

CERTIFIED RECORD OF LAND CORNER MONUMENTATION

History of original corner establishment:

None

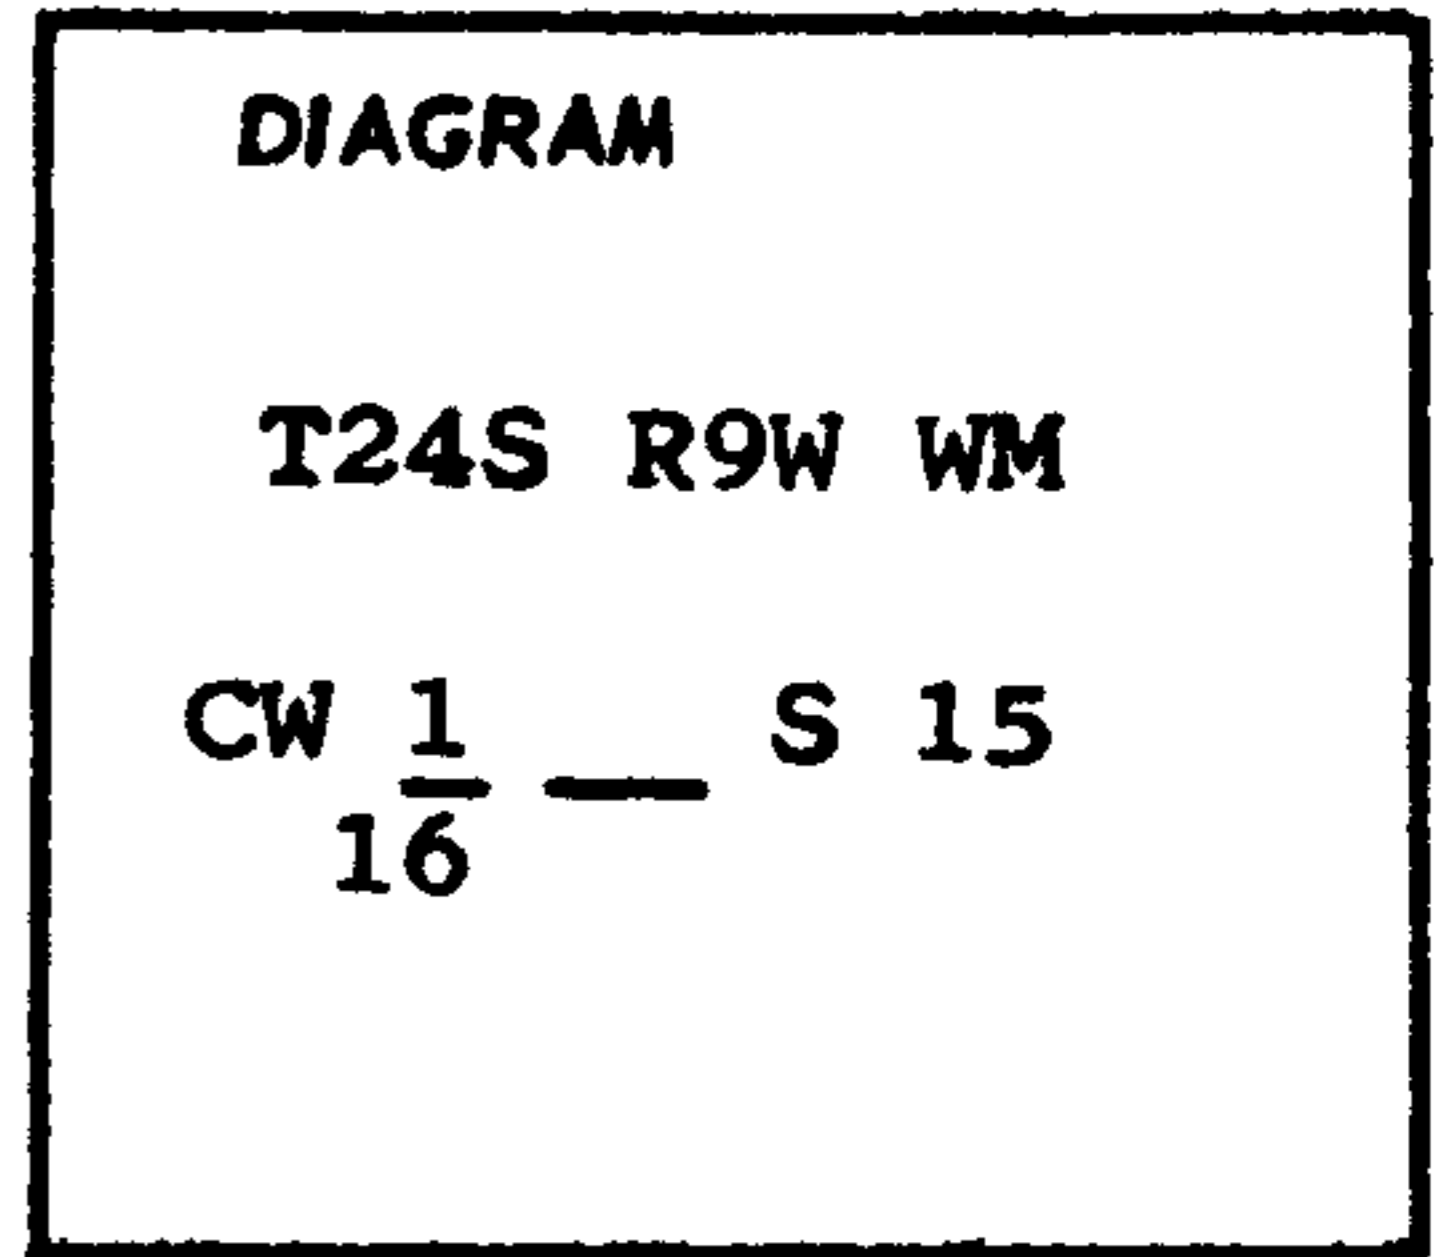

Description of corner evidence found:

None


REGISTERED
OREGON
LAND SURVEYOR

Glenn S. Baughman
JULY 14, 1961
GLENN S. BAUGHMAN
536

Description of monument and accessories I established to perpetuate the original location of this corner

I set a 2" by 30" galvanized iron pipe, with brass cap, 26" in the ground.

I stamped the cap

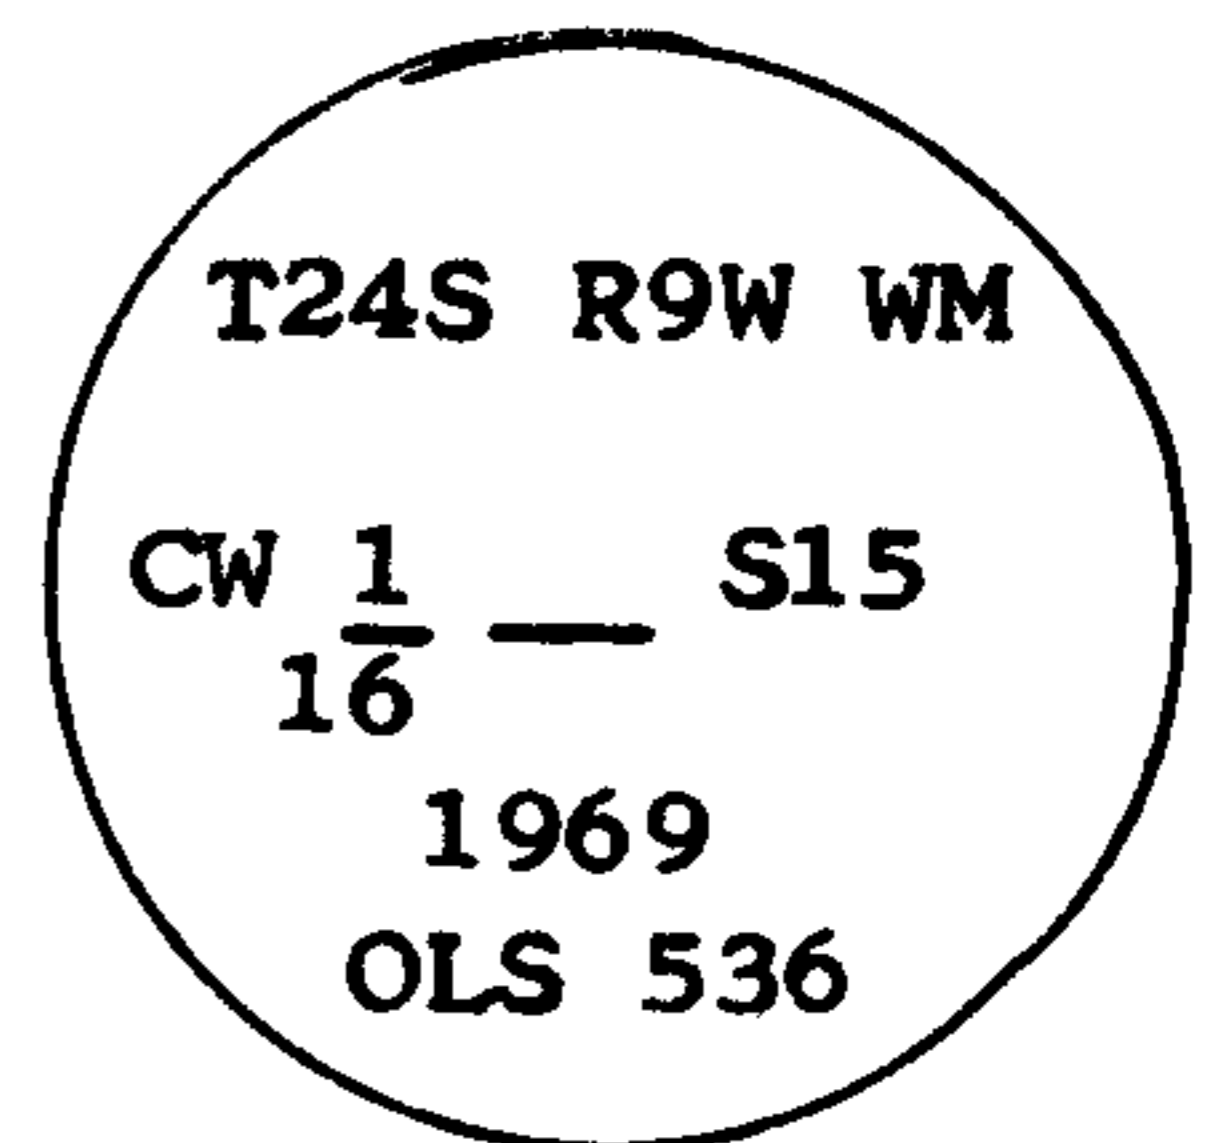

From the iron pipe monument I marked

A 13" Douglas Fir CW 1/16 S 15 BT which bears N 76 1/2° W 24.4 FT.

A 10" Hemlock CW 1/16 S 15 BT which bears S 52°W 18.0 FT.

I set bearing tree tags on all bearing trees and facing the monument.


Office of.....SURVEYOR..... County of.....DOUGLAS.....
 State of.....OREGON....., I hereby certify that the within instrument was filed in this office
 for record on the ..4... day of.....April....., 19 69, at 9:30 o'clock^a.....m., (signed)

James W. Ryan by
 (COUNTY OFFICIAL) (DEPUTY)

CERTIFIED RECORD OF LAND CORNER MONUMENTATION


History of original corner establishment:

None

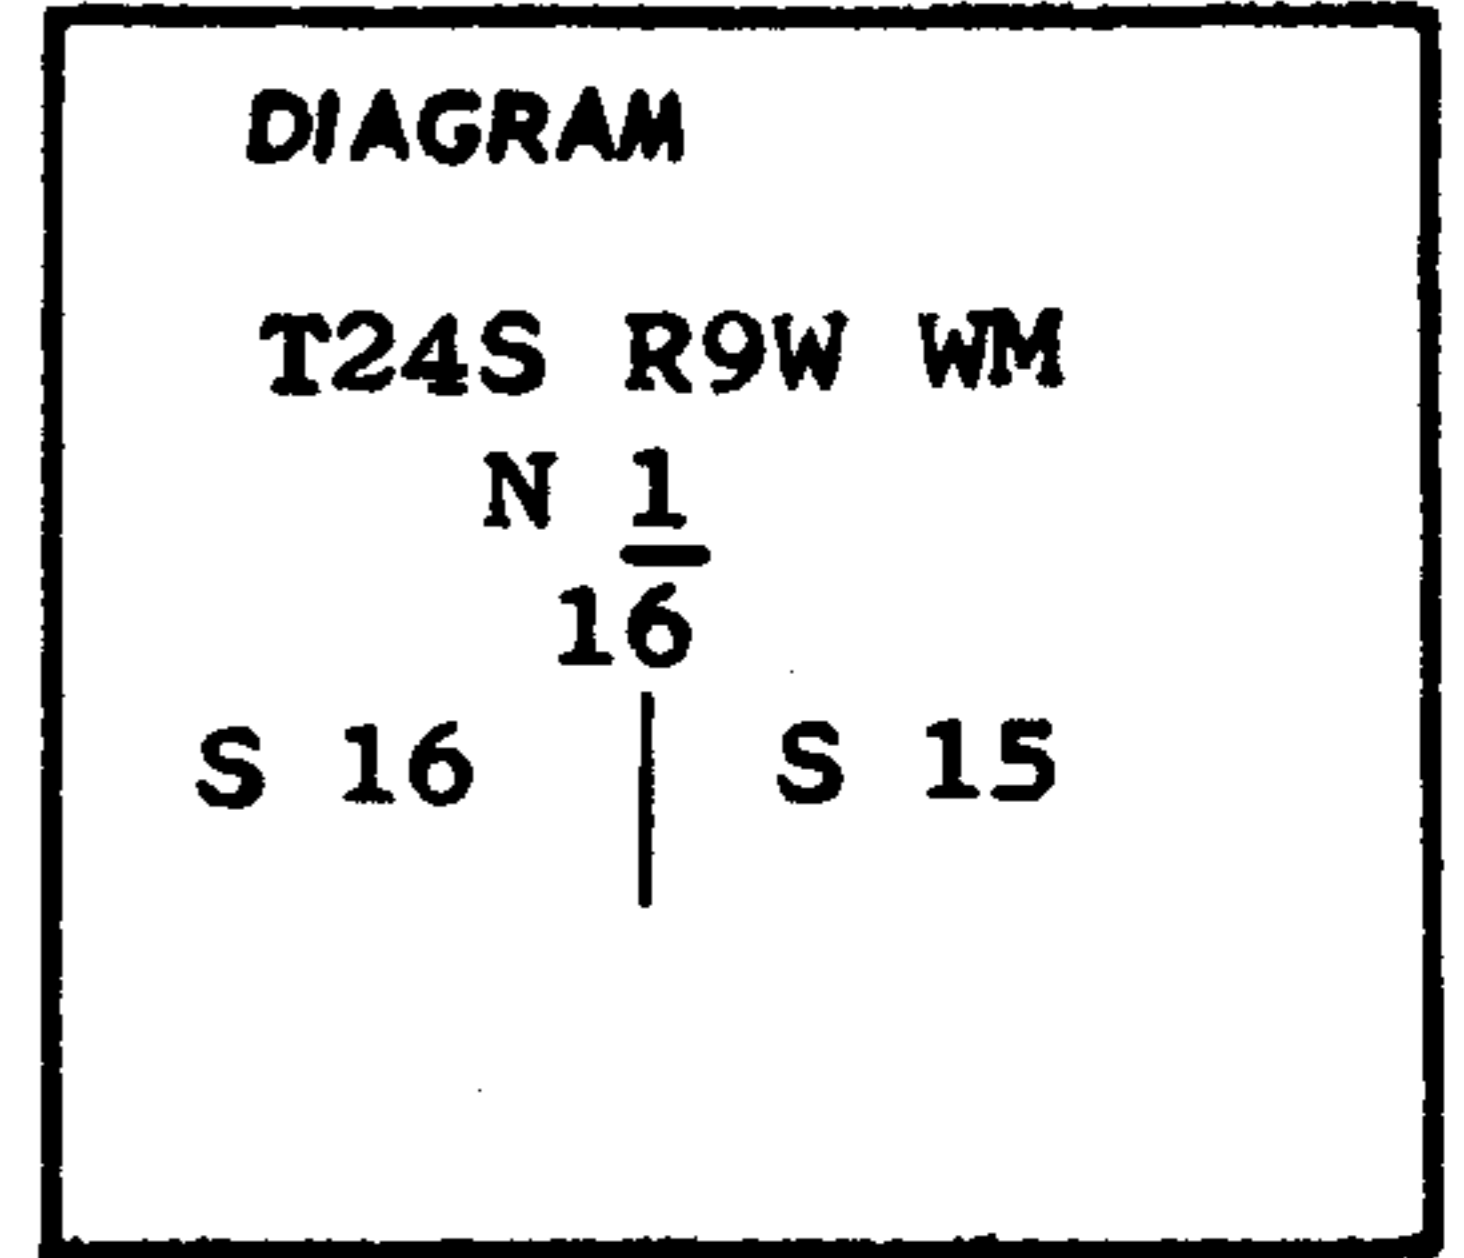

Description of corner evidence found:


None

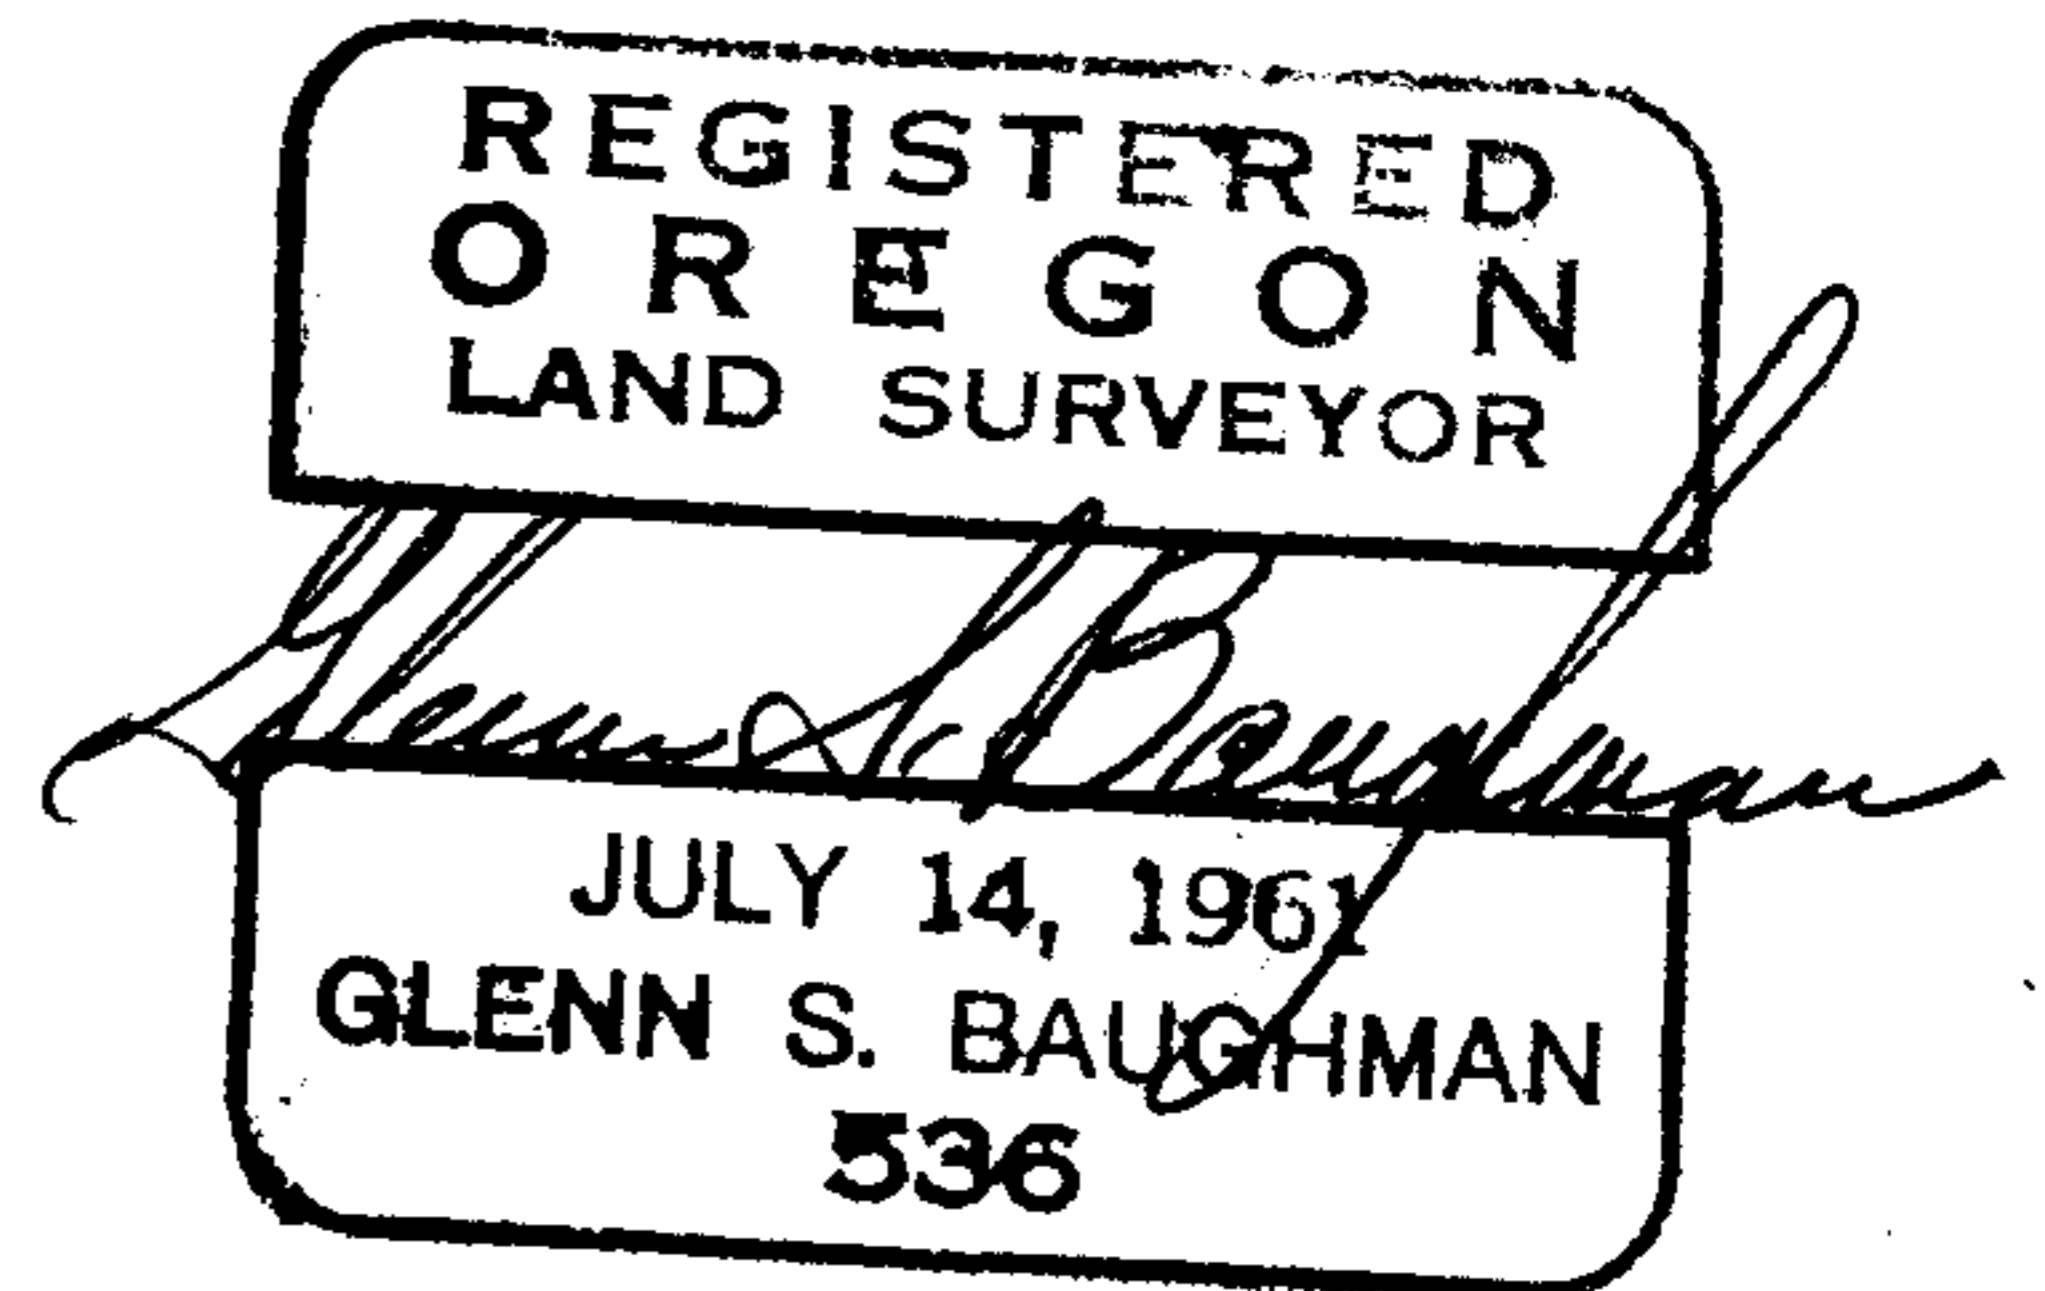

Description of monument and accessories I established to perpetuate the original location of this corner

I set a 2" by 30" galvanized iron pipe, with brass cap, 26" in the ground.

I stamped the cap

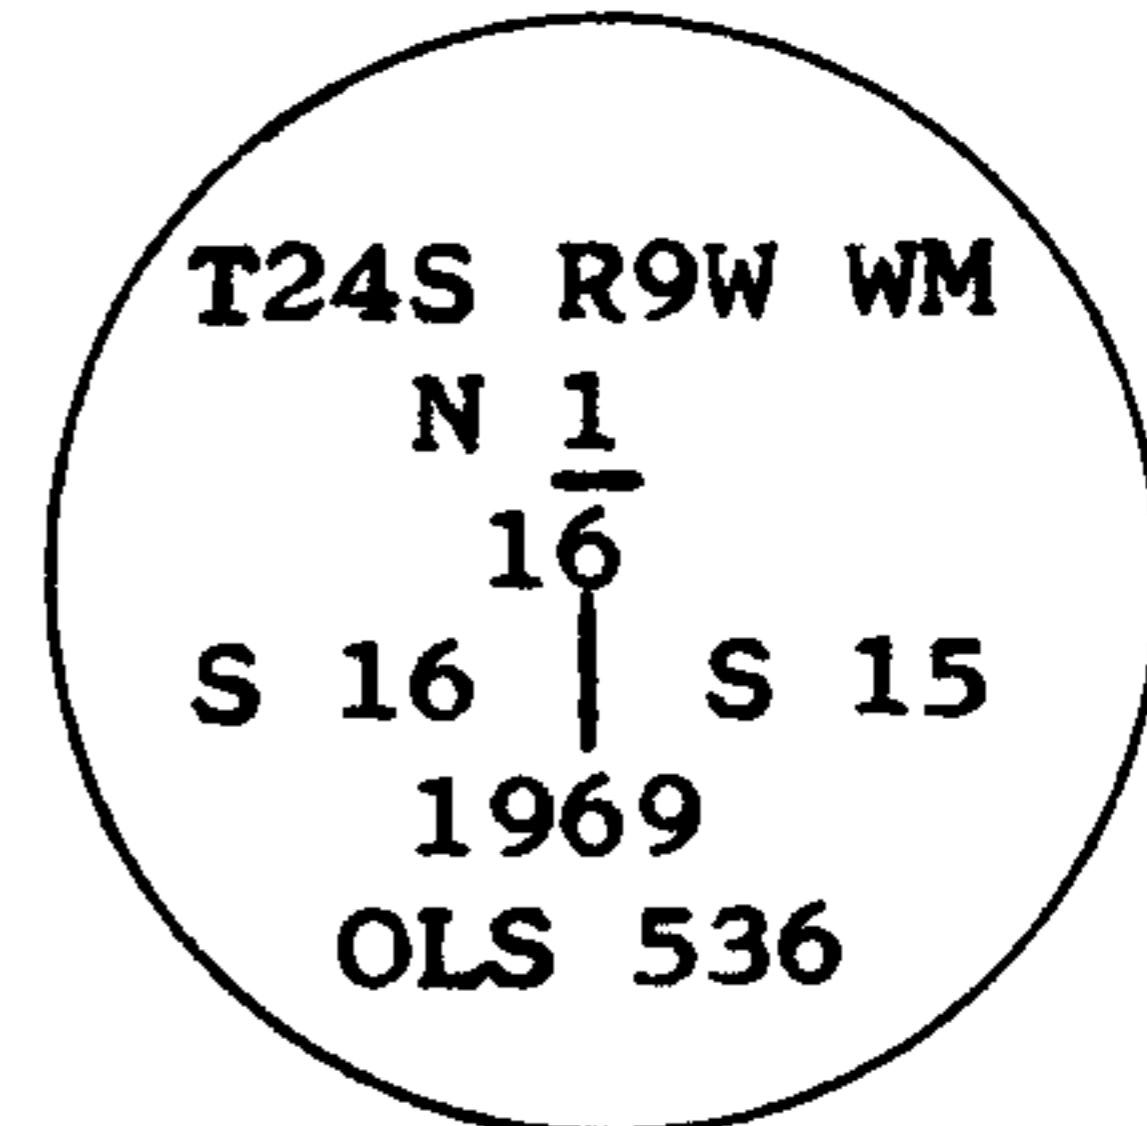

From the iron monument I marked

A 12" Hemlock N 1/16 S 15 BT which bears S 42° E 37.7 FT.

A 28" Douglas Fir N 1/16 S 16 BT which bears S 67° W 26.1 FT.

I set bearing tree tags on all bearing trees facing the monument.


Office of..... SURVEYOR..... County of..... DOUGLAS.....
 State of..... OREGON....., I hereby certify that the within instrument was filed in this office
 for record on the ...4... day of..... April.....; 19...69..., at...9:30... o'clock A....m., (signed)

James W. Ryan..... by.....
 (COUNTY OFFICIAL)..... (DEPUTY)

CERTIFIED RECORD OF LAND CORNER MONUMENTATION

History of original corner establishment:

As surveyed by Levi C. Walker 1905

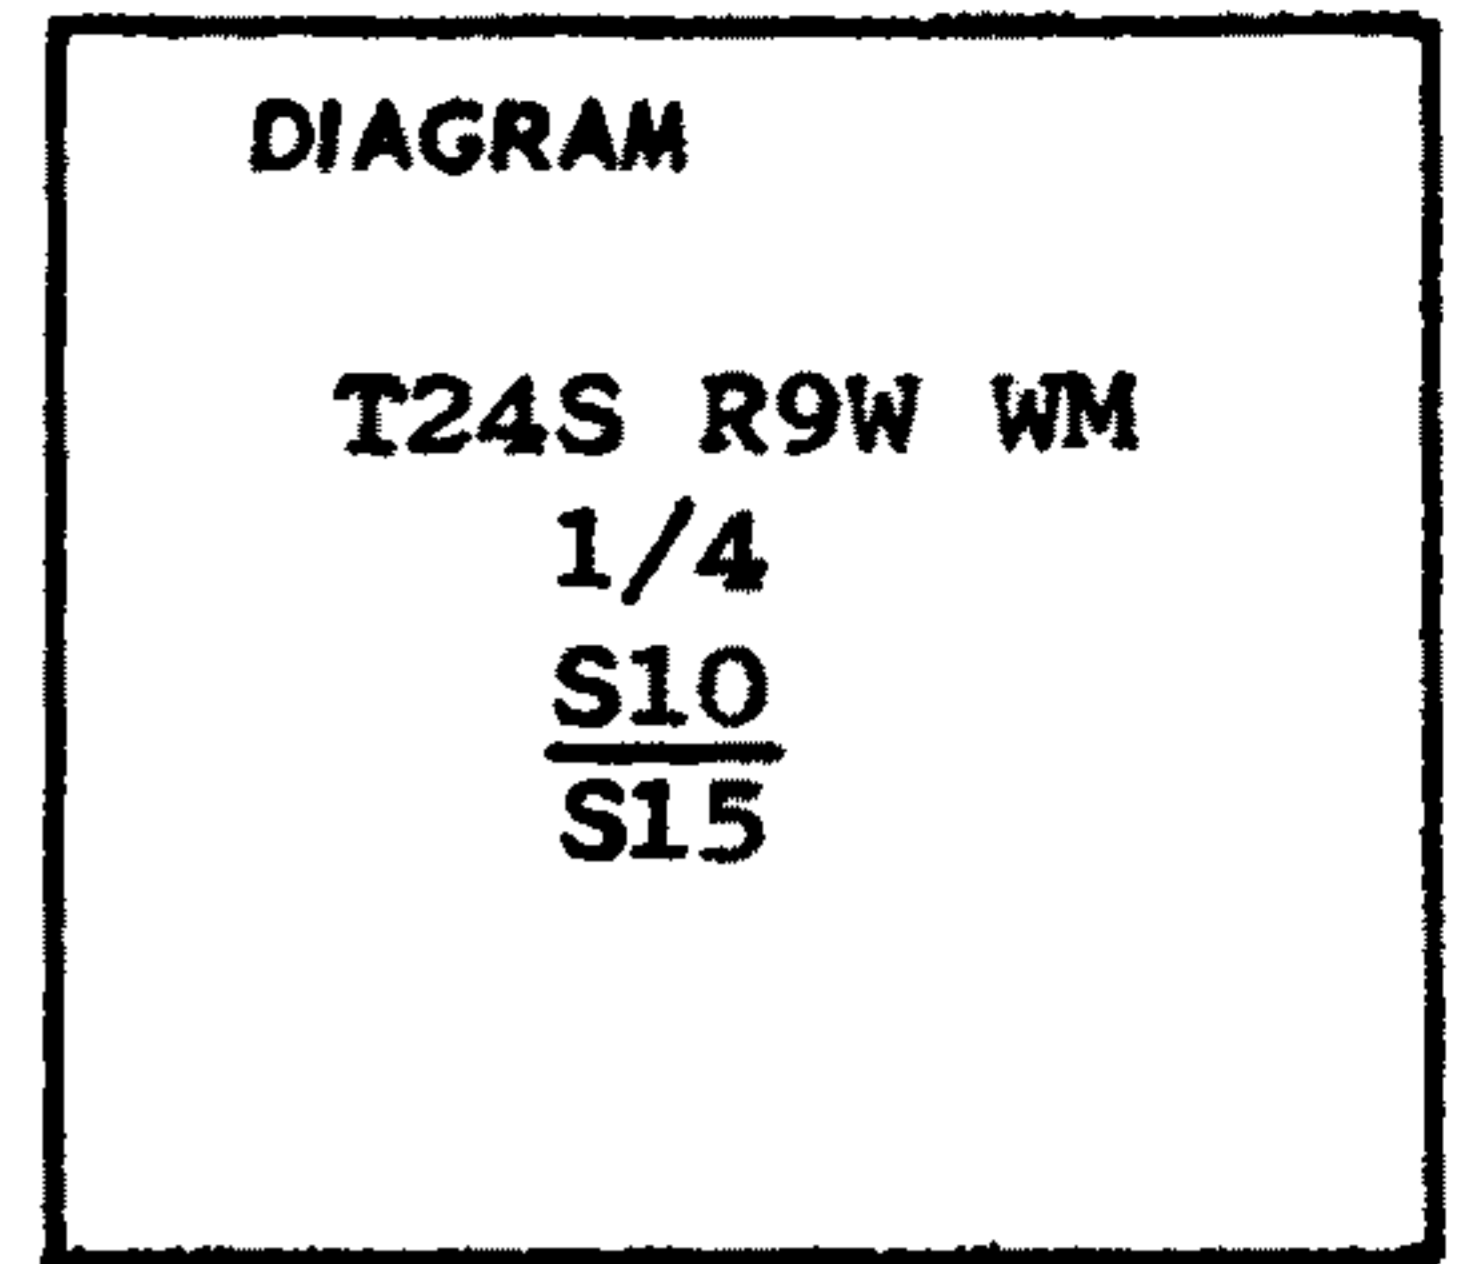


Description of corner evidence found:

I found two Weyerhaeuser reference trees.
 One is a 44" Douglas Fir stump with tag and a nail, also cruisers mark.
 The tag gives bearing and distance as N 22 1/2° W 10.7 FT.
 One is a 36" Douglas Fir stump with a tag and a nail. the tag gives bearing and distance as S 25° W 40.5 FT.


Description of monument and accessories I established to perpetuate the original location of this corner

I set a 1" by 30" galvanized iron pipe, with brass cap, 26" in the ground.


I stamped the cap

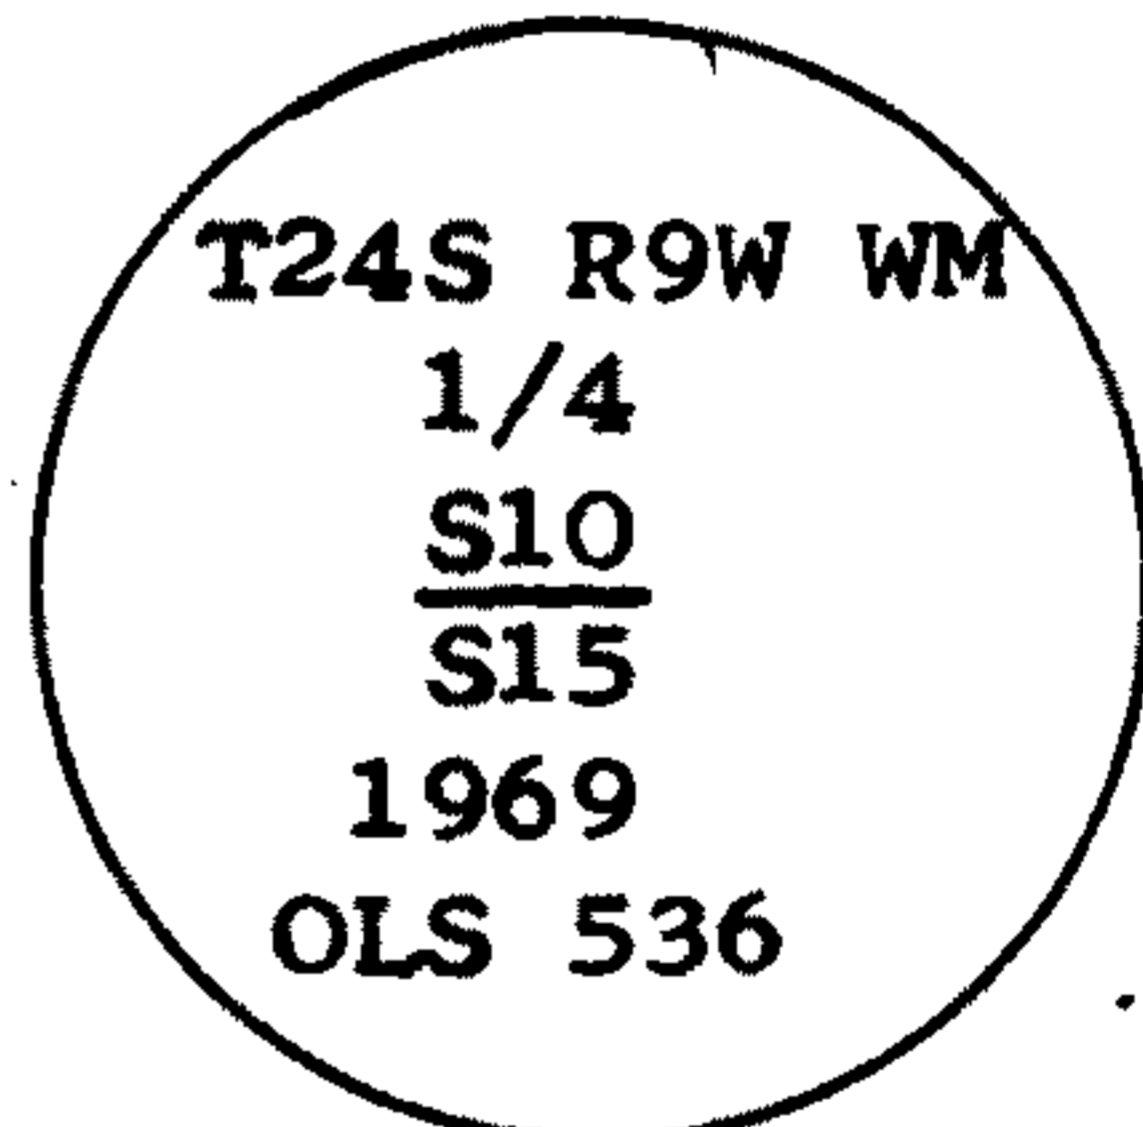

From the iron pipe monument I marked
 A 12" Maple 1/4 S10 BT which bears N 57 1/2° E 100.4 FT.
 I also set a 5/8" by 30" iron rod 26" in the ground which bears S27°W 47.0 FT

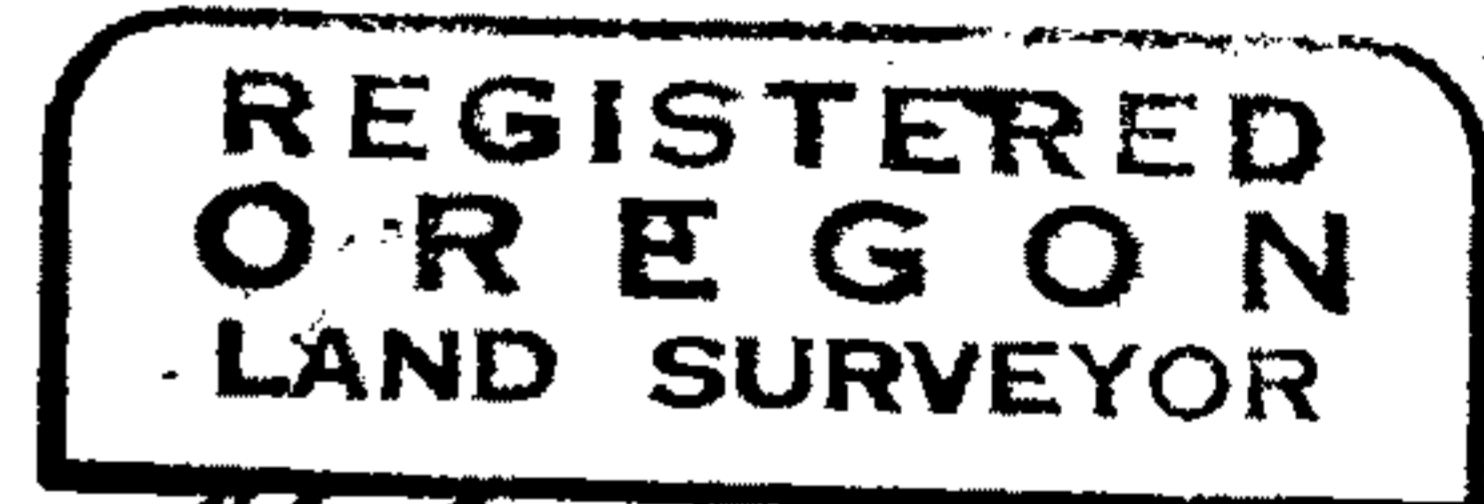

Glenn S. Baughman

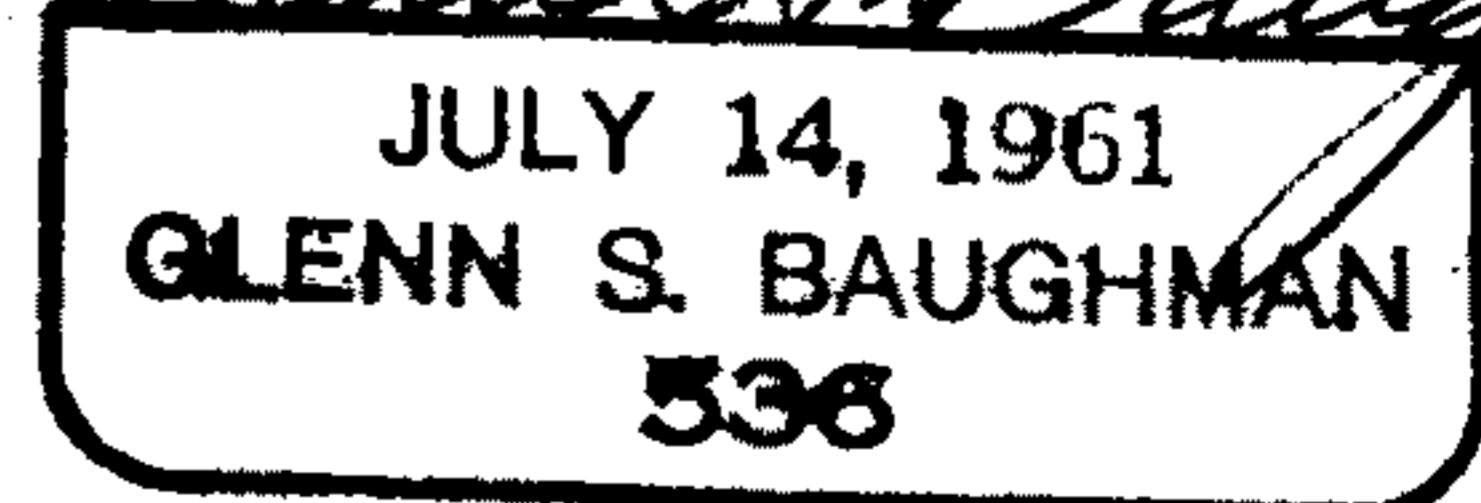


Office of.....SURVEYOR..... County of.....DOUGLAS.....
 State of.....OREGON....., I hereby certify that the within instrument was filed in this office
 for record on the ...4... day ofApril....., 19...69, at 9:30' clock a.m., (signed)
James W. Ryan by (COUNTY OFFICIAL) (DEPUTY)

#8

CORNER ESTABLISHMENT CERTIFICATION

I Henry R. Reppeto do hereby certify that the original corner (see diagram) was referenced under my direction. The corner that was re-established by Baughman and Ackaret occupies the same point as nearly as possible.

DIAGRAM T.24S., R.9W.W.M.

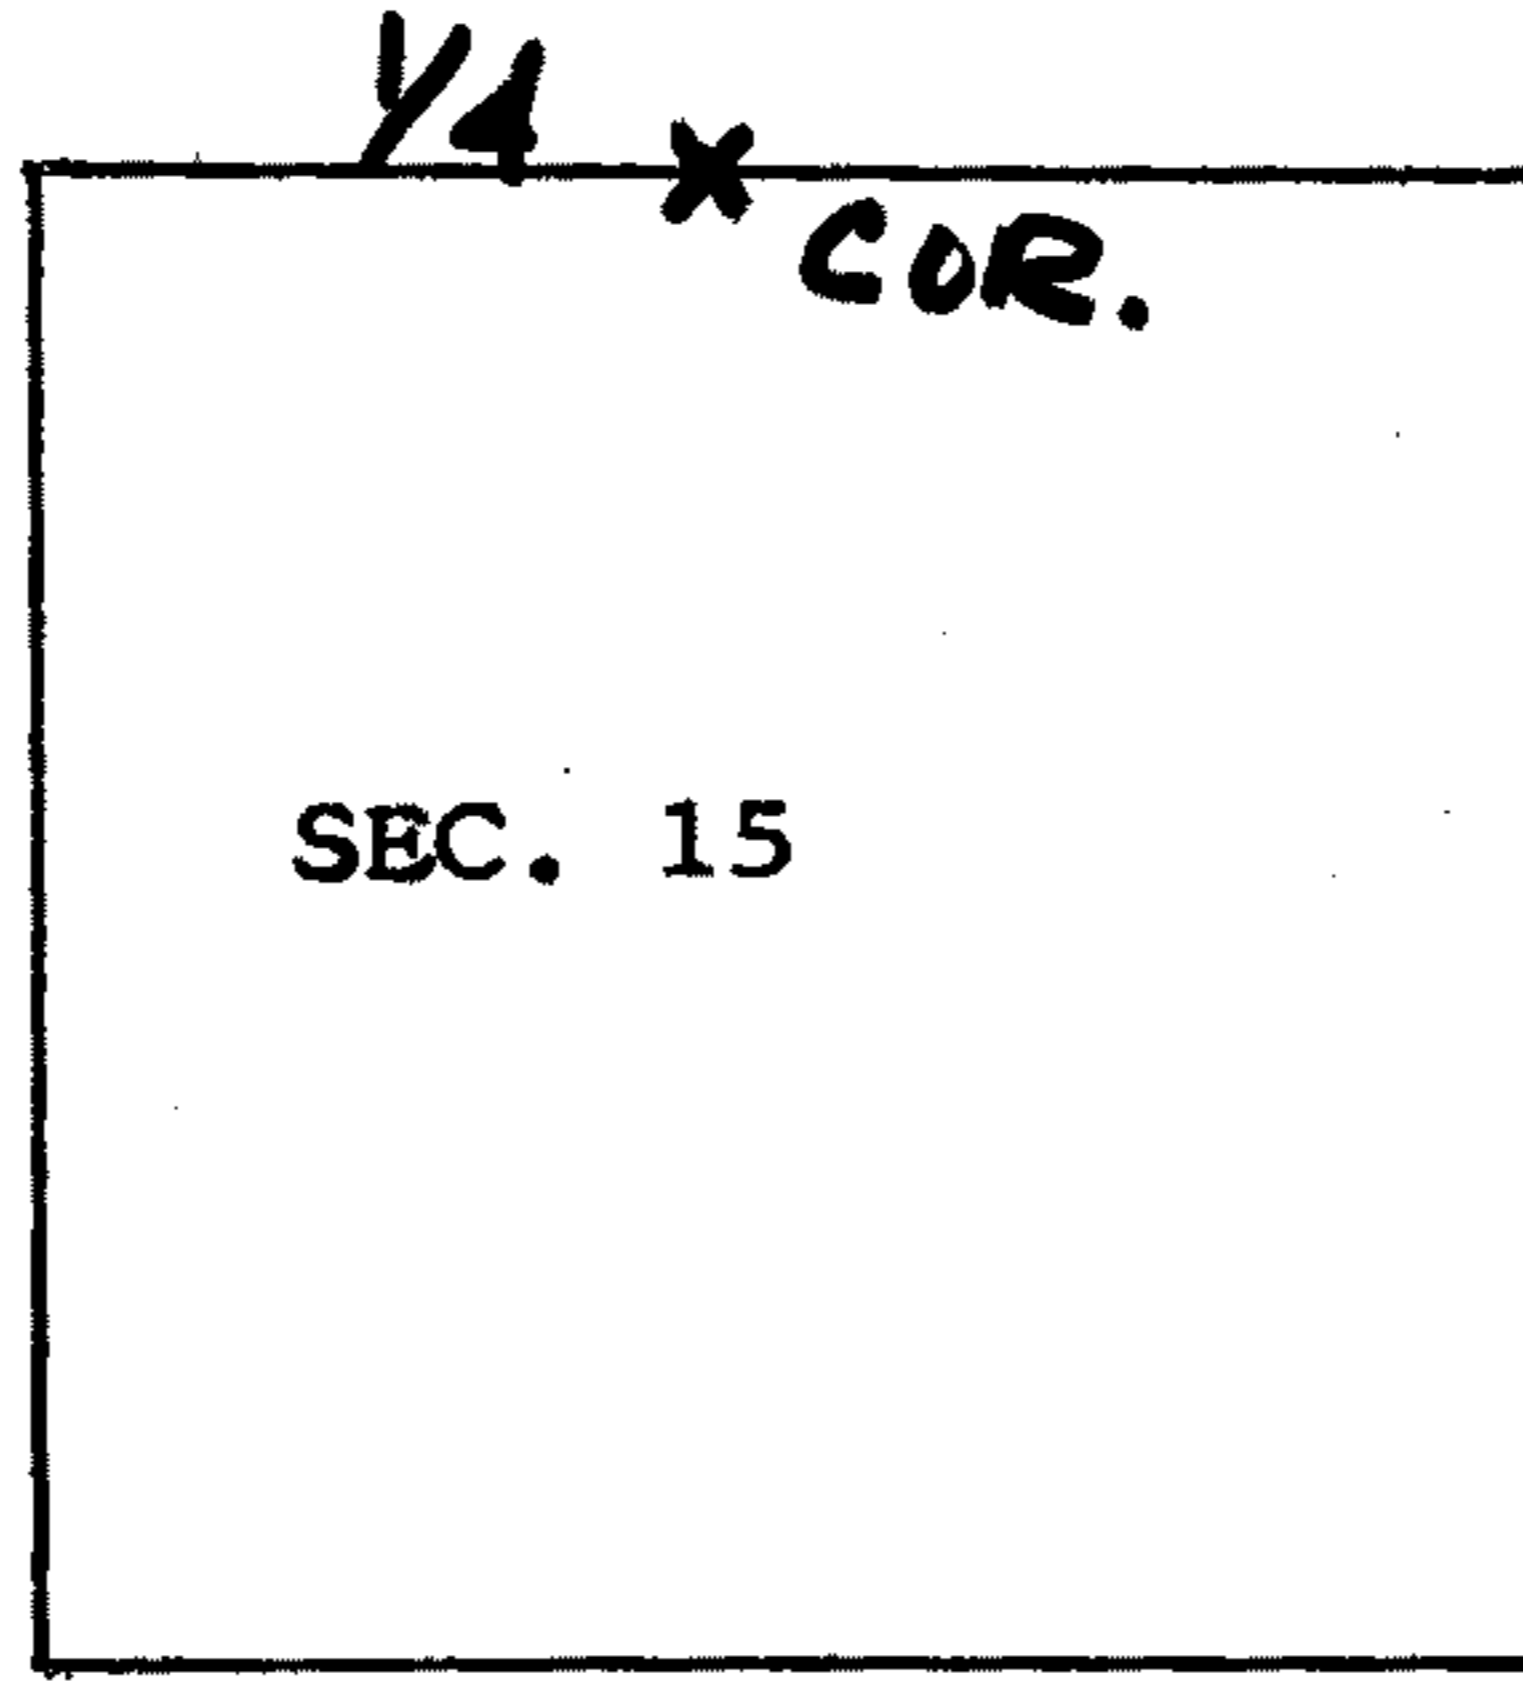

Henry R. Reppeto
Registered Land Surveyor No. 618

4-15-69

FILED
RECEIVED


APR 18 1969

COUNTY SURVEYOR
DOUGLAS COUNTY, ORE.

CERTIFIED RECORD OF LAND CORNER MONUMENTATION

History of original corner establishment:

None

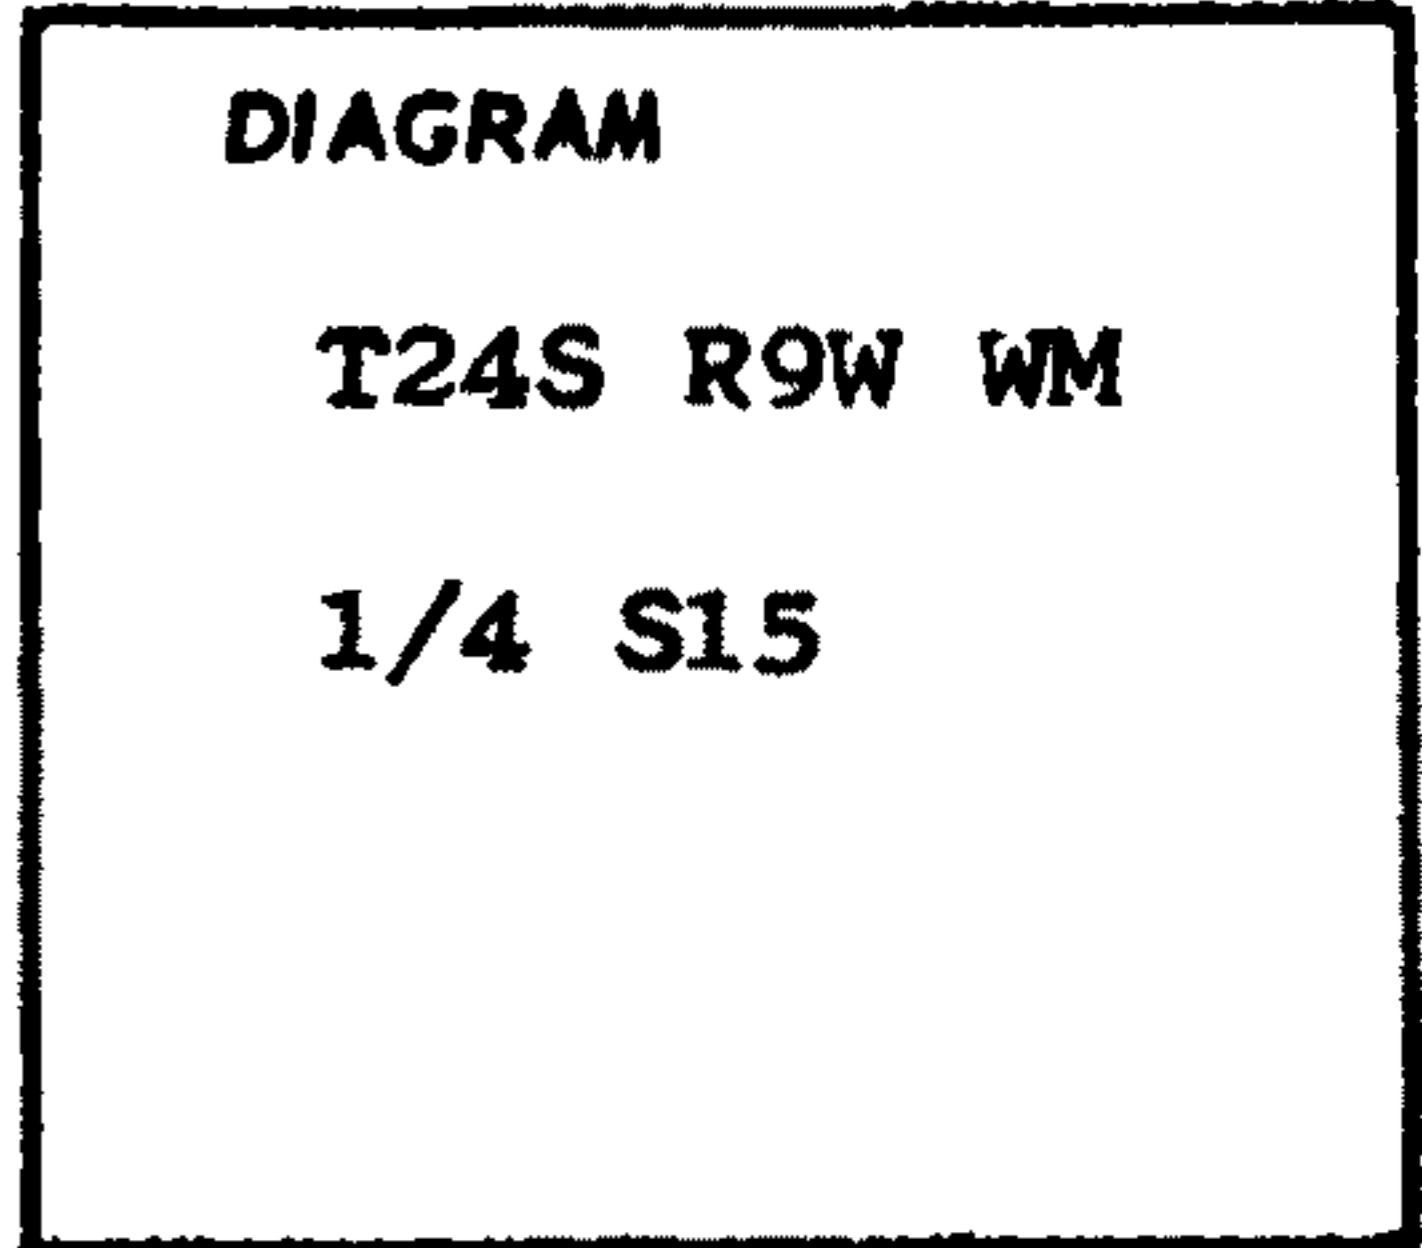


Description of corner evidence found:

None

Description of monument and accessories I established to perpetuate the original location of this corner

I set a 1" by 30" galvanized iron pipe, with brass cap, 26" in the ground.

I stamped the cap

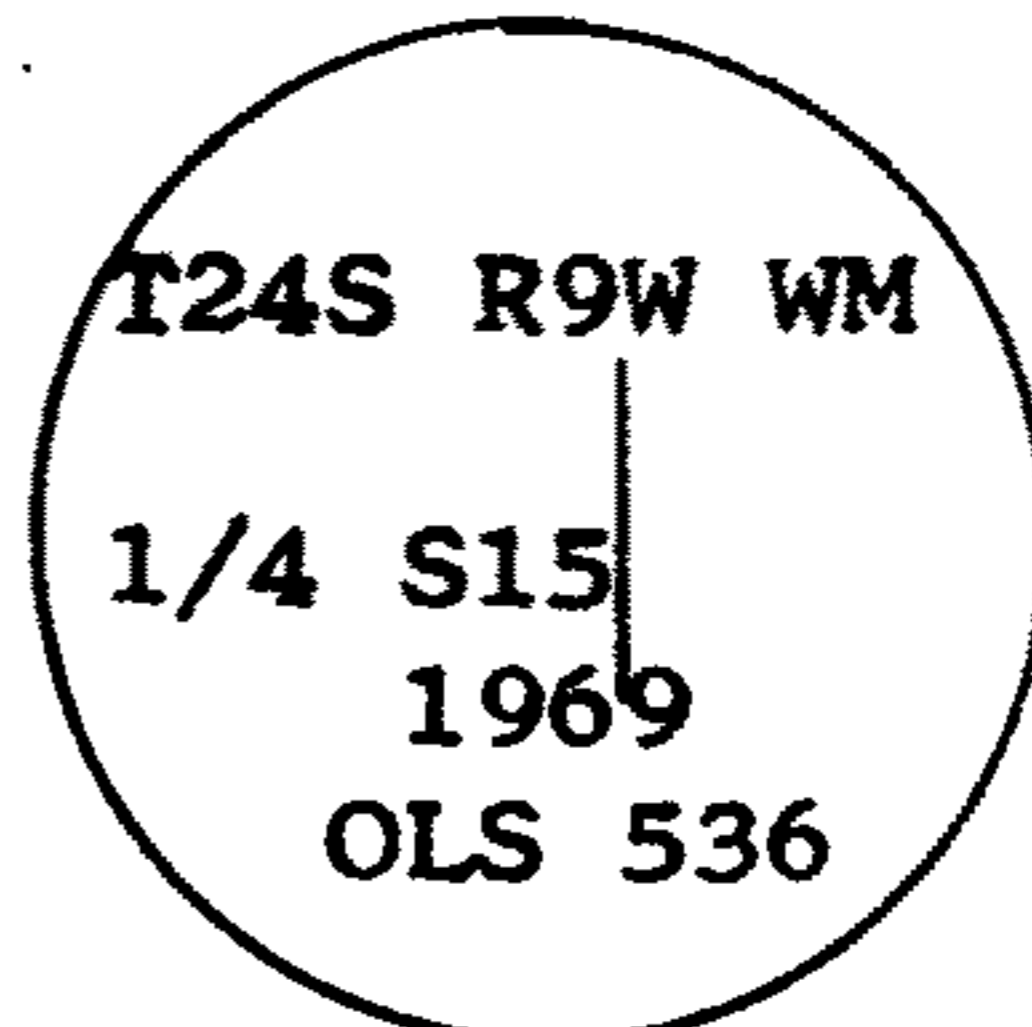

From the iron pipe monument I marked

A 6" Douglas Fir 1/4 S15 BT which bears S 68 1/2° W 64.2 FT.

I set bearing tree tags on the bearing tree facing the monument.

REGISTERED
OREGON
LAND SURVEYOR

Glenn S. Baughman

JULY 14, 1961
GLENN S. BAUGHMAN
536

Office of..... SURVEYOR..... County of..... DOUGLAS.....


State of..... OREGON....., I hereby certify that the within instrument was filed in this office for record on the ...4... day of..... April....., 1960, at 9:30 o'clock a.m., (signed)

Glenn S. Baughman by.....
(COUNTY OFFICIAL) (DEPUTY)

CERTIFIED RECORD OF LAND CORNER MONUMENTATION


History of original corner establishment:

~~As surveyed by W.H. Byars 1878-1879~~
Resurveyed by Levi C. Walker 1905

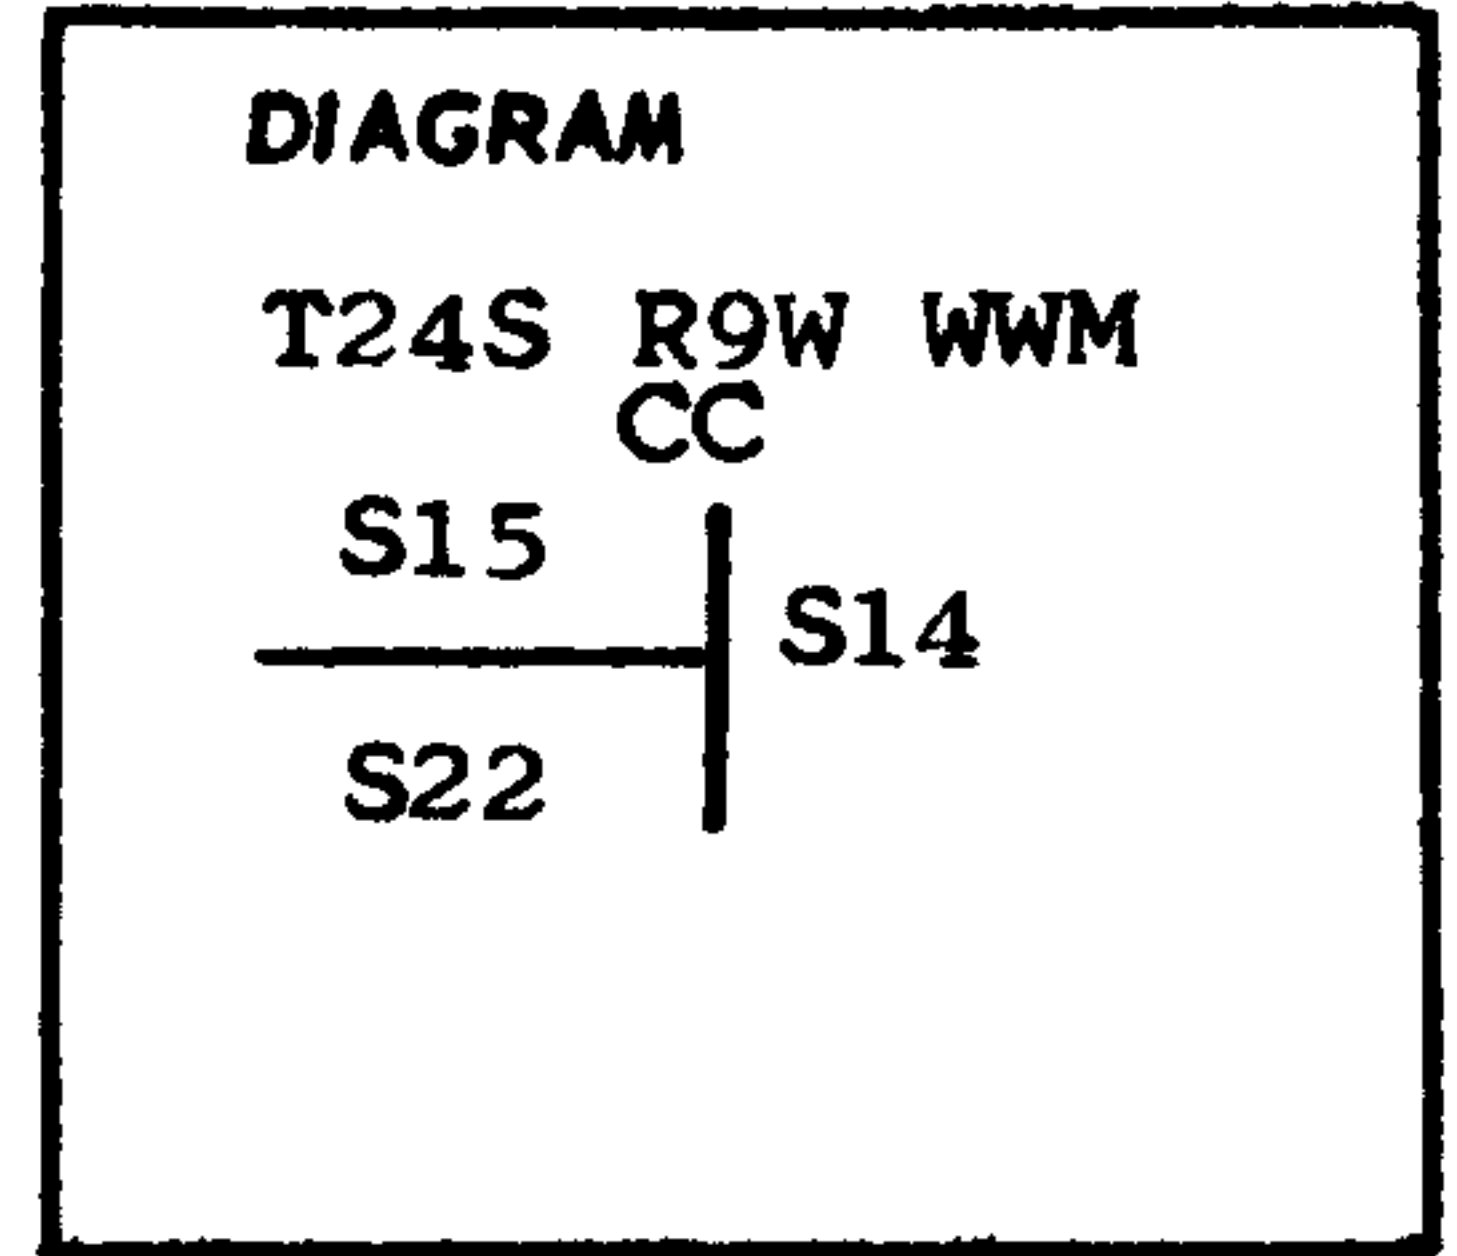


Description of corner evidence found:

None due to new road construction

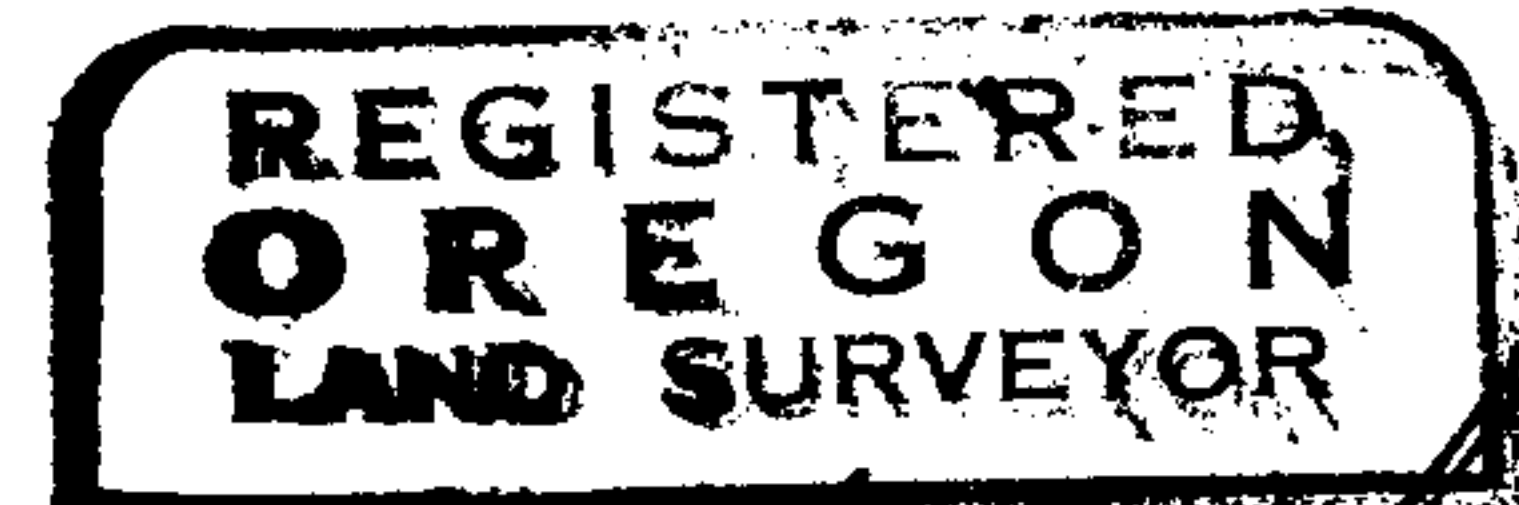


Glenn S. Baughman

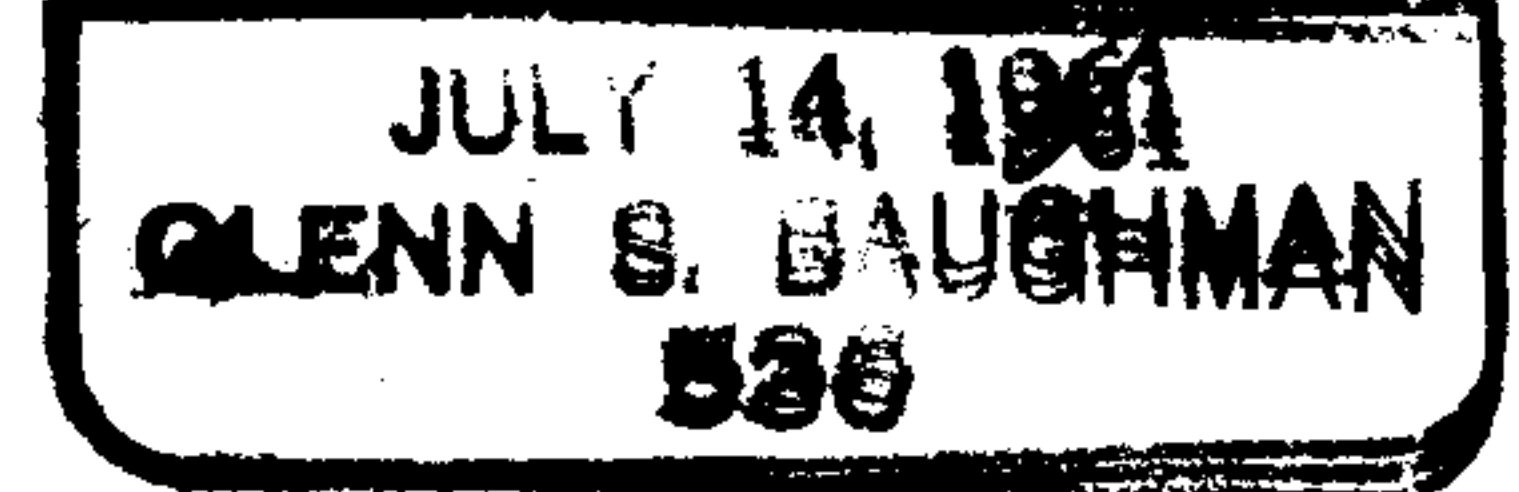

Description of monument and accessories I established to perpetuate the original location of this corner

I set a 1" by 30" galvanized iron pipe with brass cap, 26 ins. in the ground.

I stamped the cap

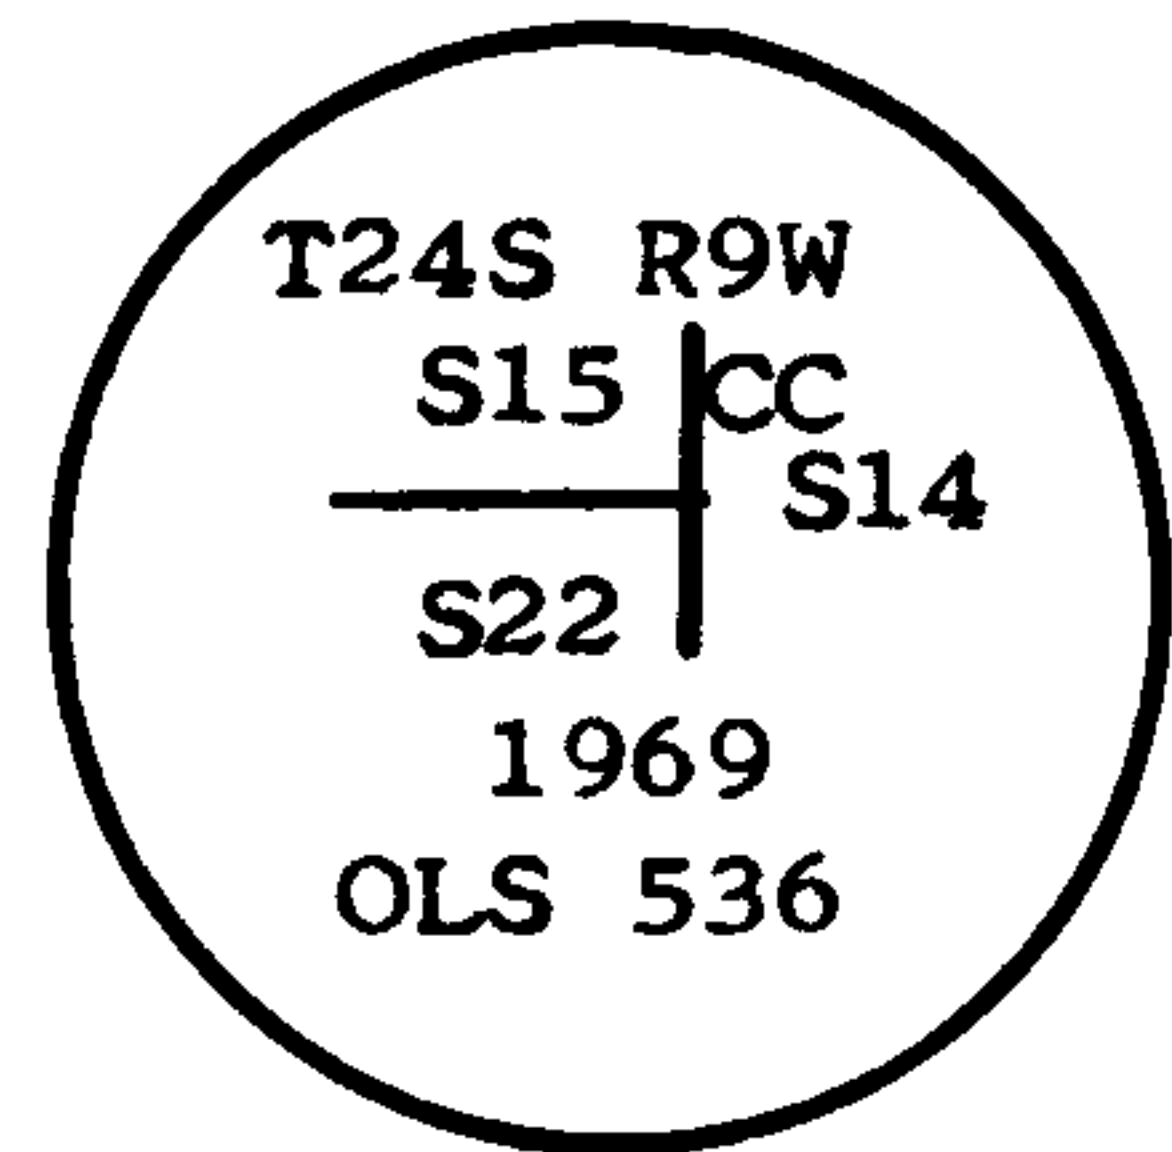

From the iron pipe monument I marked:
 an 11 ins. Douglas fir bears N80 1/2° E 50.5 ft
 Marked T24S R9WS14 BT
 A Maple 5 ins. dia bears S 87 1/2° W 61.6 ft.
 Marked T24S R9W S22 BT
 A Chinquapin 9ins. dia. bears N 27 1/2° W 72.4 ft.
 Marked T24S R9W S15 BT
 I set bearing tree tags on all bearing trees and facing the monument.

Office of SURVEYOR County of DOUGLAS


State of OREGON, I hereby certify that the within instrument was filed in this office for record on the 4 day of April, 1969, at 9:30 o'clock a.m., (signed)

James W. Byars by _____
(COUNTY OFFICIAL) (DEPUTY)

CERTIFIED RECORD OF LAND CORNER MONUMENTATION

History of original corner establishment:

Surveyed by Levi C. Walker 1905

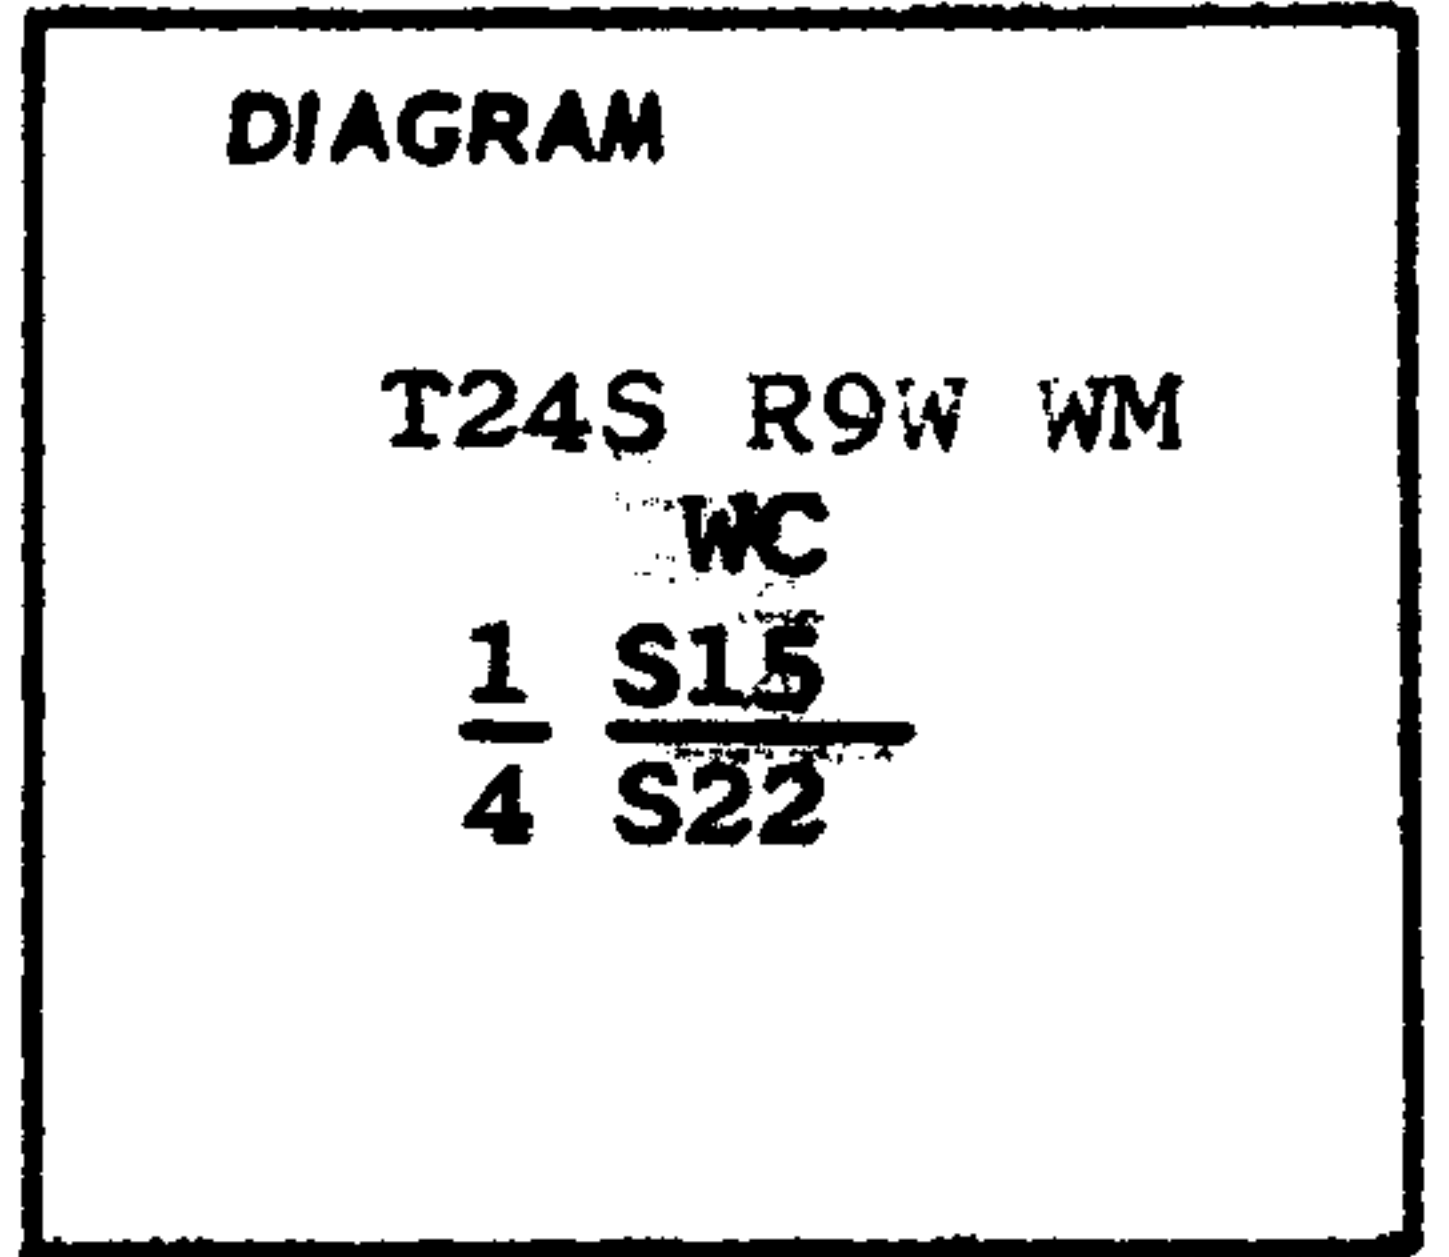

Description of corner evidence found:

I found two stumps with Weyerhaeuser reference tags and nails.
 One is a 36" Douglas Fir stump giving the bearing and distance as
 S 28 1/2° W 90.9 FT.
 One is a 30" Douglas Fir stump giving the bearing and distance as
 N 81° W 70.0 FT.

Description of monument and accessories I established to perpetuate the original location of this corner


I was unable to set 1/4 corner due to the point falling on the vertical face of a rock quarry.
 I set a 1" by 30" galvanized iron pipe with brass cap 10" in the ground and then constructed a rock mound 16" by 48" around pipe.
 From this monument the true corner bears S.89°24'36"E. 125.99 ft.

REGISTERED
 OREGON
 LAND SURVEYOR

Glenn S. Baughman

JULY 14, 1969
 GLENN S. BAUGHMAN
 536

I stamped the cap

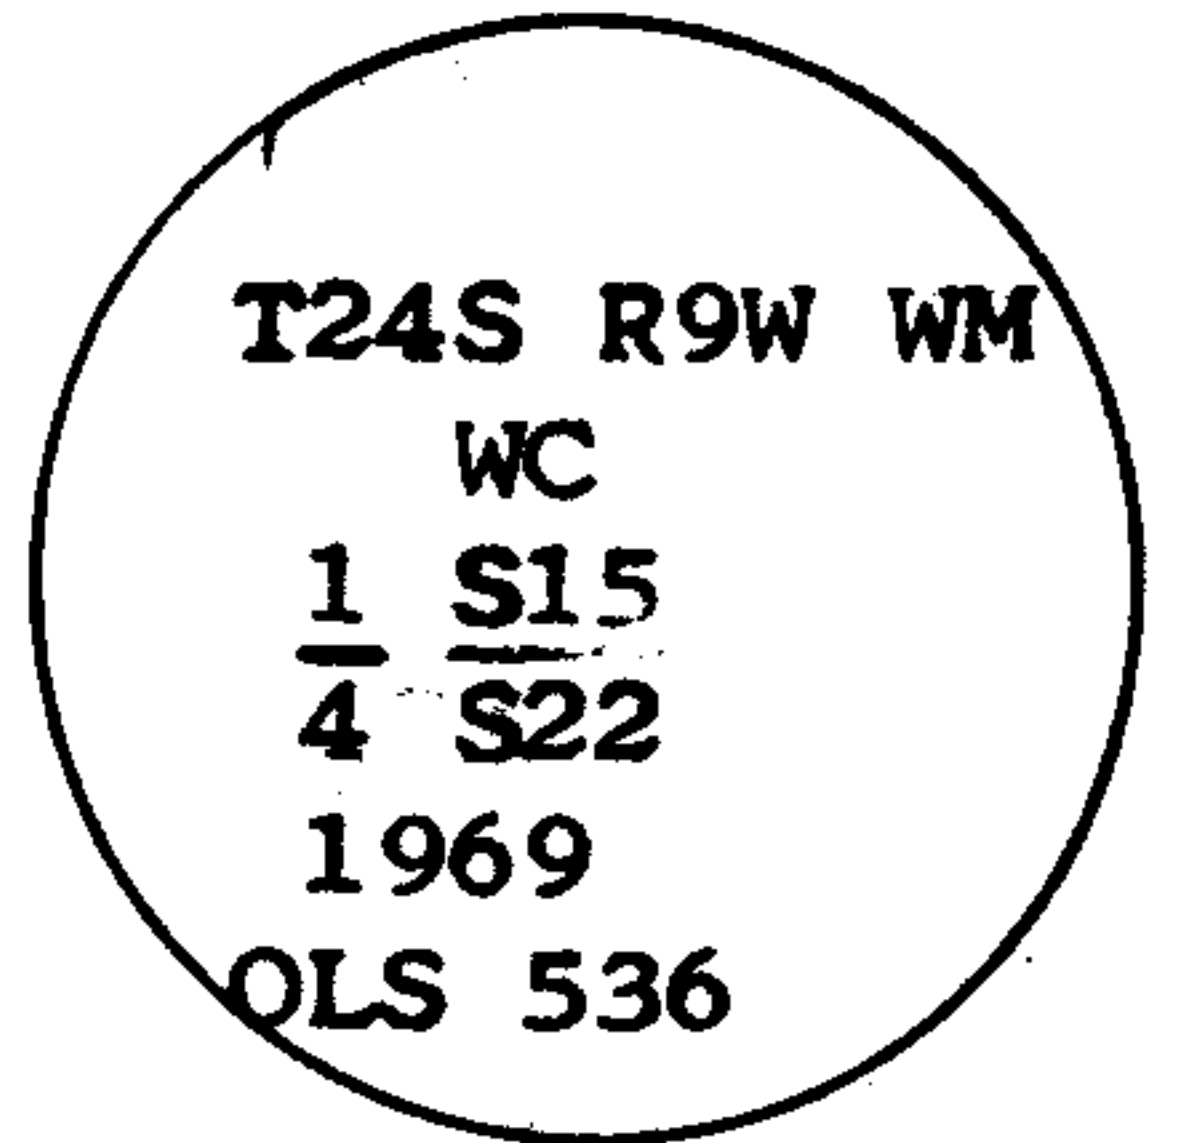


From the iron pipe monument I marked
 A 4" Alder X & BT which bears N 7° W 55.9 FT.
 I also set a 5/8" by 30" iron rod 26" in the ground which bears S45°W 107.0 FT.

Office of.....SURVEYOR..... County of.....DOUGLAS.....
 State of.....OREGON....., I hereby certify that the within instrument was filed in this office
 for record on the 4 day of April, 1969, at 9:30 o'clock a.m., (signed)
James W. Ryan by (DEPUTY)
 (COUNTY OFFICIAL)

CORNER ESTABLISHMENT CERTIFICATION

I Henry R. Reppeto do hereby certify that the original corner (see diagram) was referenced under my direction. The corner that was re-established by Baughman and Ackaret occupies the same point as nearly as possible.

DIAGRAM T.24S., R.9W.W.M.

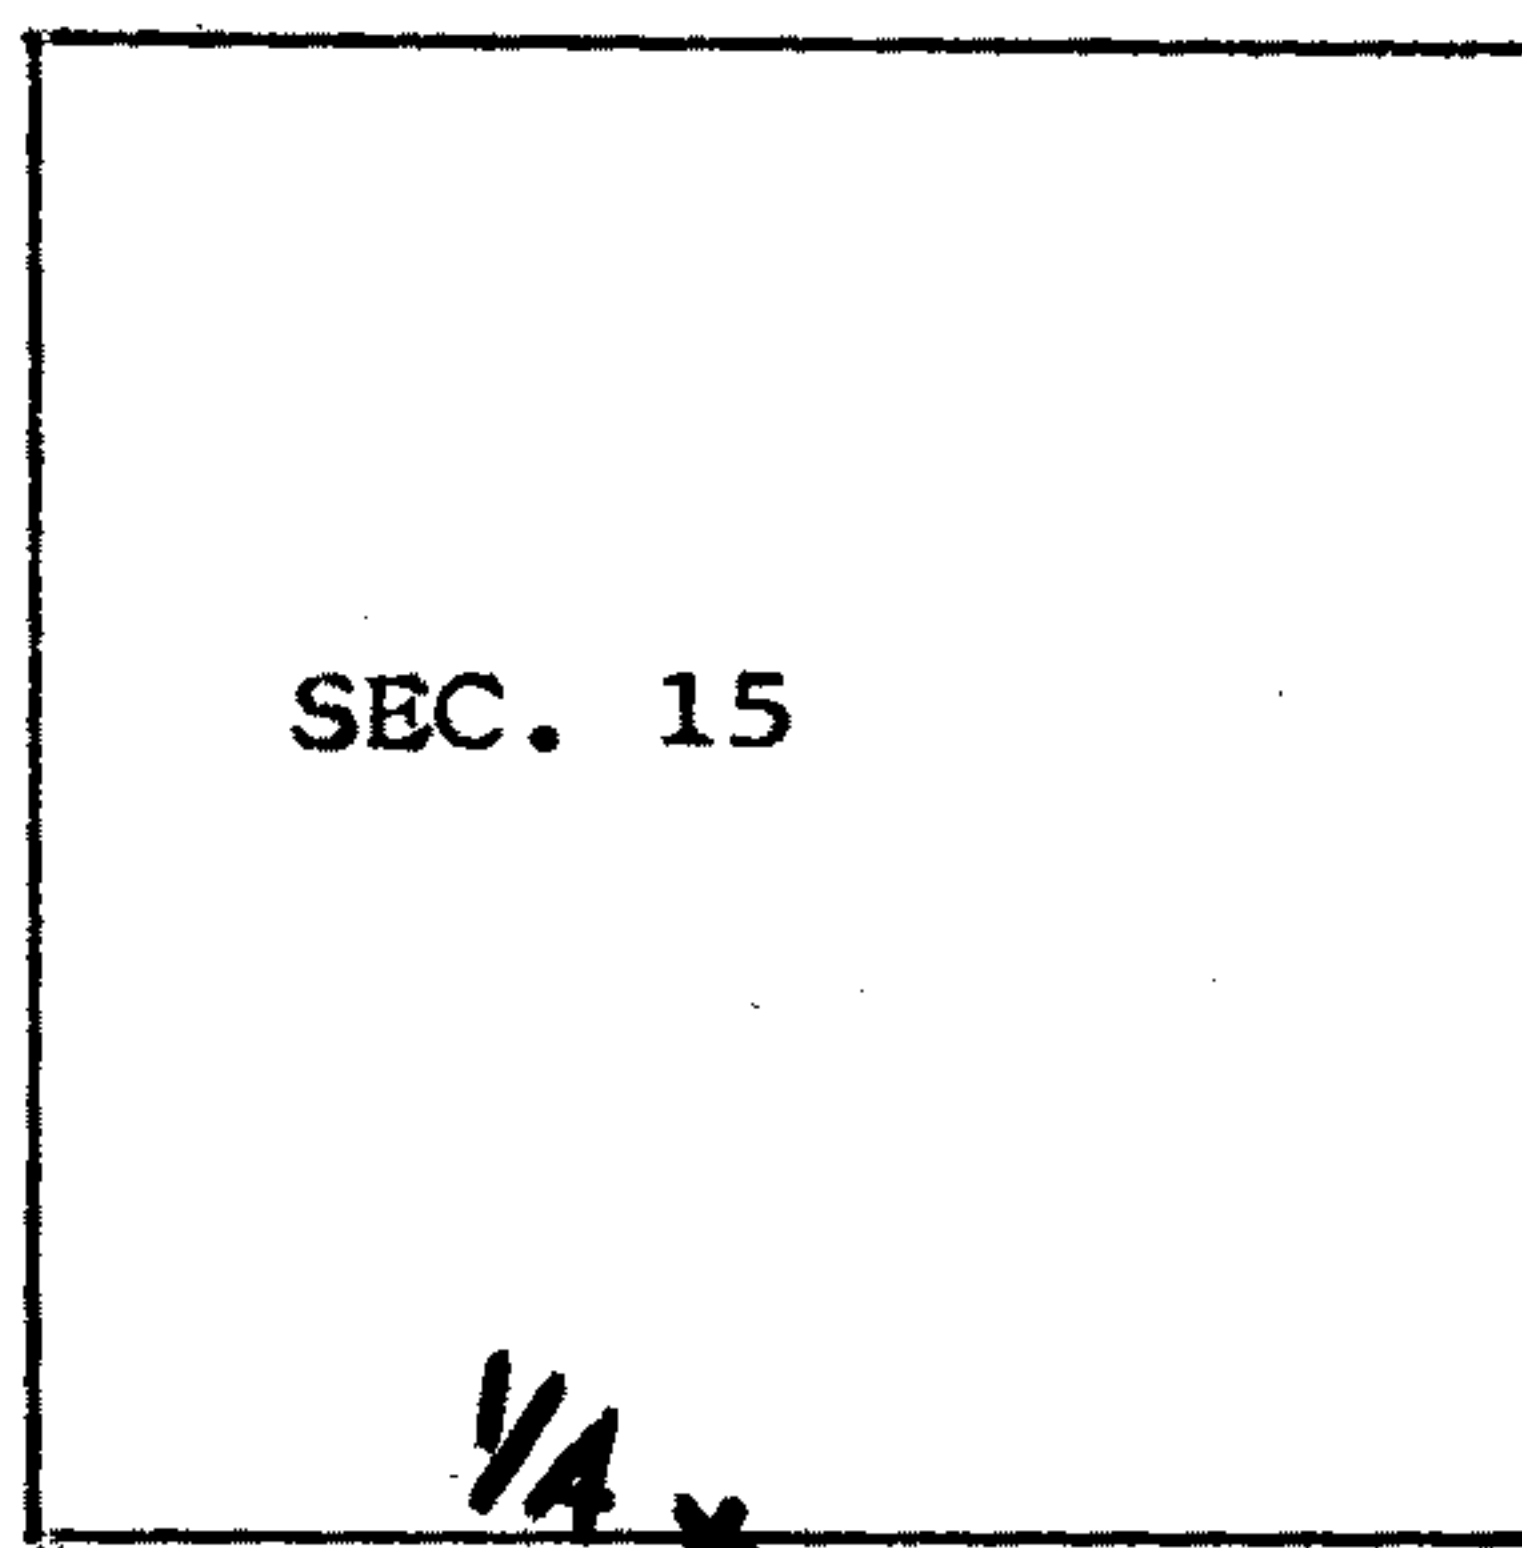

H. R. Reppeto
Registered Land Surveyor No. 618

4-15-69

FILED *LL*
RECEIVED

APR 18 1969

COUNTY SURVEYOR
DOUGLAS COUNTY, ORE.