

COUNTY SURVEYORS FILE DATA  
DO NOT REMOVE FROM OFFICE

# CORNER REPLACEMENT



IN A PORTION OF  
BLOCK 2, FAIRACRES SUBD.  
IN

SEC. 36, T.26S., R.6W., W.M.

⊙ Corner Found

○ 5/8" Iron Rod Set

April 1969 Scale: 1"=100'

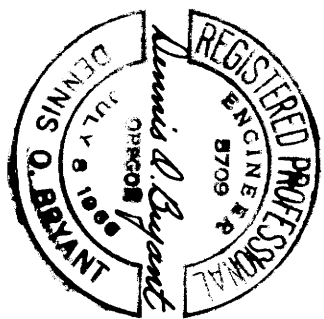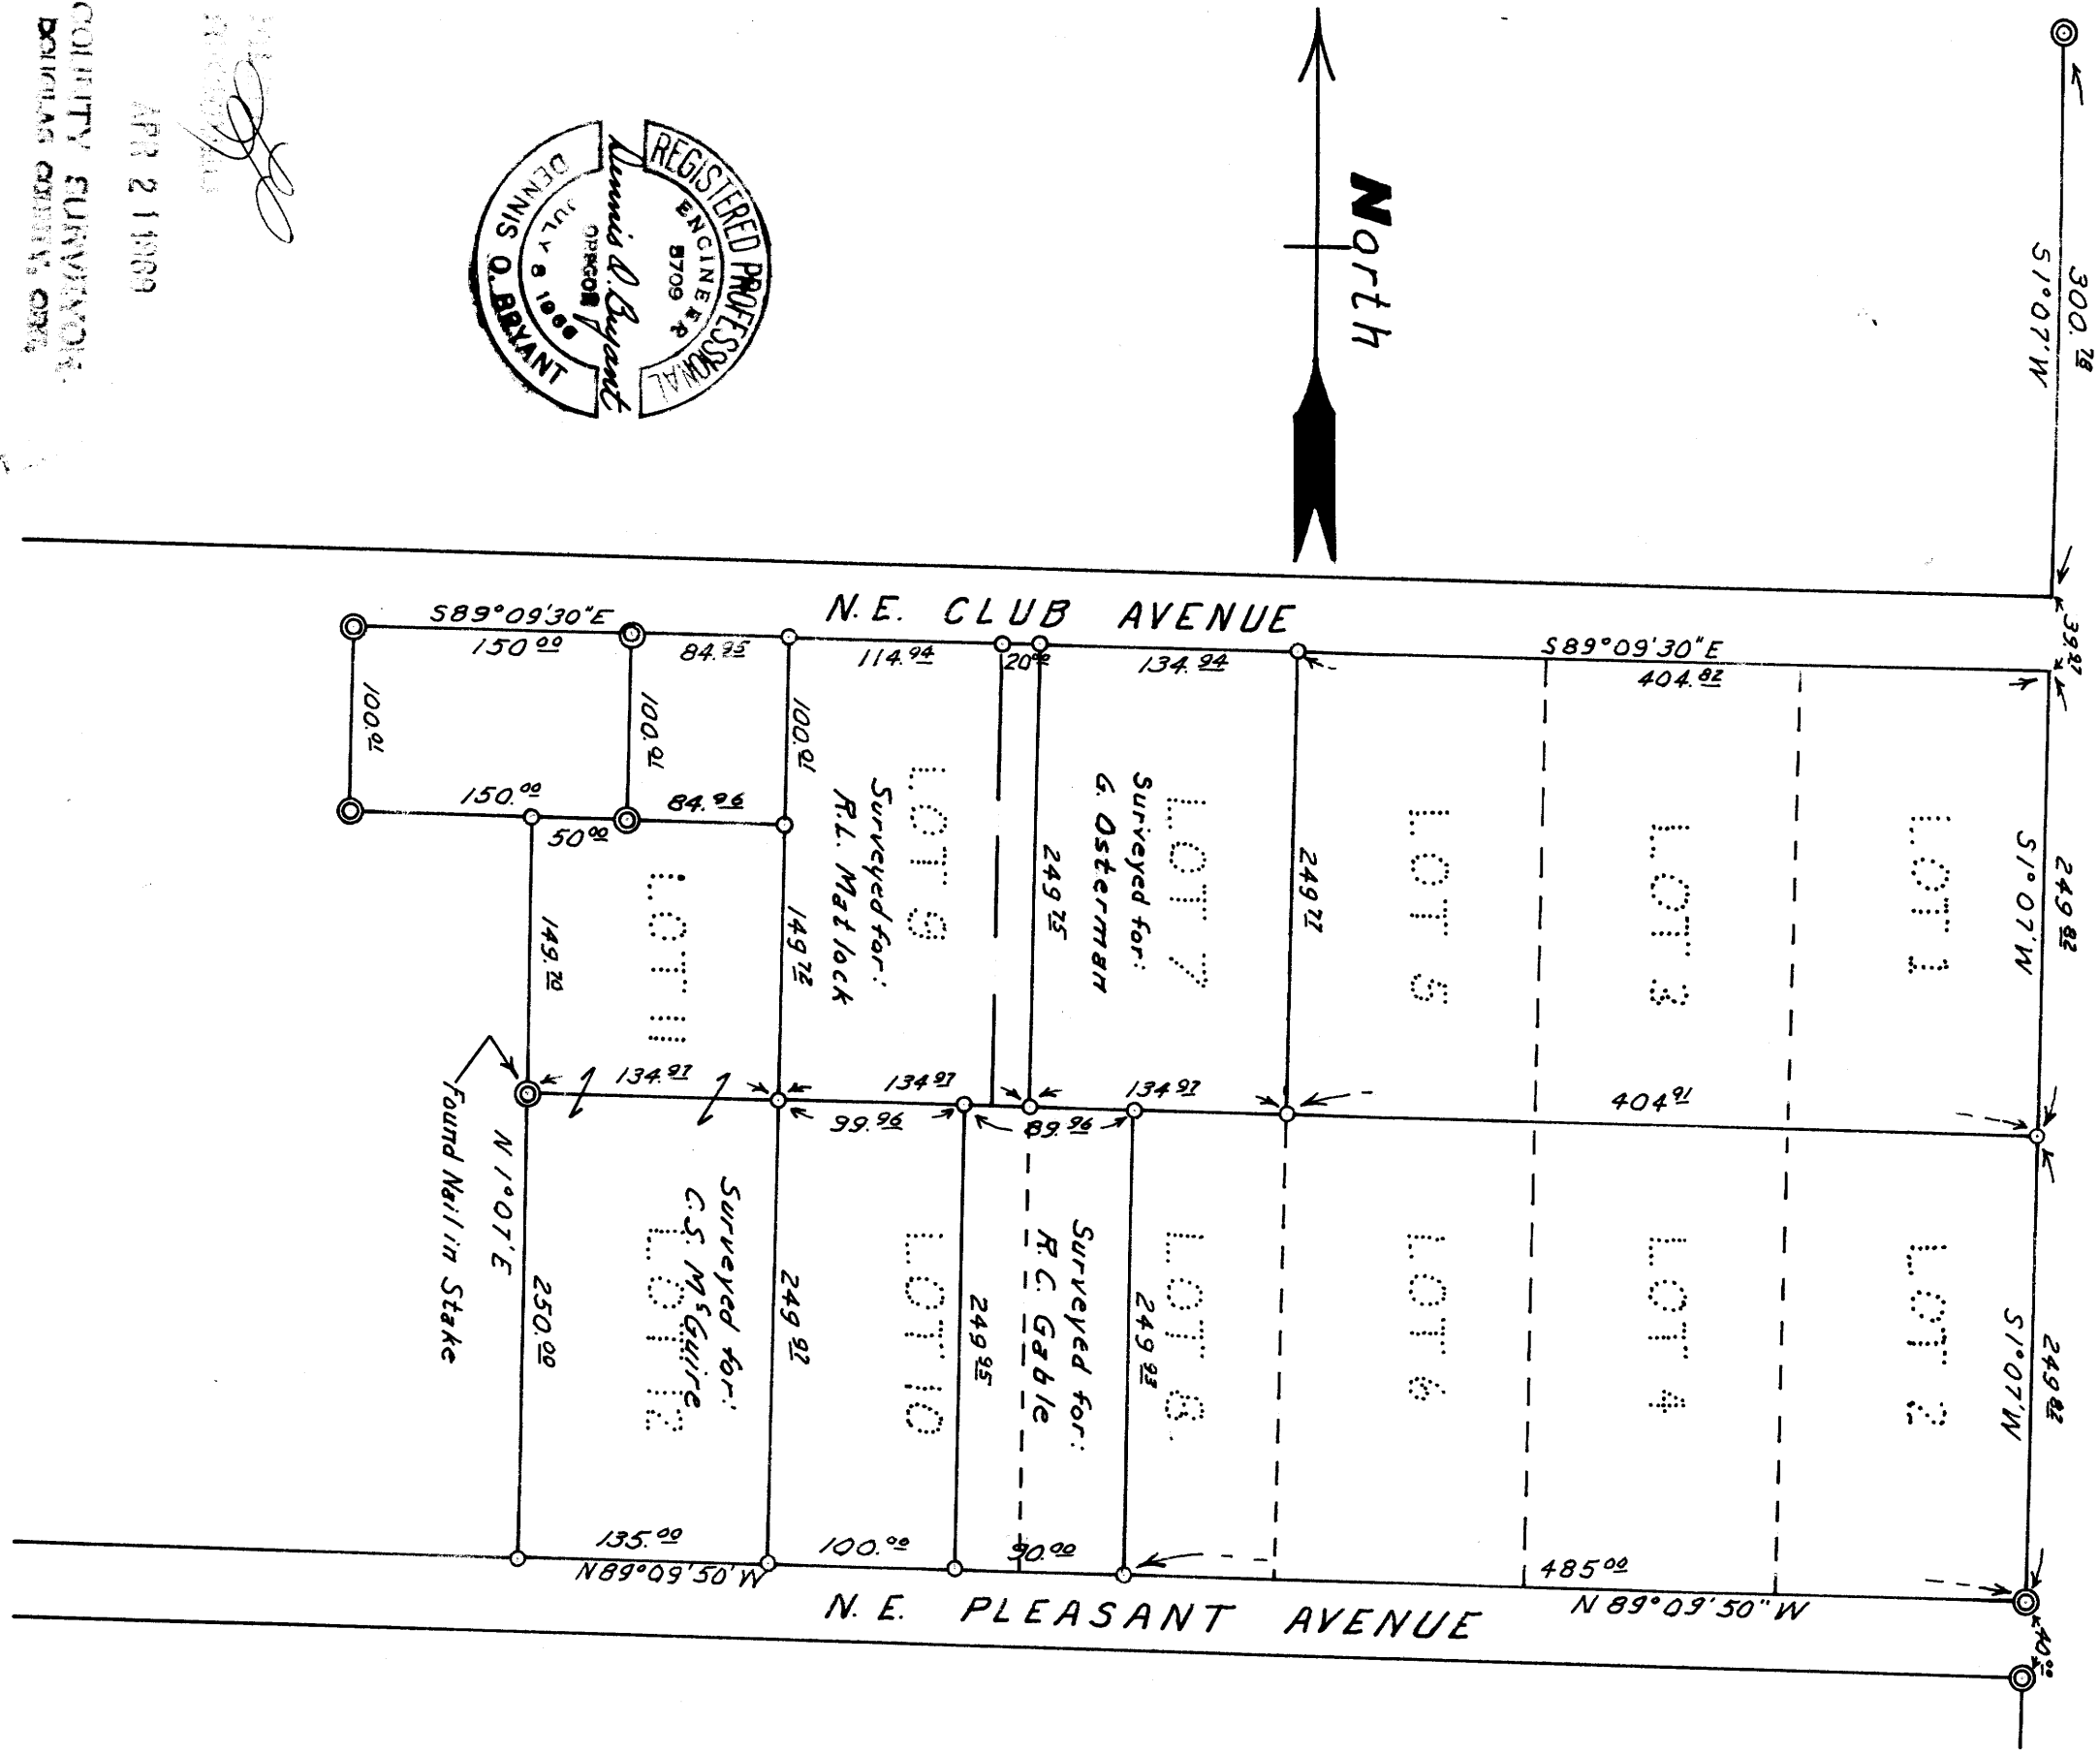

*[Handwritten Signature]*

APR 21 1969

COUNTY SURVEYORS  
BRIDGES COUNTY, CALIF.