

MINOR LAND PARTITION


IN

LOT 4, DIXON'S ADDITION TO FRUITVALE

Section 12, T.27S., R.6W., W.M.

December 1968

Scale: 1" = 20'

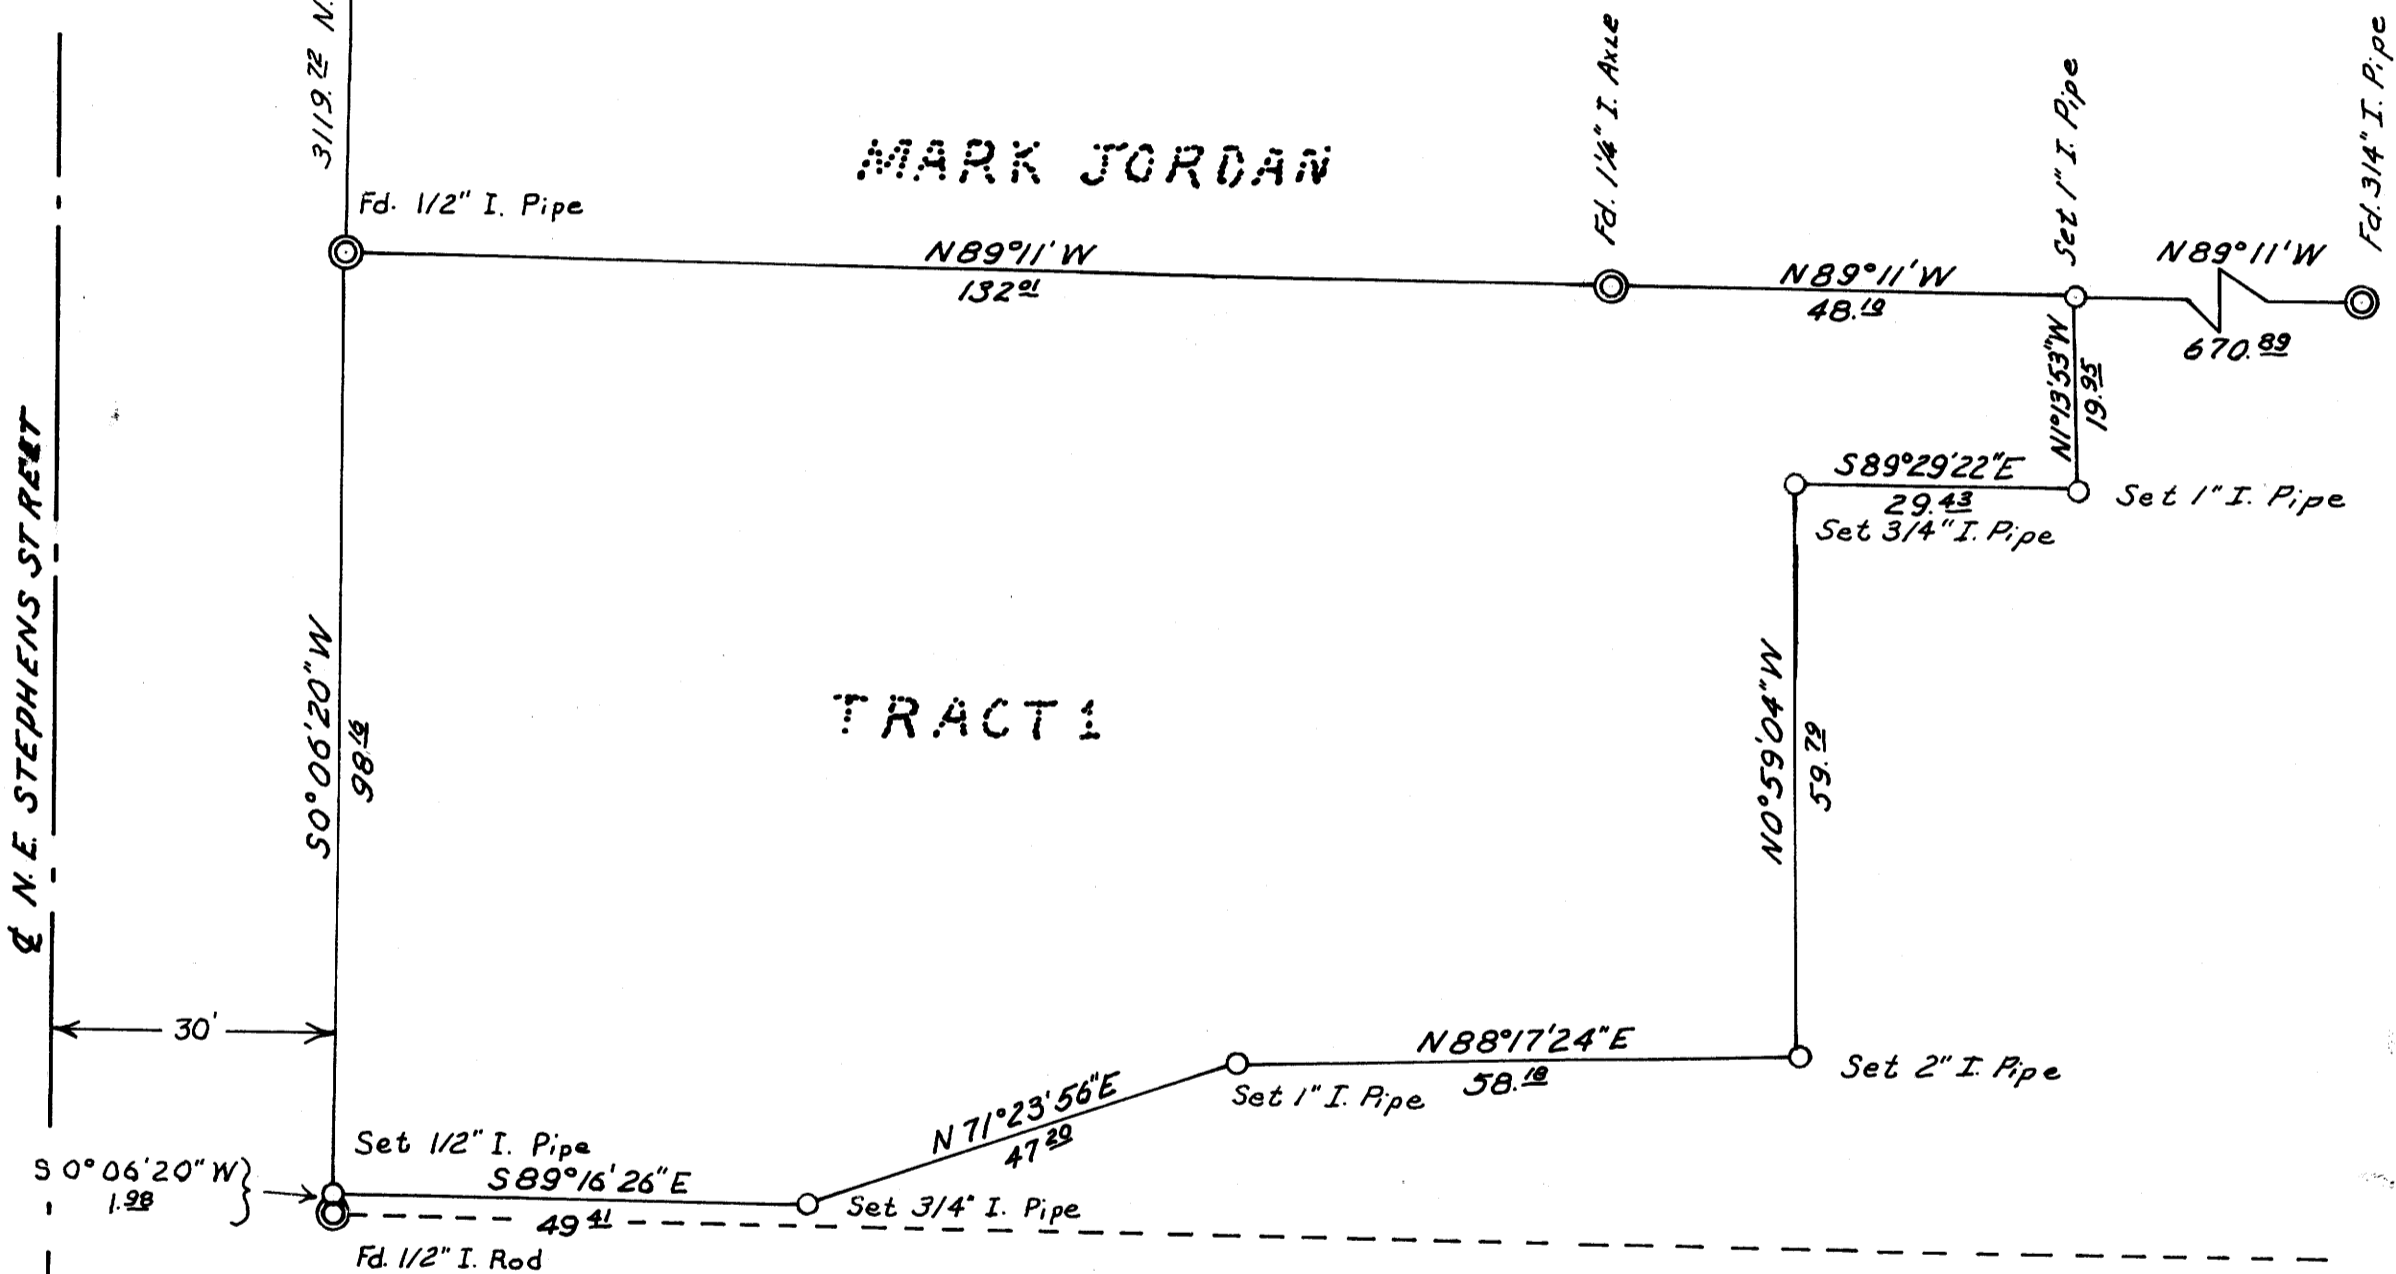

The above partition in Tract 1 of Lot 4 contains 13,915 sq. ft. or 0.32 Acres.



NOTE: Bearings based on North Line Tract 1 per C.S. File 39-37

Surveyed For Mr. & Mrs. R. B. Delfs

Surveyed By Dennis O. Bryant
R.P.E. 5709
Winchester, Oregon.