


COUNTY SURVEYORS FILE DATA
DO NOT REMOVE FROM OFFICE

FILED *LL*
RECEIVED

JUN 24 1969

COUNTY SURVEYOR
DOUGLAS COUNTY, ORE.

SURVEY TO DETERMINE PROPERTY LINE IN SEC'S. 9 AND 10, T. 27 S., R. 6 W., W.M.
SURVEYED FOR BENJAMIN F. JONES
SURVEYED BY R. H. GEE - JUNE, 1969 - SCALE 1" = 100'

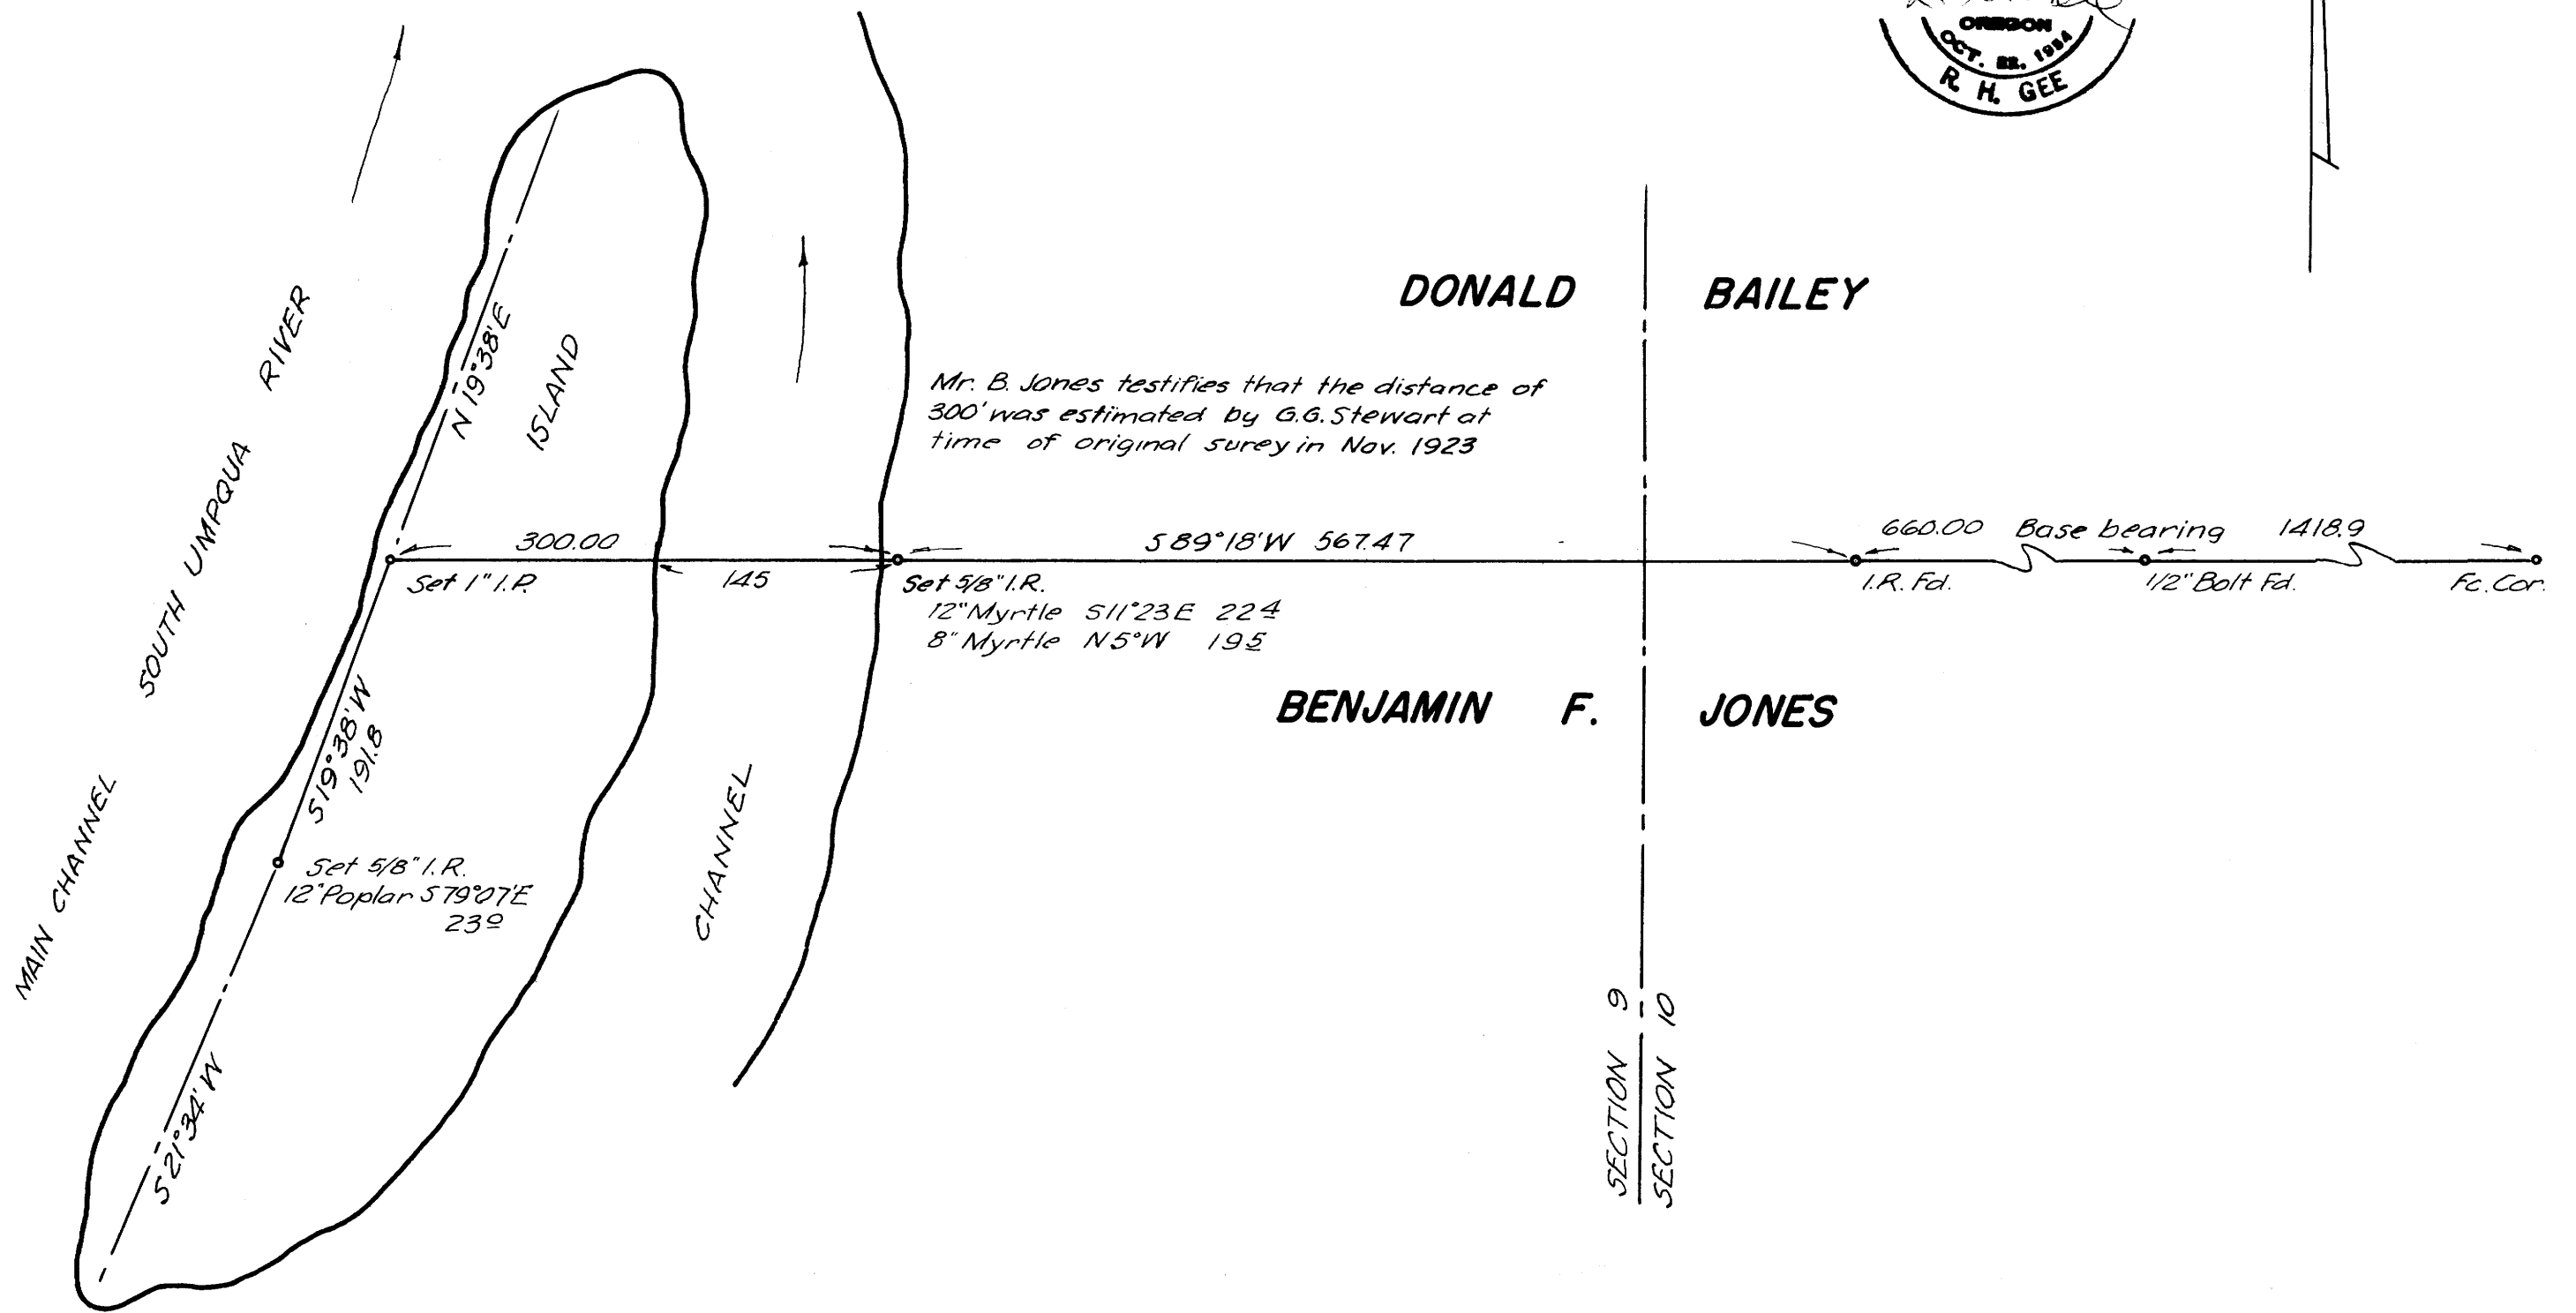

P MAP FILE M.387-12