

SURVEYED FOR DEED DESCRIPTION

IN SECTION'S ^{4/24/73} 19 & 24 ^{4/24/73} TWP. 28S., RG'S 5 & 6 W.W.M.

SURVEYED FOR IRA WILSON

BY BAUGHMAN & ACKARET INC.

SCALE 1" = 100'


MAY 1969

- SET 5/8" IRON ROD
- FOUND BRASS CAP COUNTY SURVEYOR STAMPED 1954

REGISTERED
OREGON
LAND SURVEYOR

Glenn S. Baughman

JULY 14, 1961
GLENN S. BAUGHMAN
536

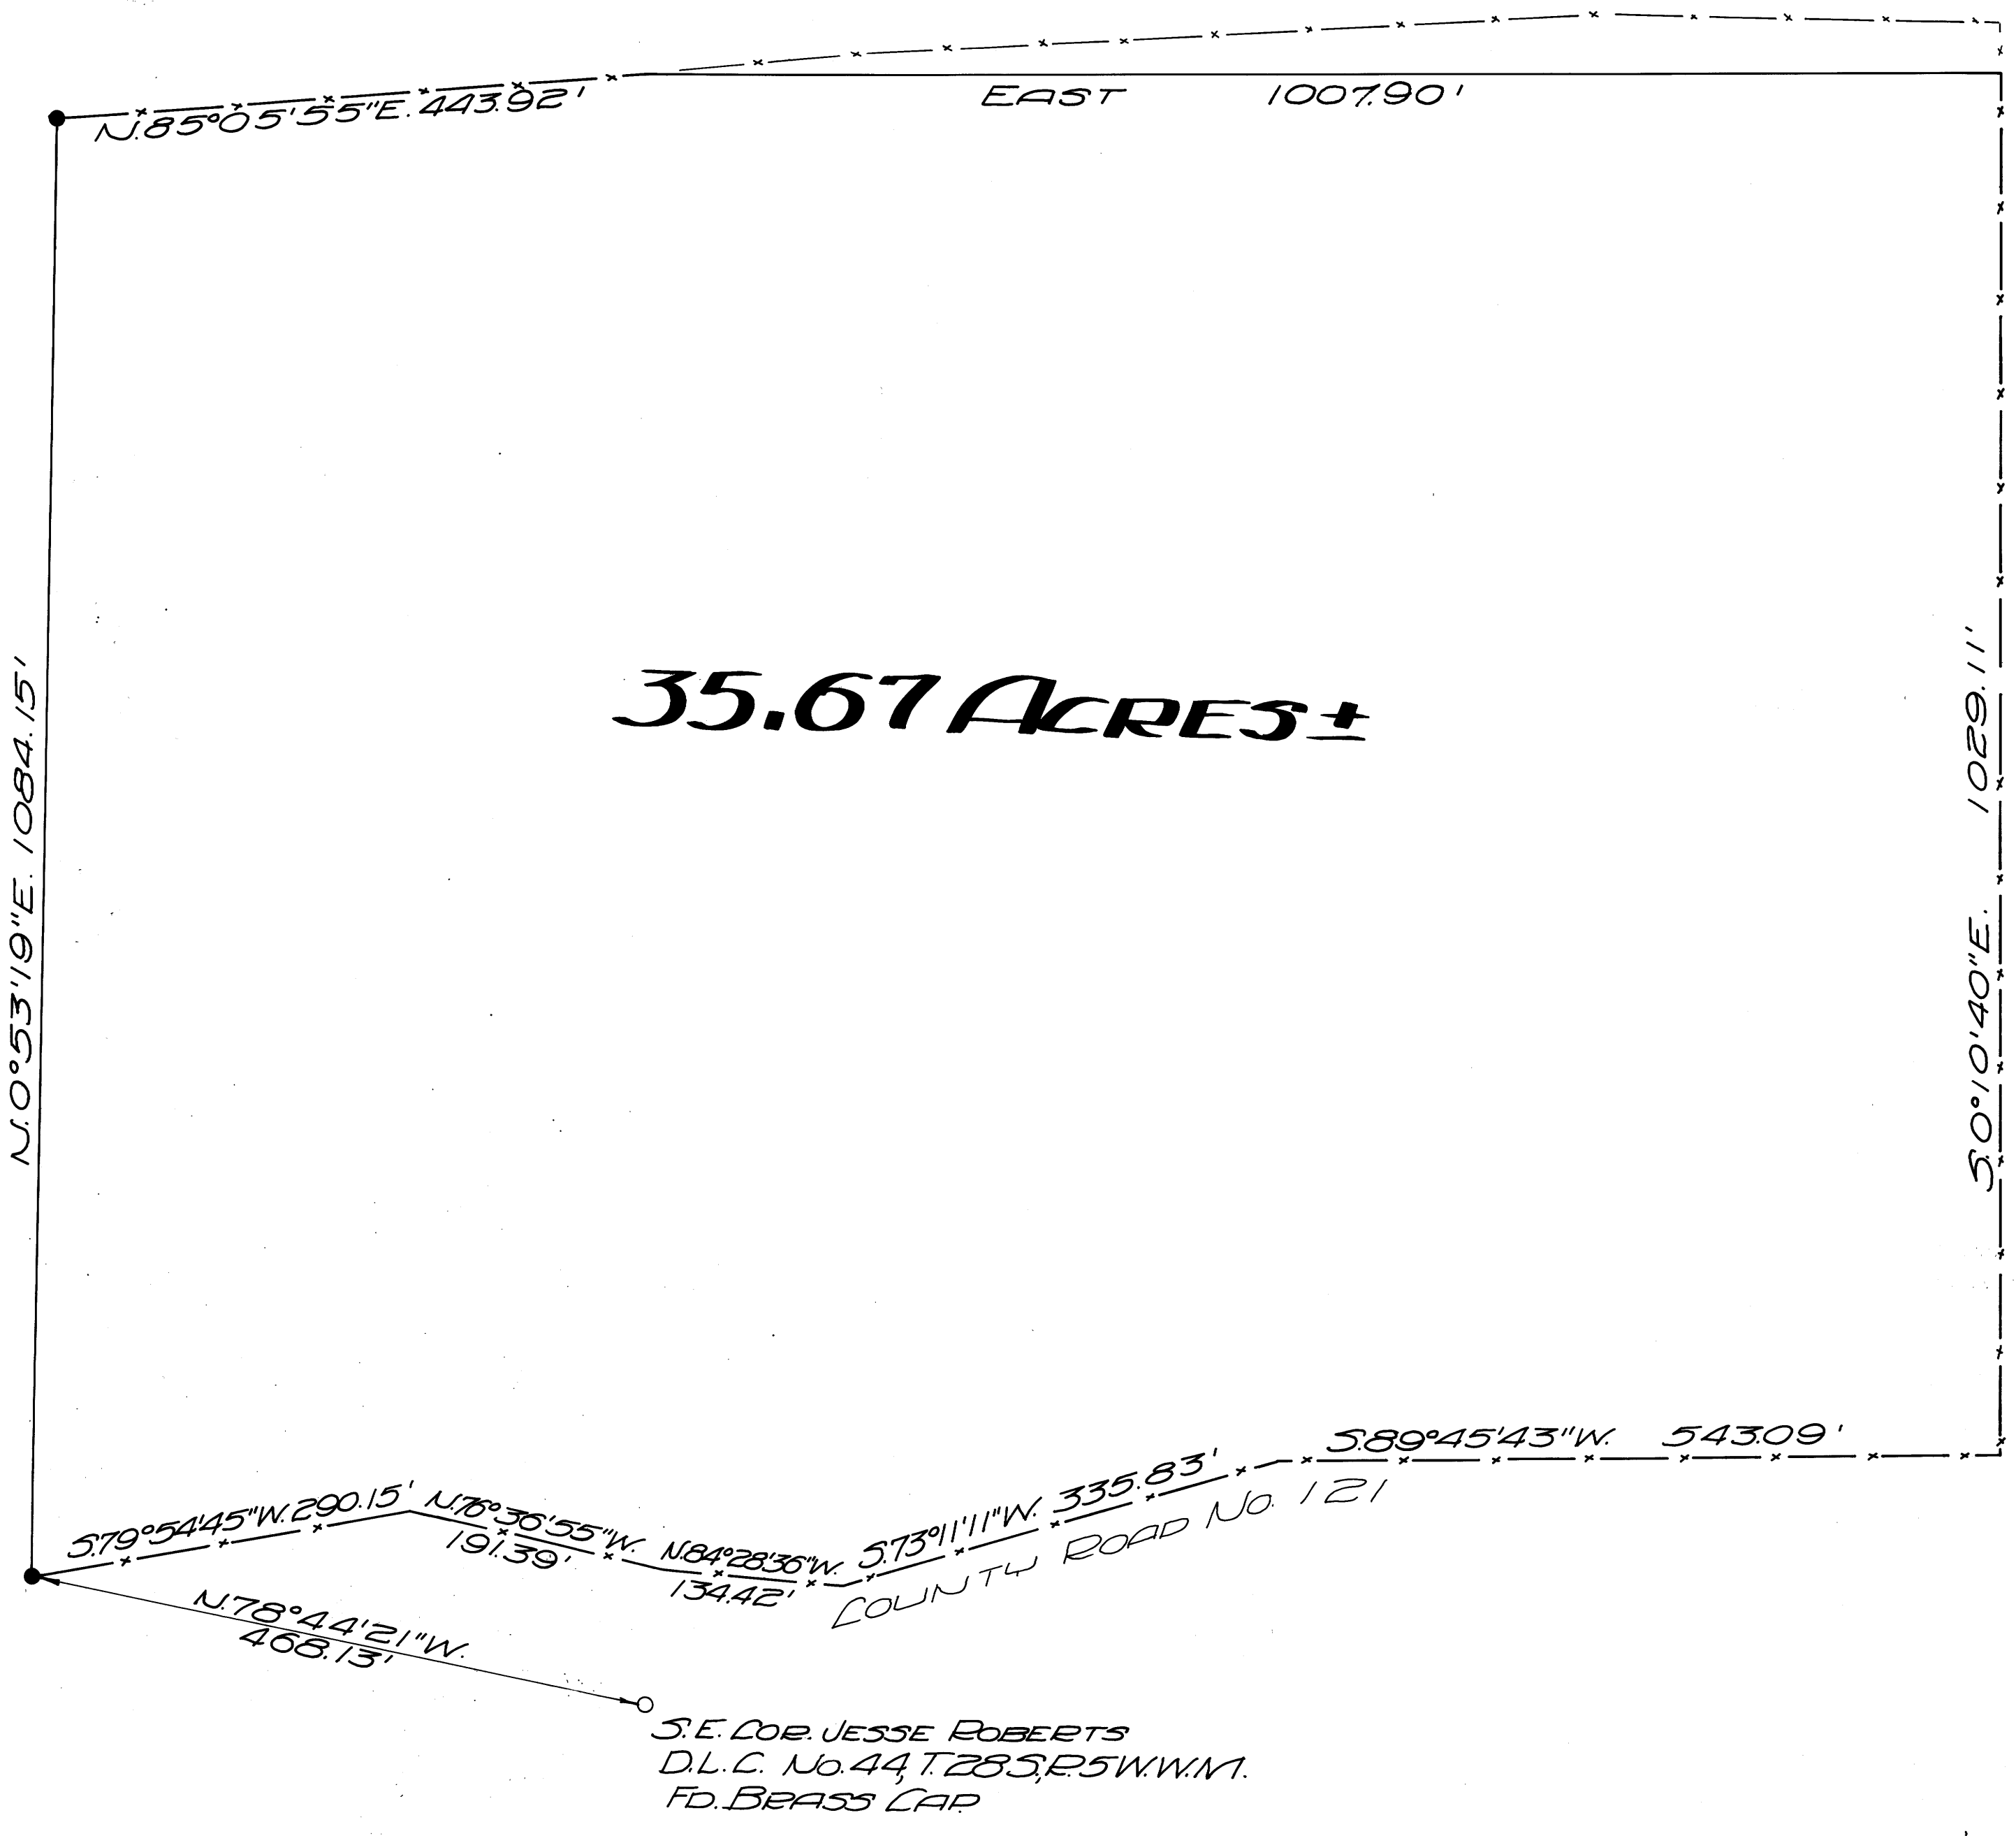

BASE BEARINGS SOLAR OBSERVATION