

# SEC. COR. RESTORATION & SUBDIVISION OF SECTION 19, T.32S. R.2W. W.M.

SURVEYED FOR THE UMPQUA NATIONAL FOREST  
TILLER RANGER DISTRICT CONTRACT No. 002473  
BY BAUGHMAN & ACKARET INC. JULY 1969

SCALE: 1"=400

COUNTY SURVEYORS FILE DATA  
DO NOT REMOVE FROM OFFICE

REGISTERED  
OREGON  
LAND SURVEYOR

*Allen S. Baughman*  
JULY 14, 1969  
ALLEN S. BAUGHMAN,  
536


⊙ DENOTES SET BRASS CAP  
⊙ DENOTES FOUND AS SHOWN  
NOTE: TAGS PLACED ON ALL B. T.S.

FILED  
RECEIVED

JUL 29 1969

COUNTY SURVEYOR  
DOUGLAS COUNTY, ORE.

BASE BEARINGS SOLAR OBSERVATION

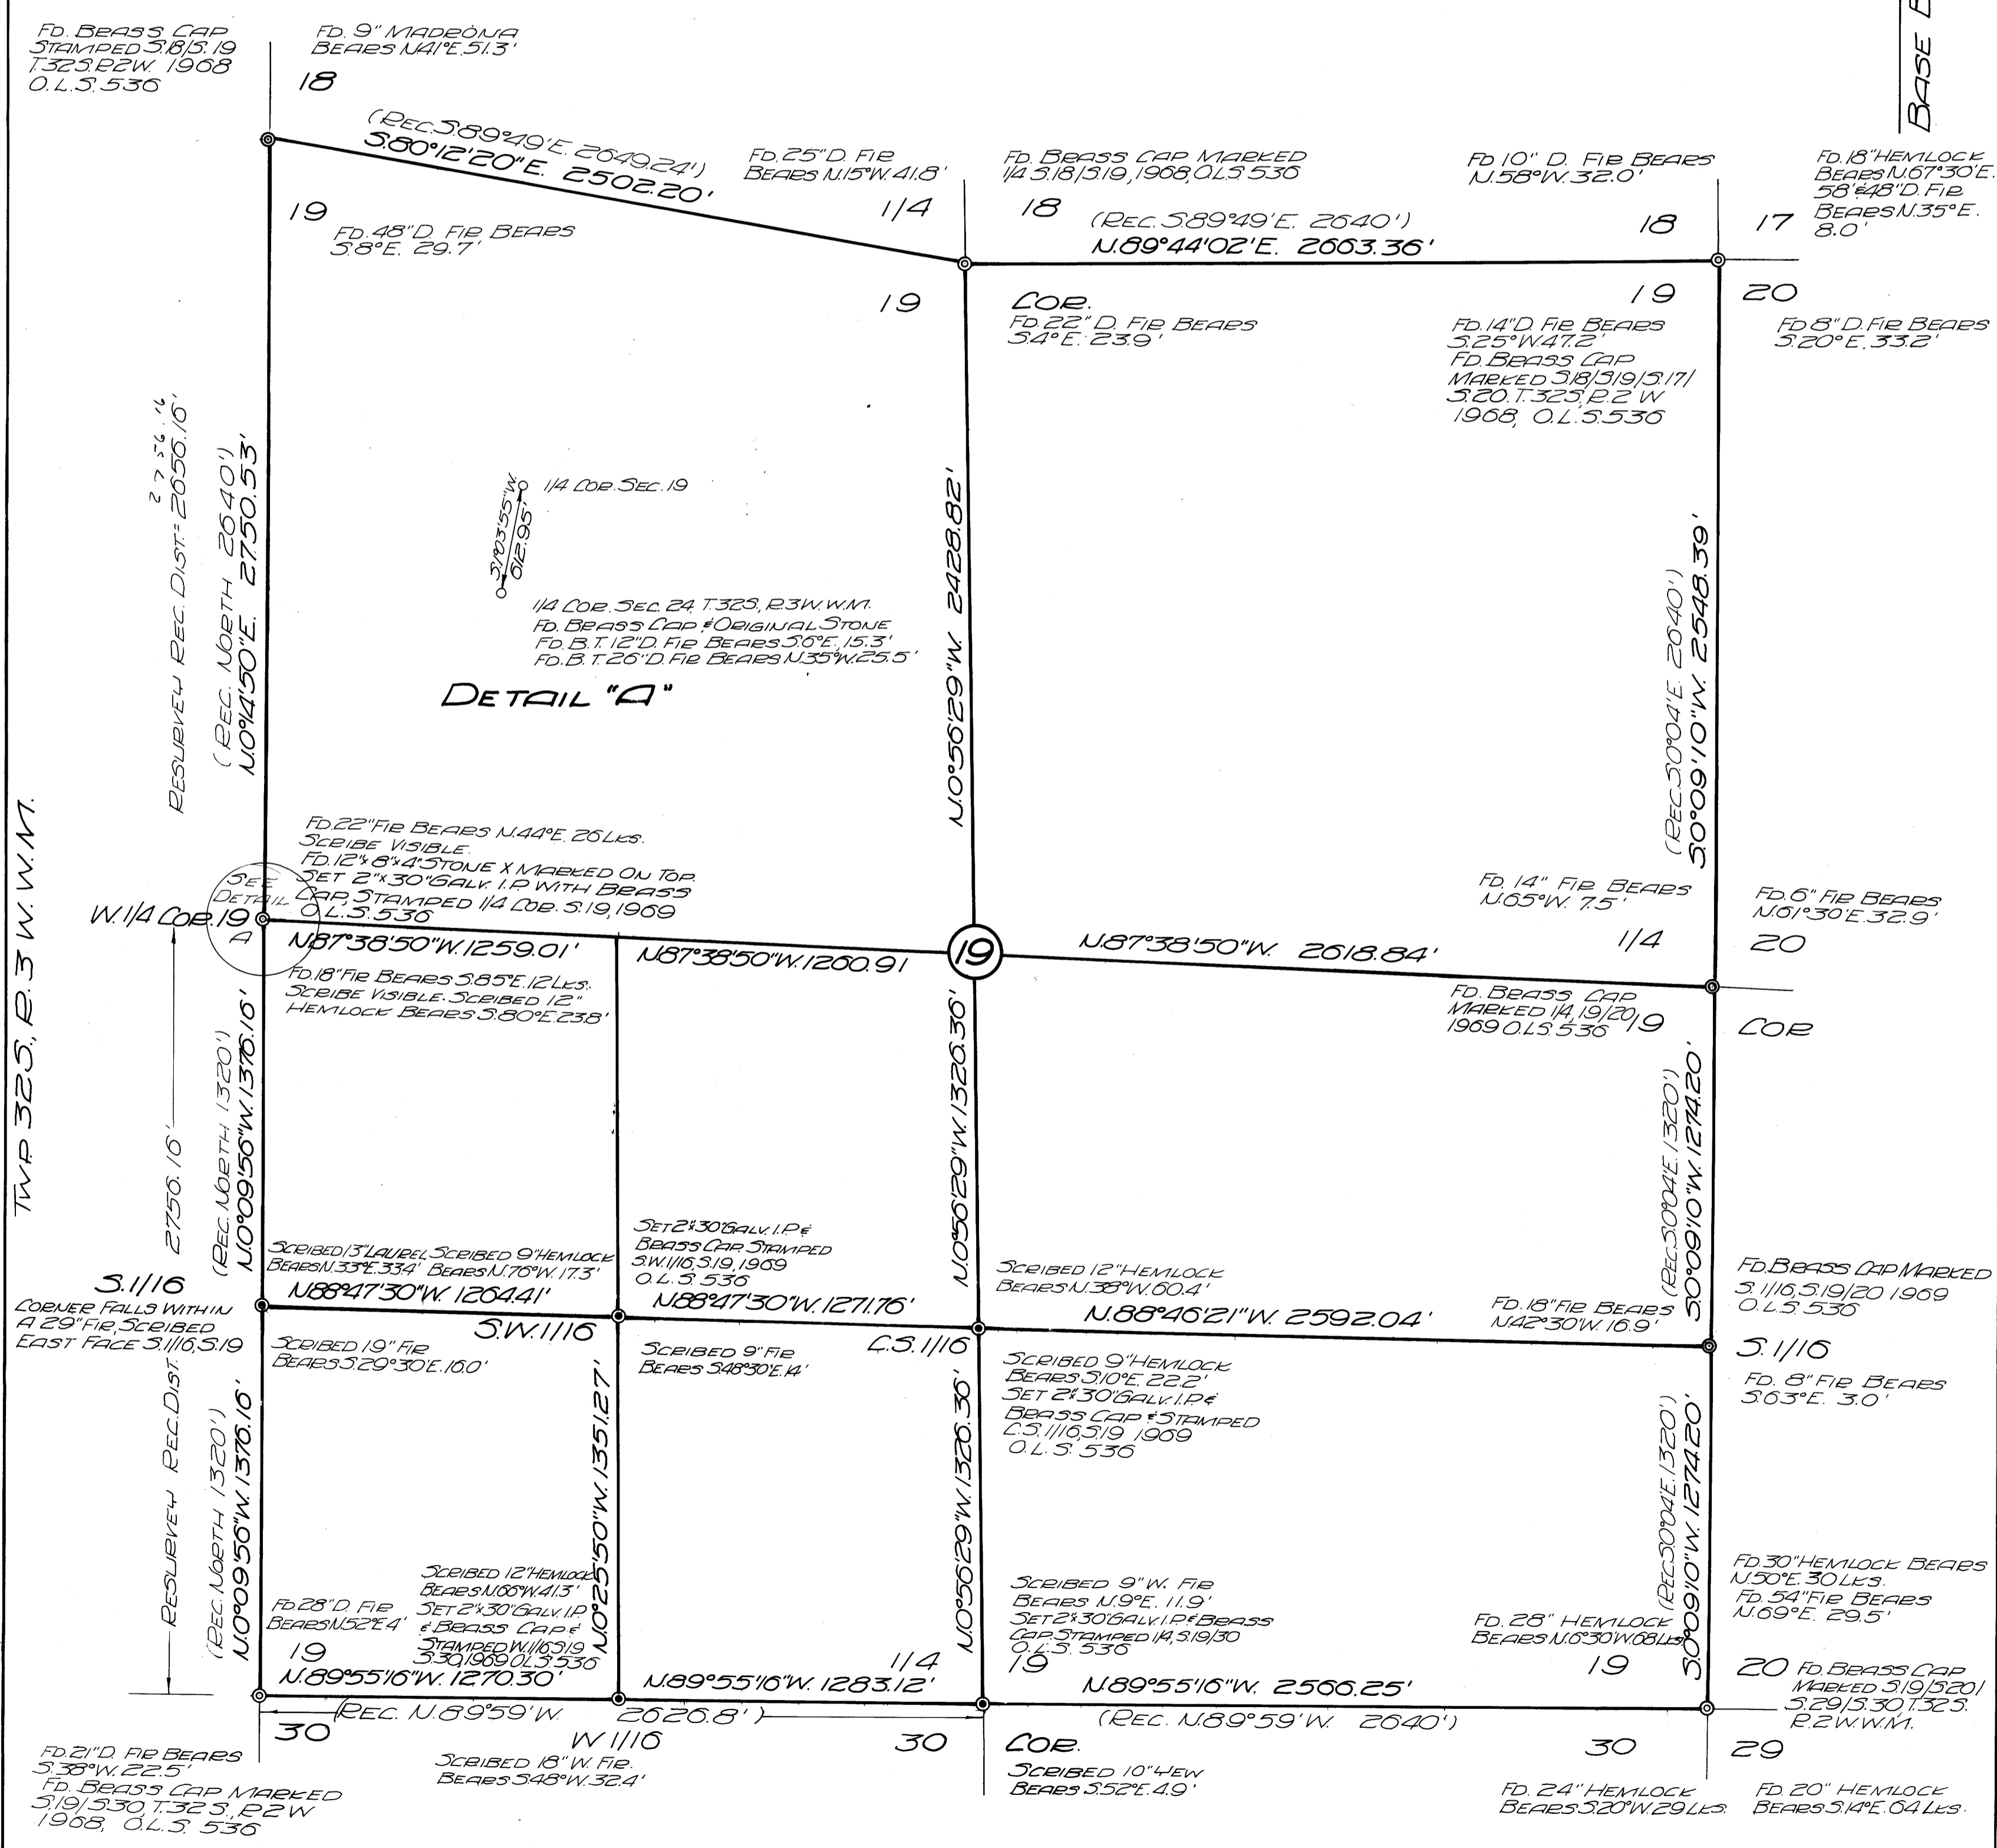

TWP. 32S. R. 2W. W.M.